


Application No. R-76985
Permit No.

RECEIVED

DEC 29 1994
WATER RESOURCES DEPT.
SALEM, OREGON

1600

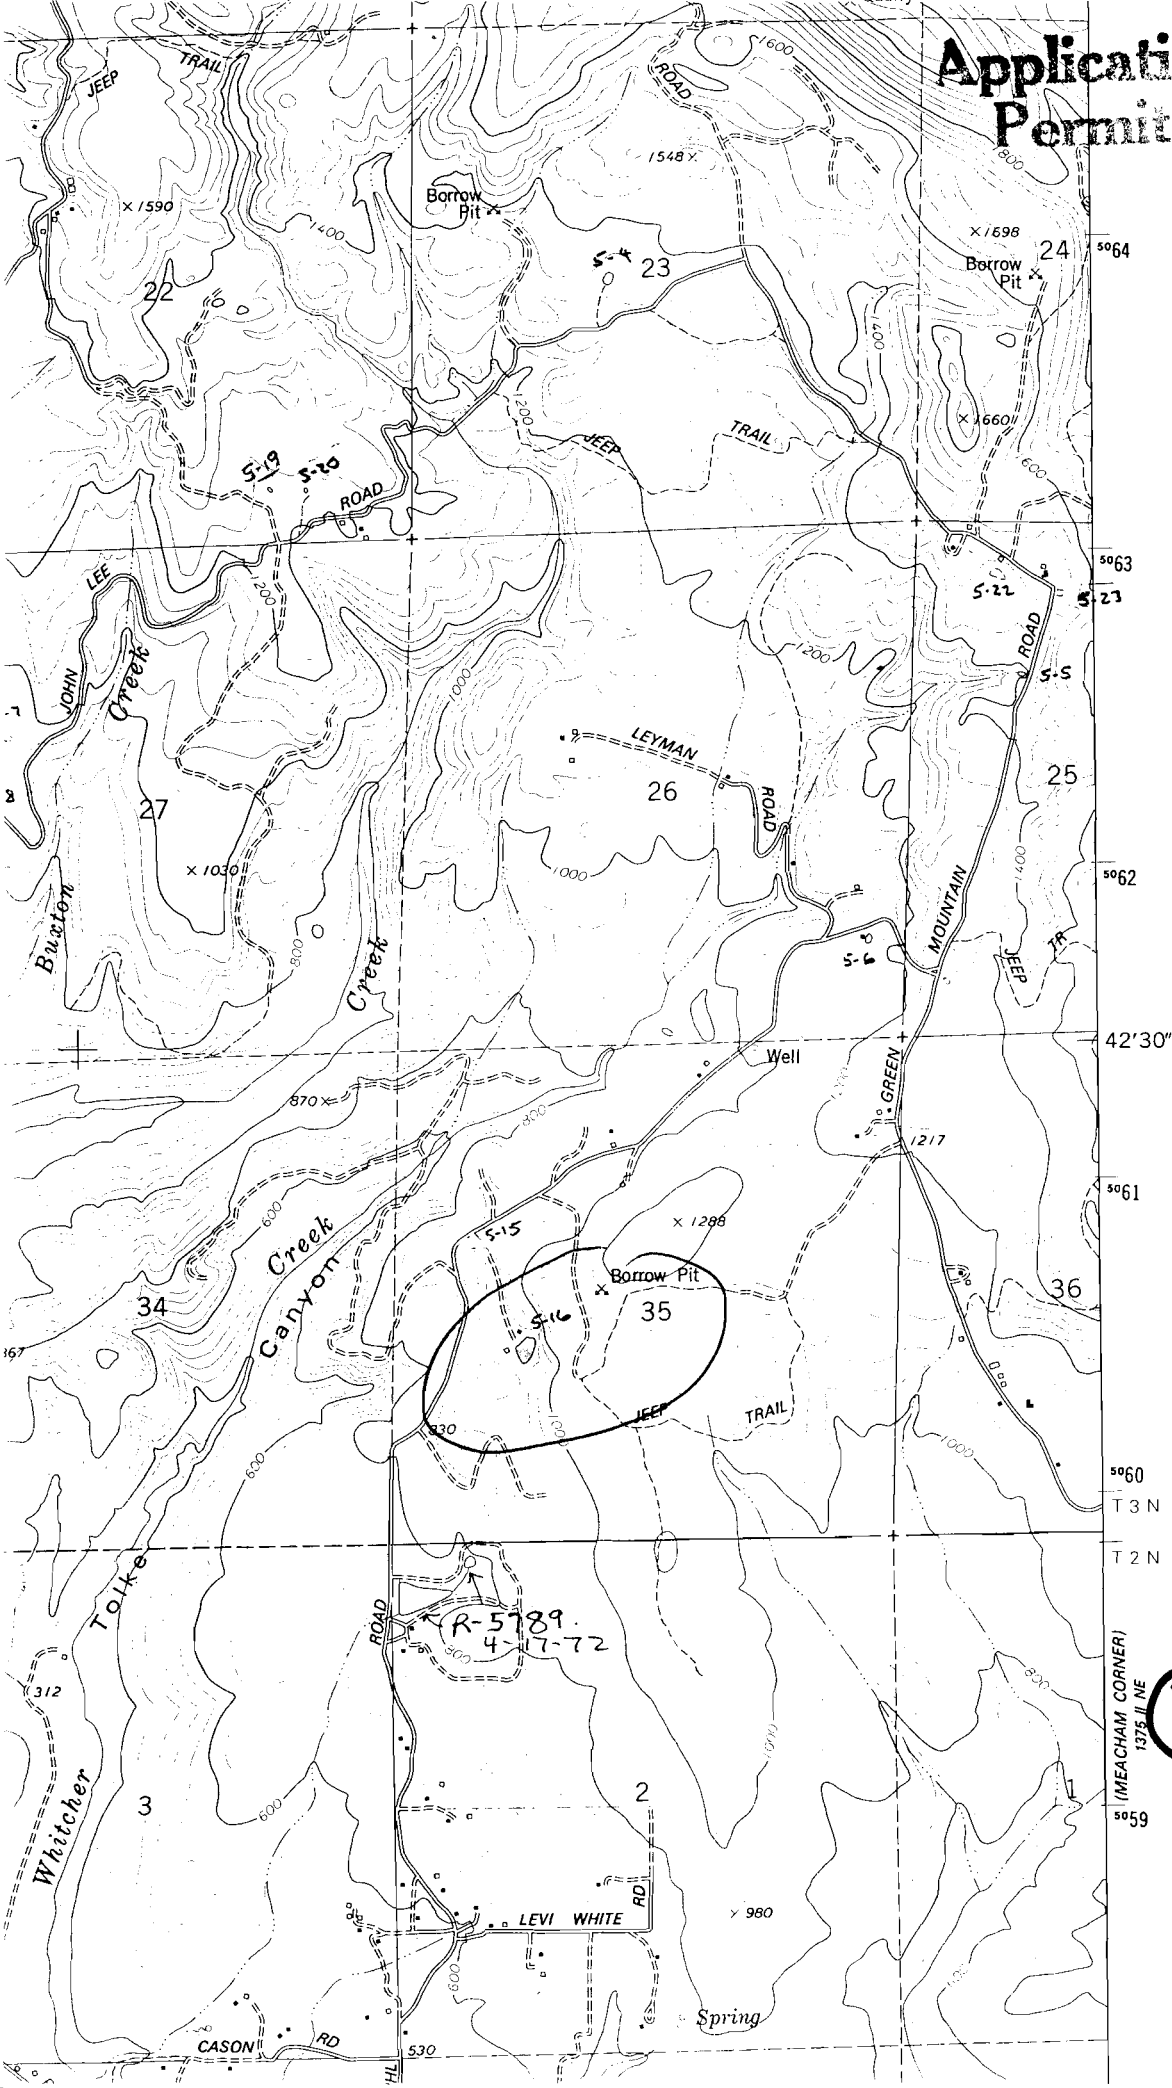

T 3 N
T 2 N
1375 II NE
5059

6

Buxton
1979