

SEE MAP 5 1 31

Application No. R-76997
Permit No.


RECEIVED 1995

RECEIVED

JAN - 4 1995
WATER RESOURCES DEPT.
SALEM, OREGON

13855

~~REPLICATE~~

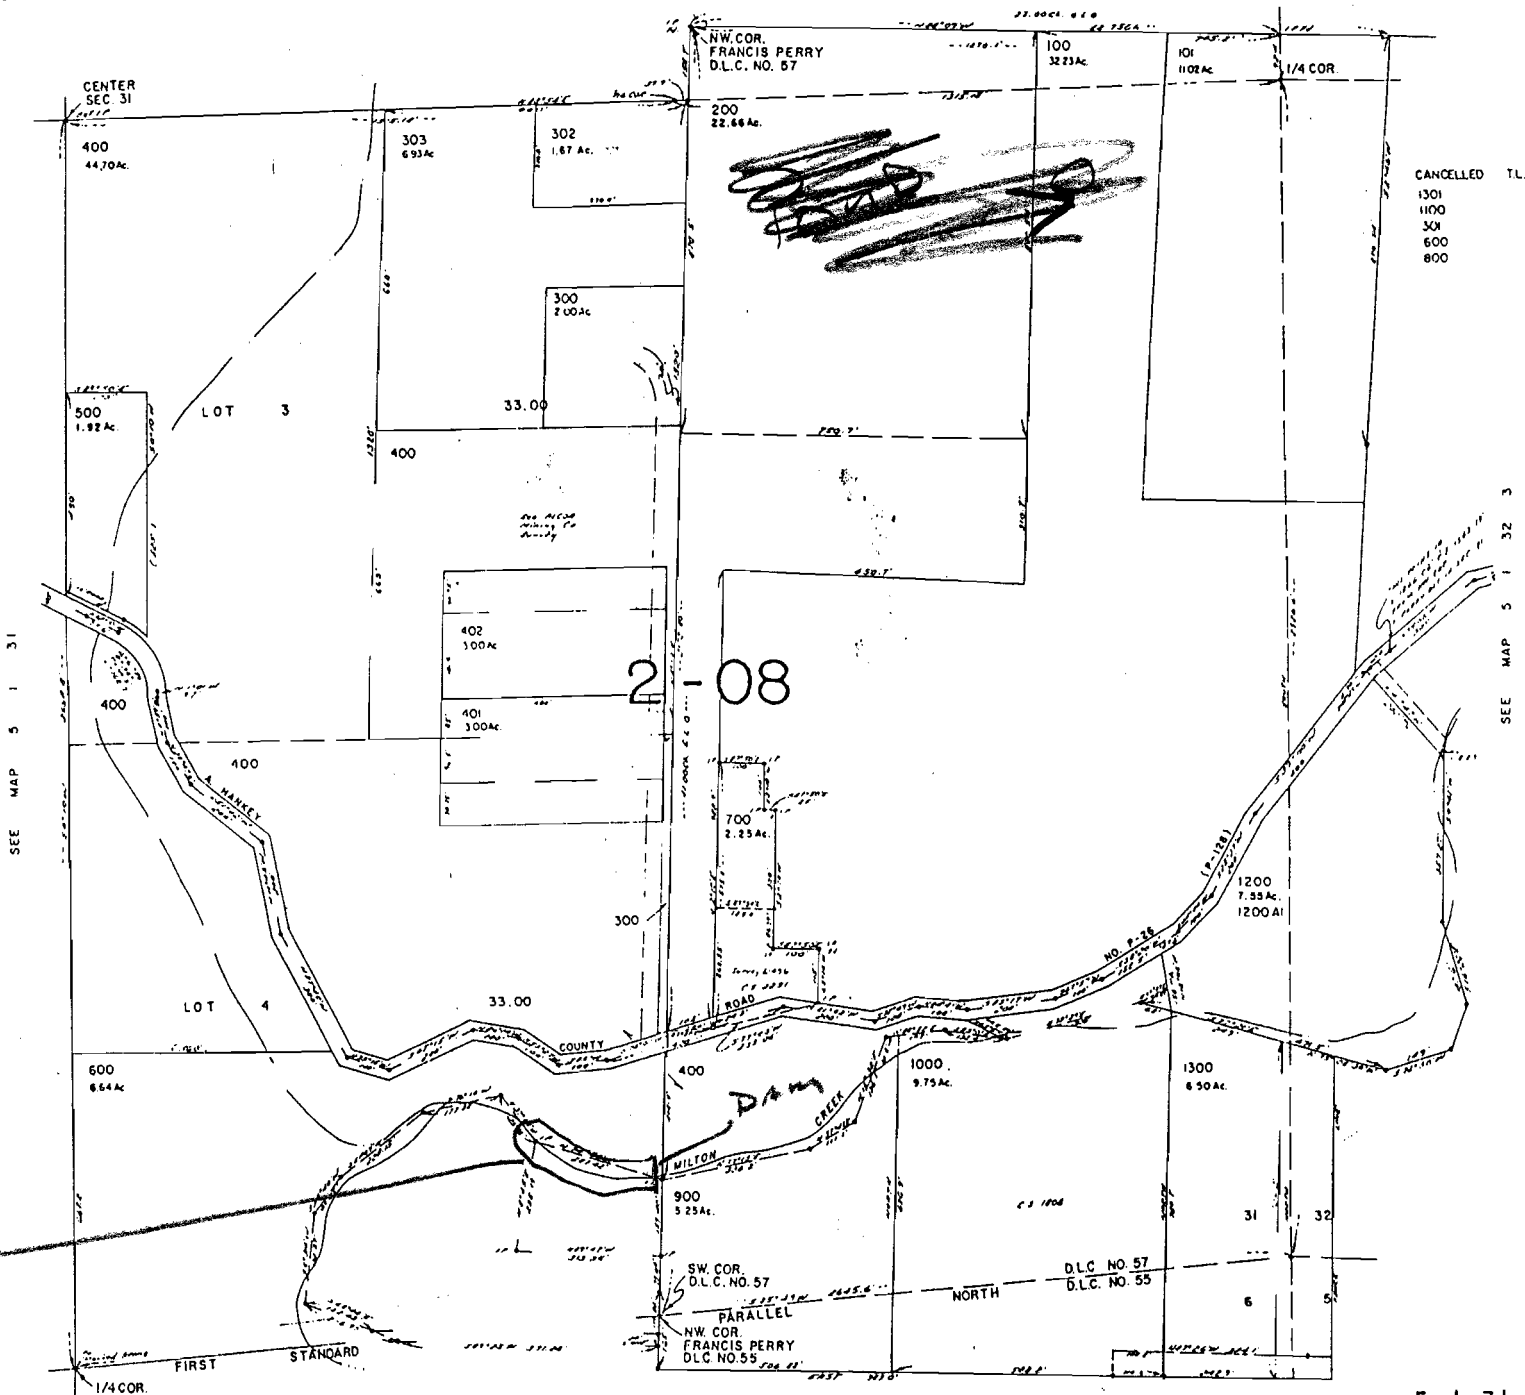

CANCELLED T.L.
1301
1100
501
600
800

SEE MAP 5 1 32 3

SEE MAP 4 1 6 1