


TOWNSHIP PLAT No. 17

For Sale by the Kilham Stationery and Printing Co., Portland, Oregon

Township No. 12 South Range 9 E. W. M.  
Jefferson County, Oregon

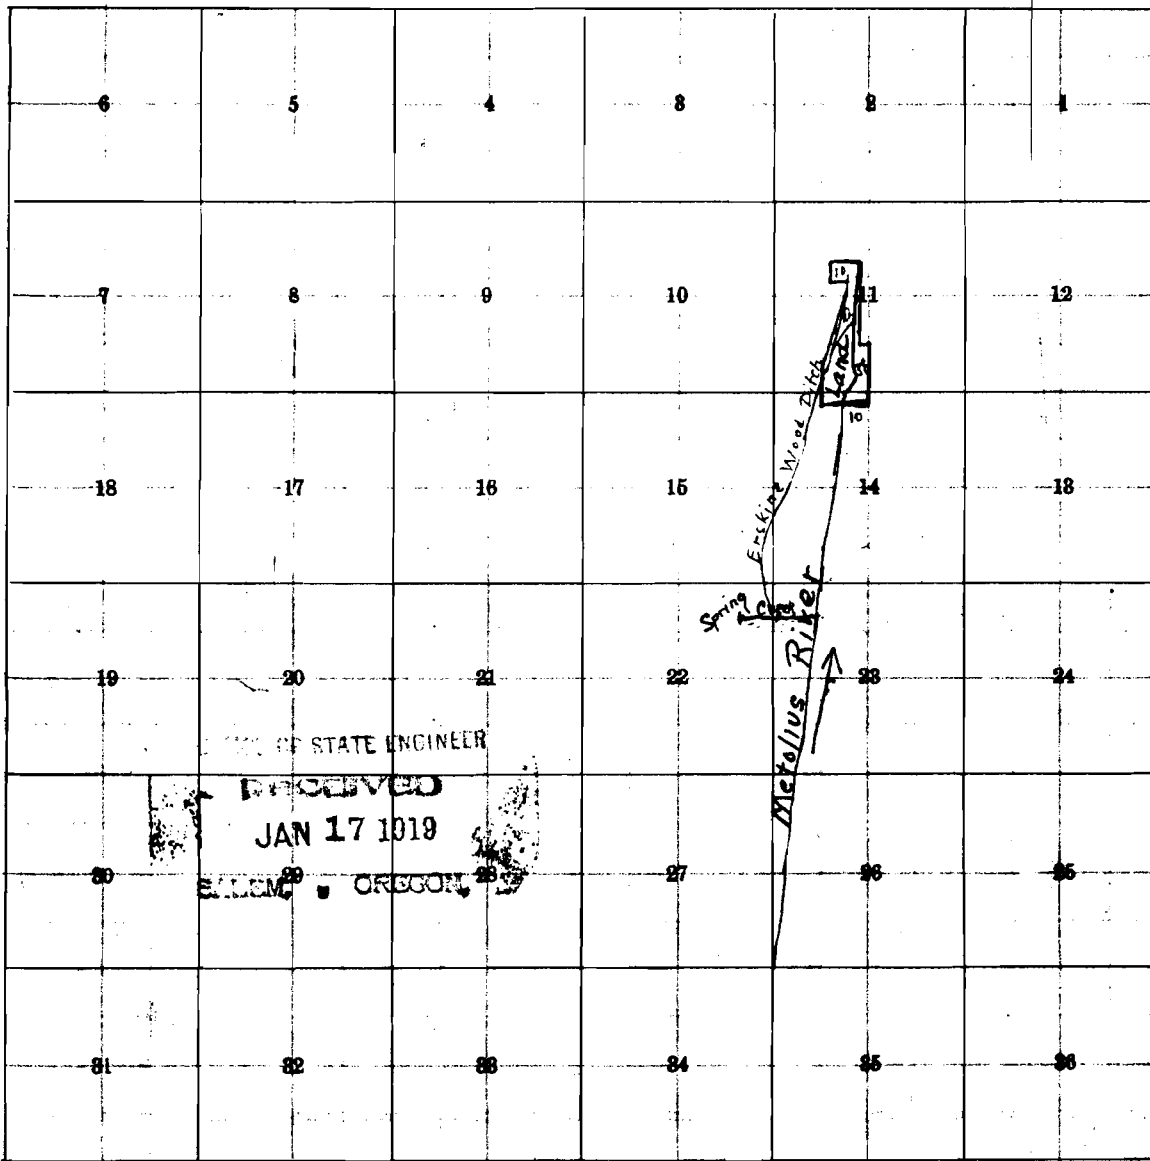

Application No. **6381**  
 Permit No. **3990**