


SECTION


10

Oregon State Water Filings

TOWNSHIP 22 S, RANGE 29 E, W. M.

1954

North

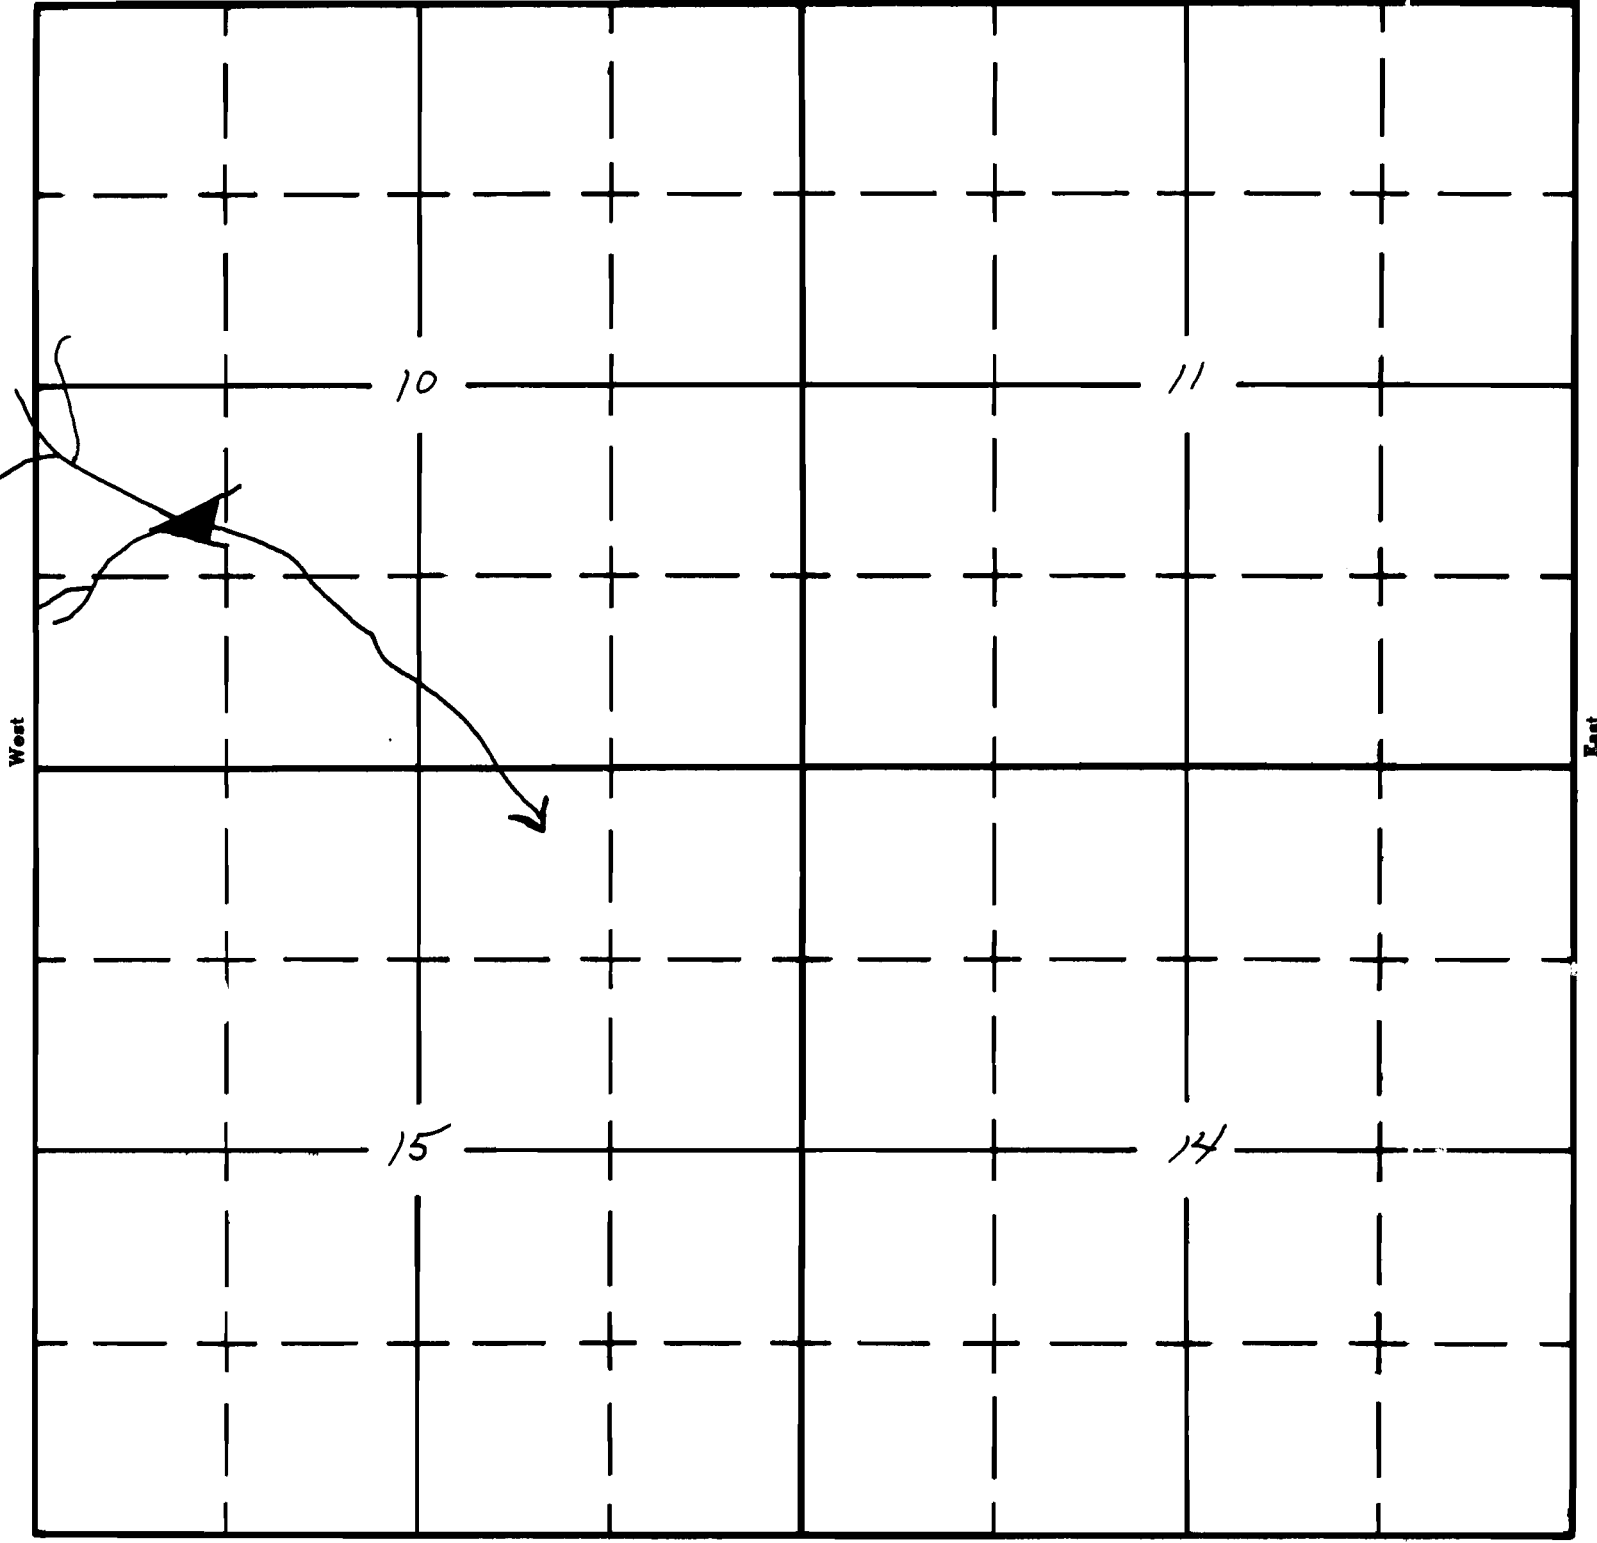

South

APPLICATION No. R-38979
PERMIT No. R-3468