



Application No. R-79182
Permit No. 18.1

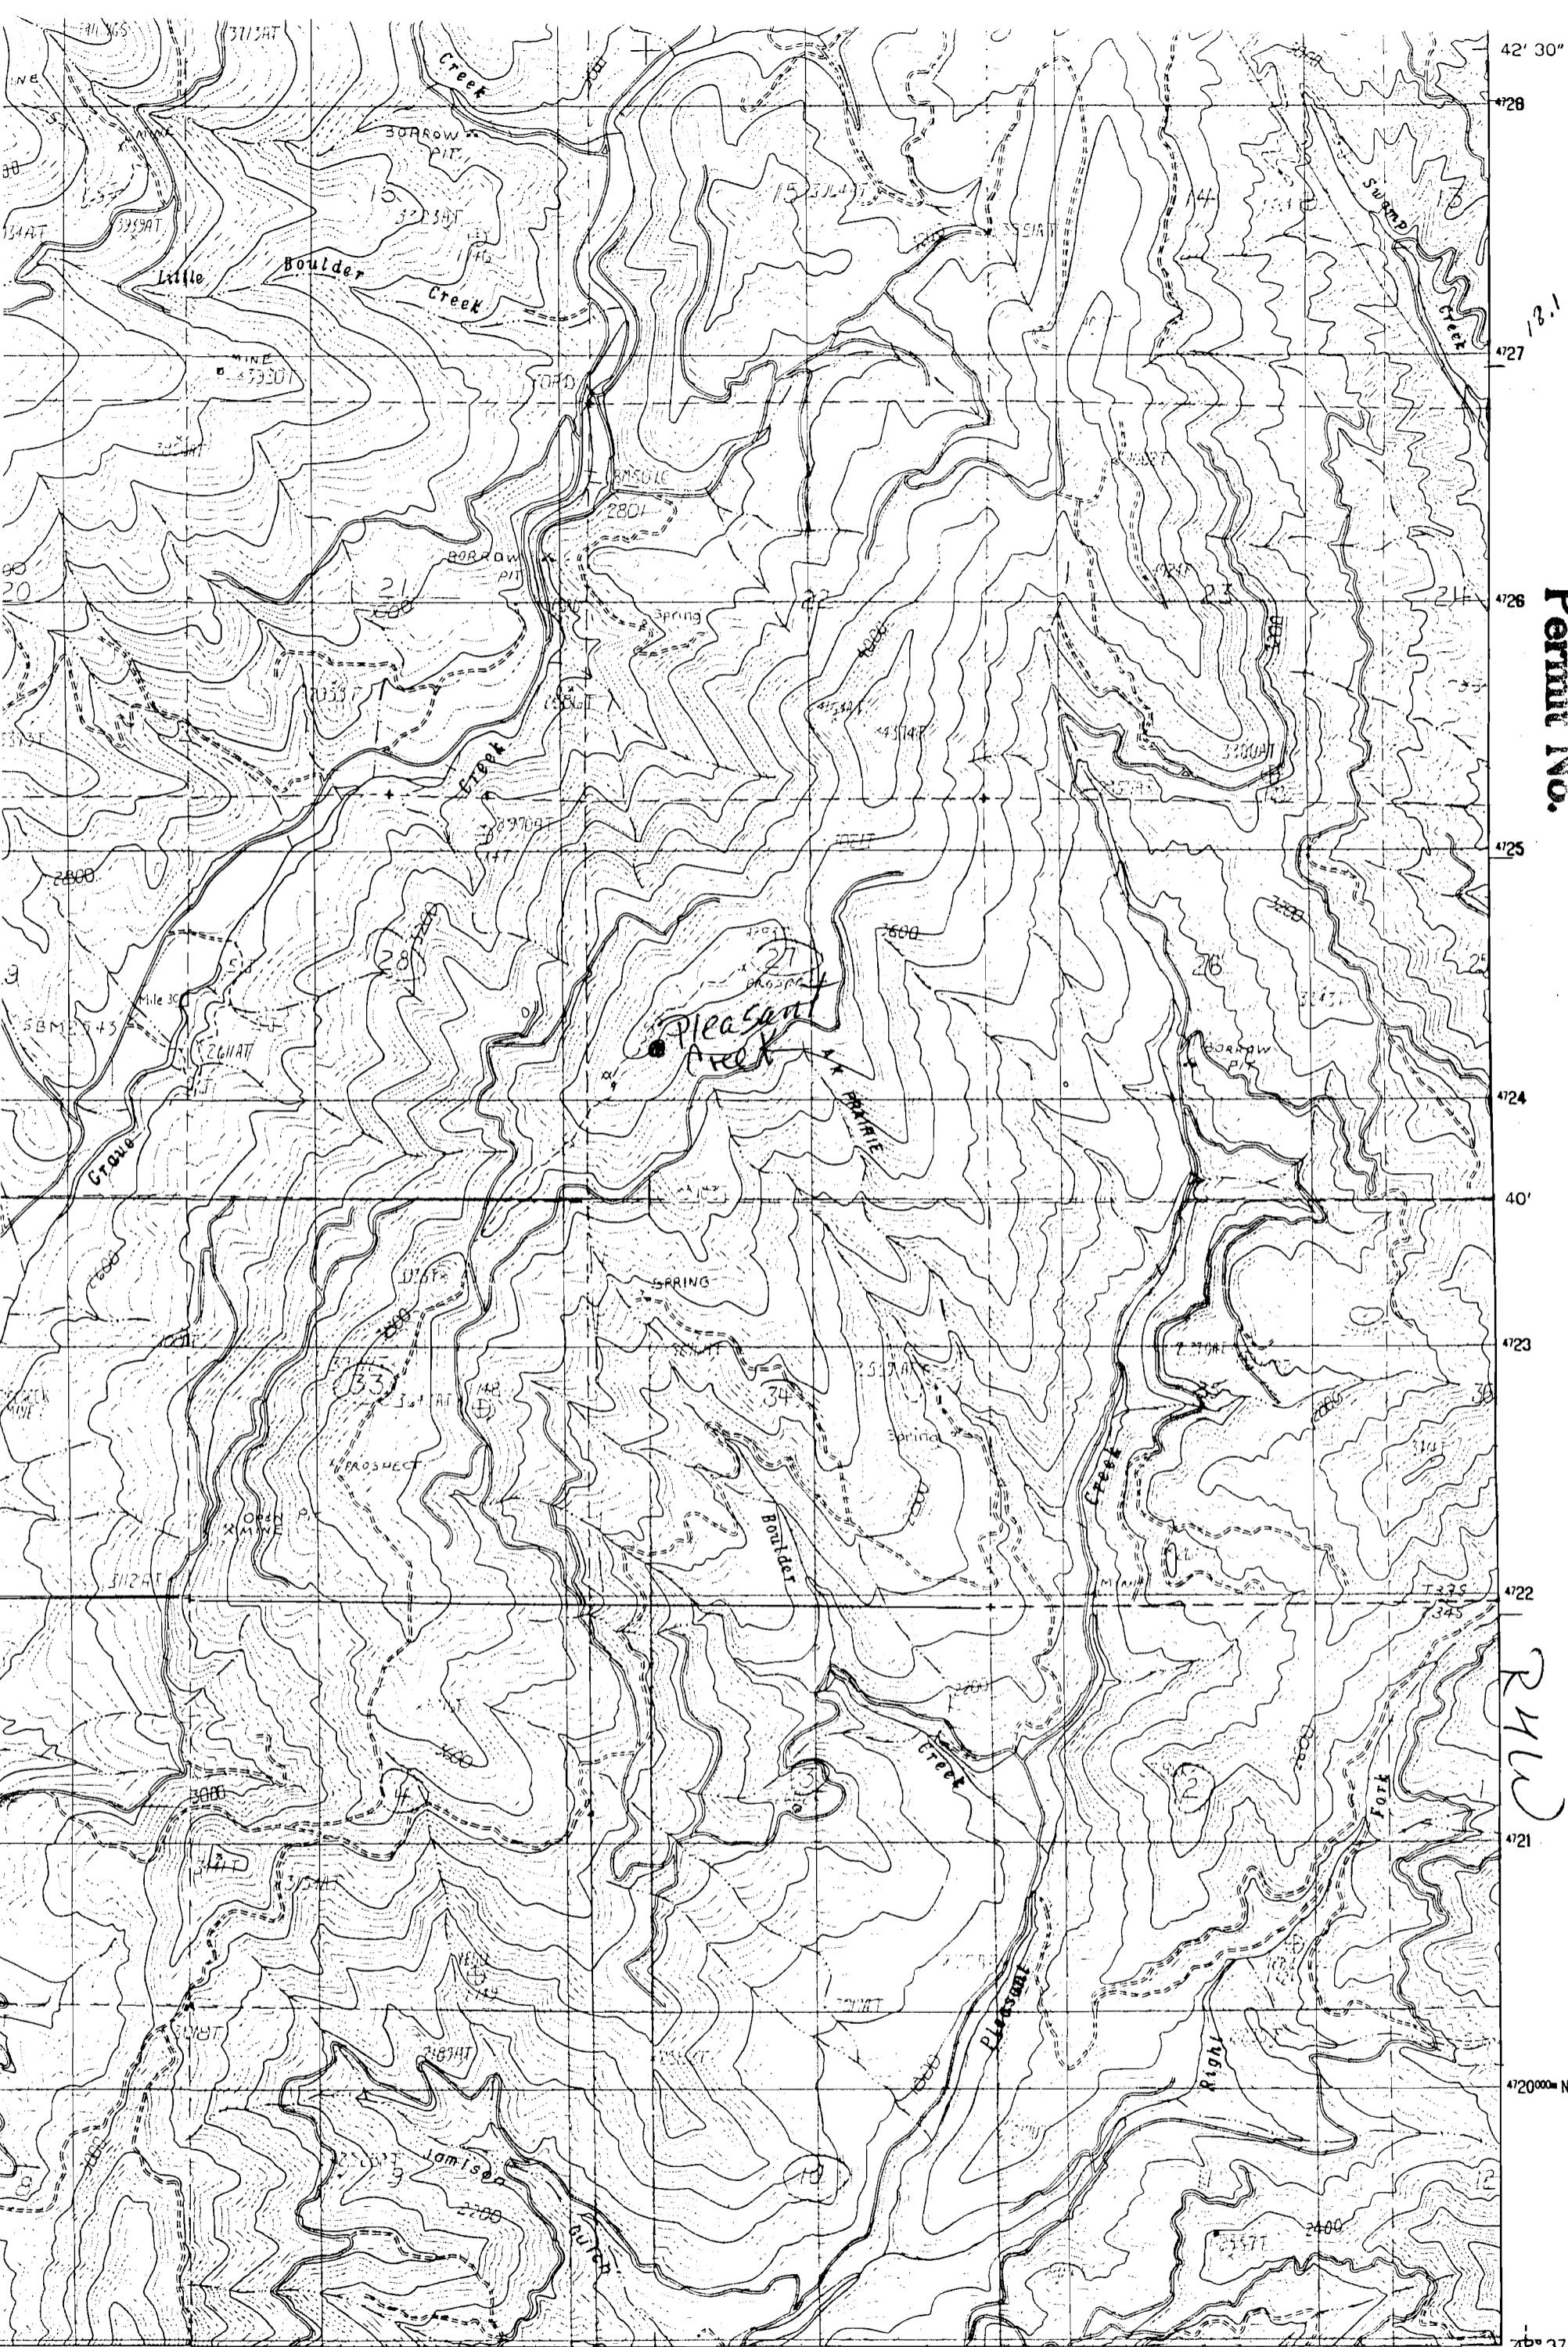


42' 30"
428
427
426
425
424
40'
423
422
421
420000 N
42' 37' 30"

SCALE 1:24 000

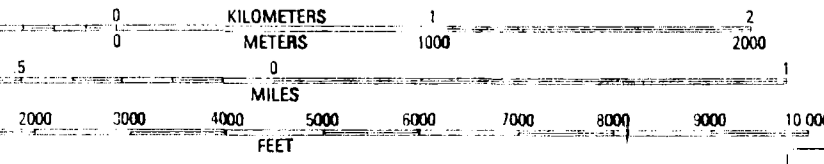

INTERIOR GEOLOGICAL SURVEY RESTON, VIRGINIA 1982

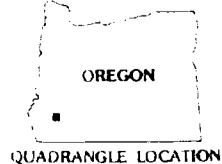

King Mountain Quad
ROAD LEGEND

- Improved Road.....
- Unimproved Road.....
- Trail.....
- Interstate Route
- U.S. Route
- State Route

CONTOUR INTERVAL 40 FEET

QUADRANGLE LOCATION