



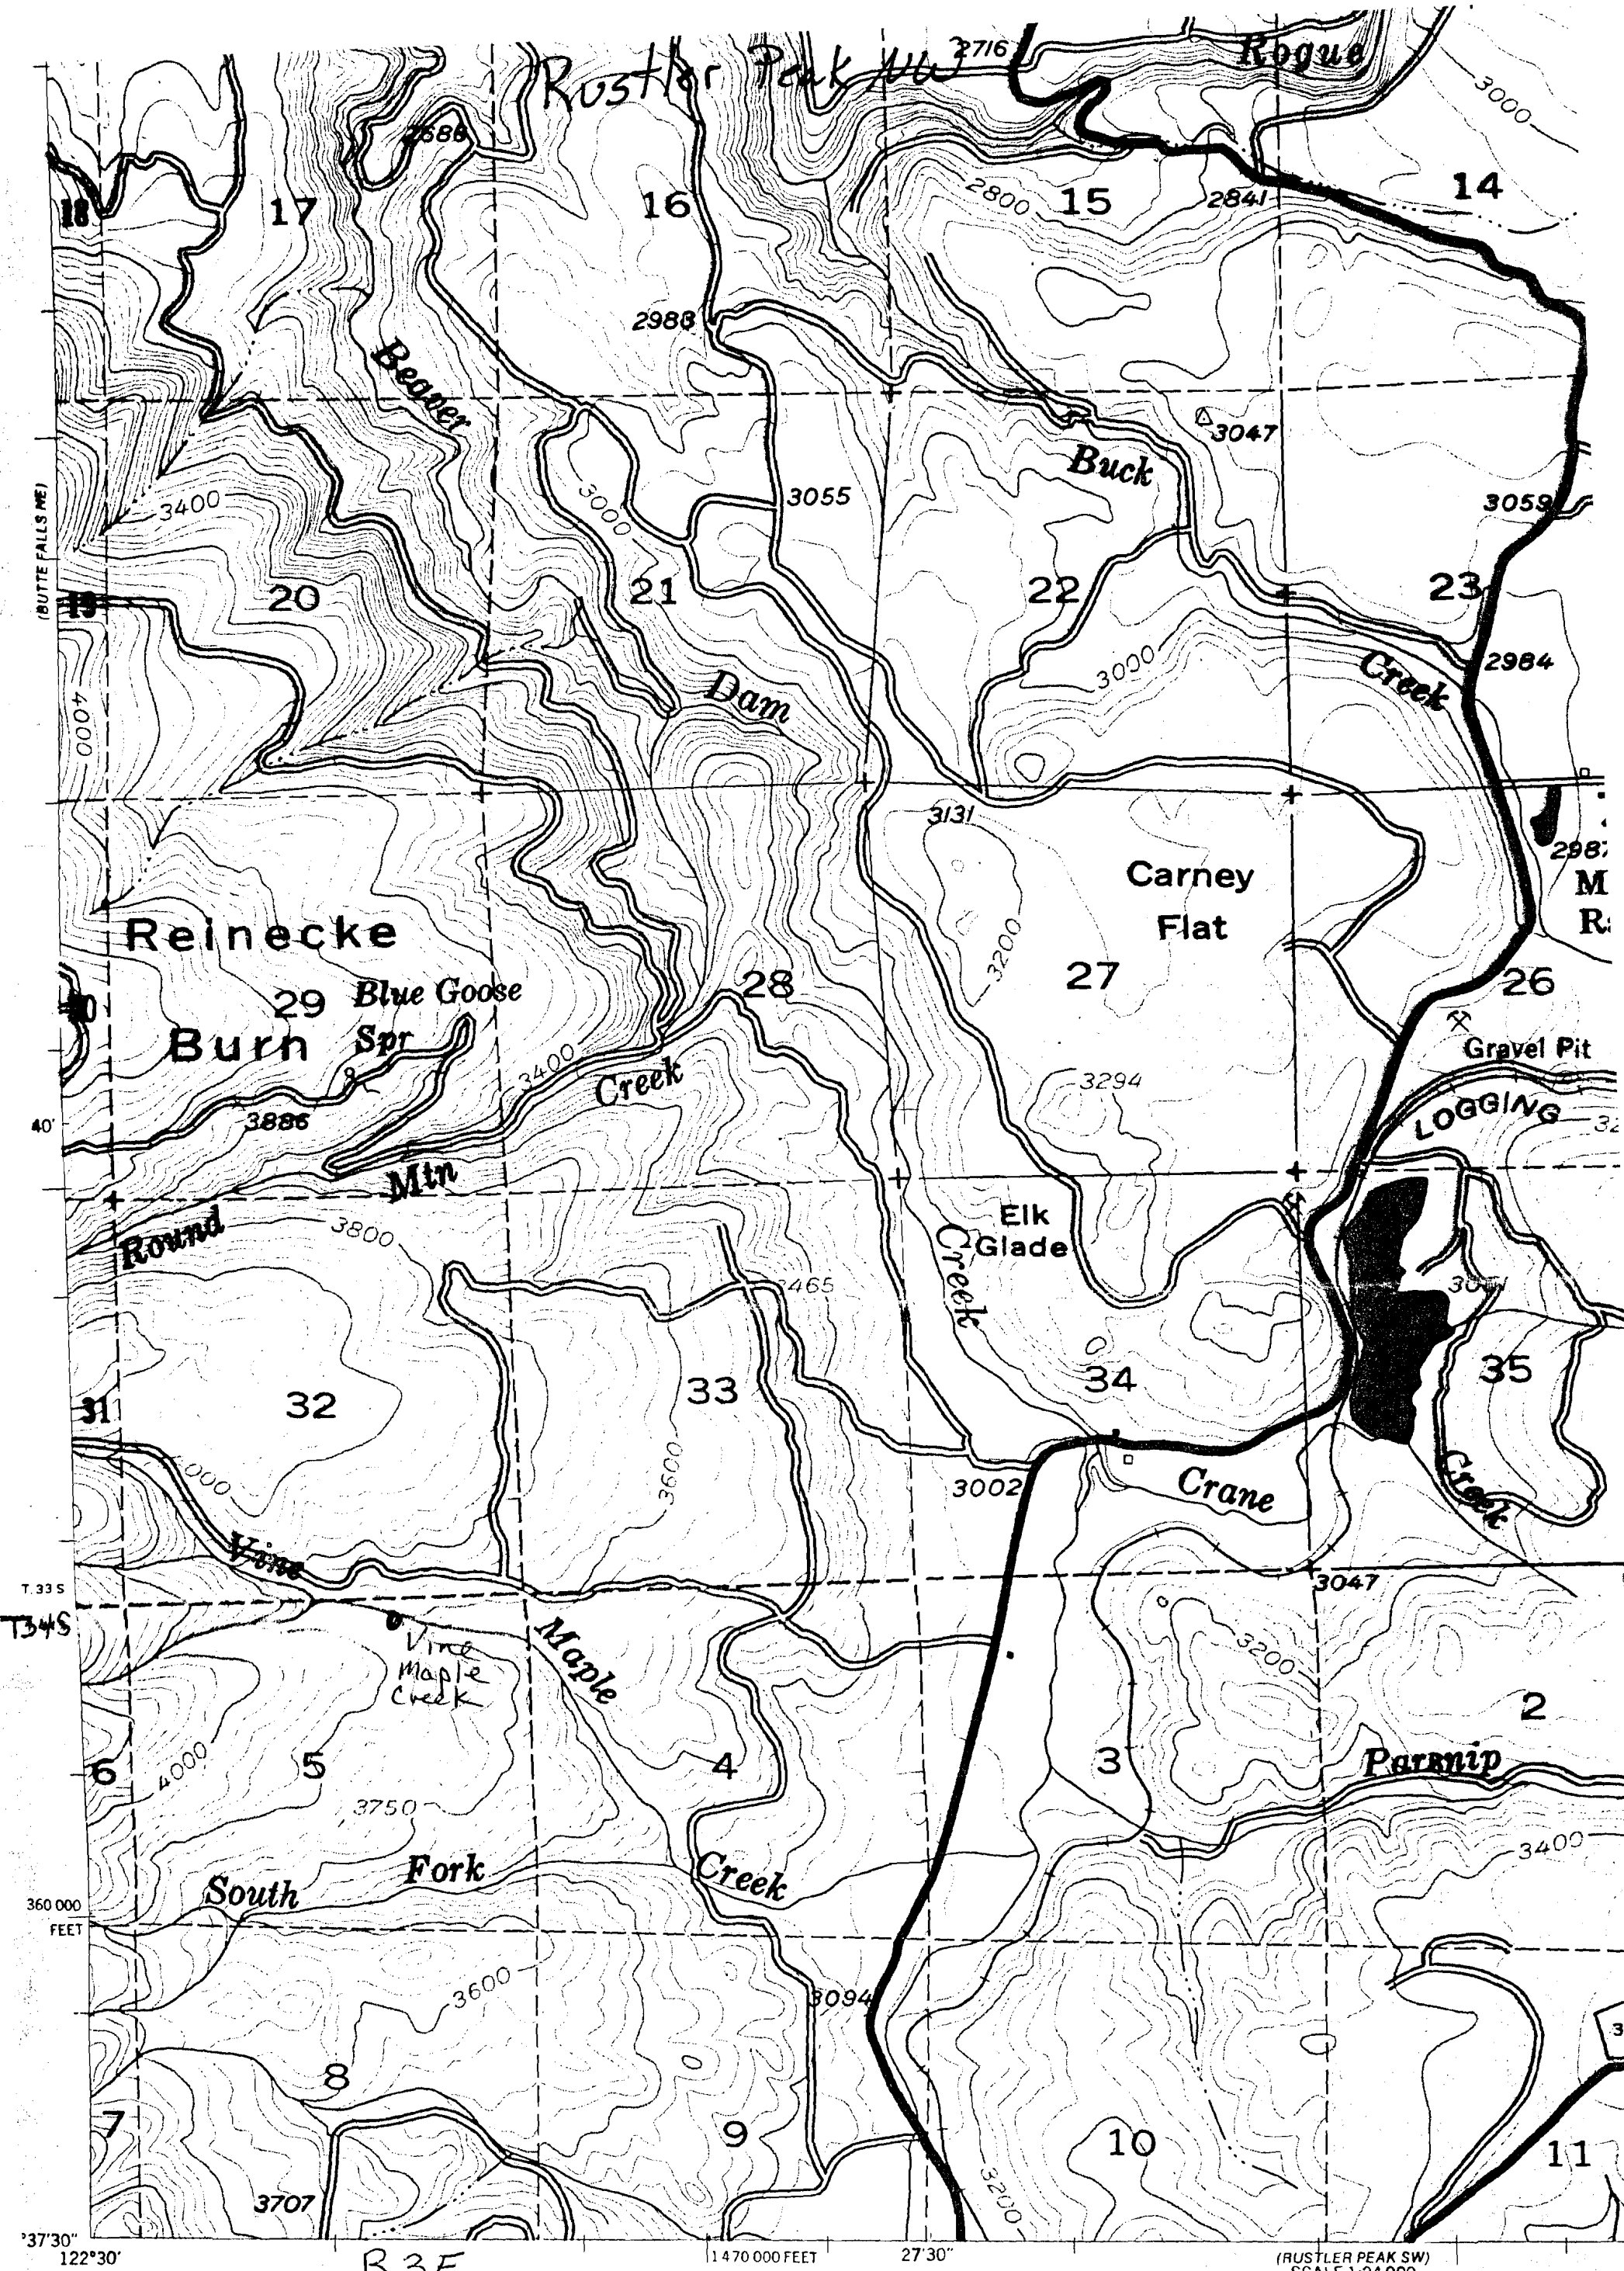

Base map prepared by the U.S. Geological Survey
Control by USGS and USC&GS
Topography by photogrammetric methods from aerial photographs taken 1953. Field check 1955
Polyconic projection, 1927 North American datum
10,000-foot grid based on Oregon coordinate system, south zone.
1000-meter Universal Transverse Mercator grid ticks, zone 10, shown in blue.
INTERMEDIATE EDITION

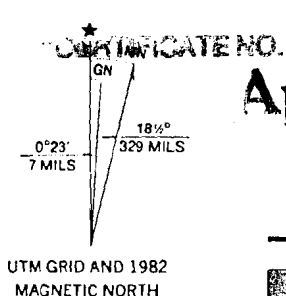

Application No. 79186
Permit No.

1:10
1000 0 1000 2000 3000 4000 5000 6000
CONTOUR INTERVAL 40 FEET
NATIONAL GEODETIC VERTICAL DATUM OF 1929

LEGEND

- National Forest Boundary
- Alienated Land Within the National Forest Boundary as of 1981