



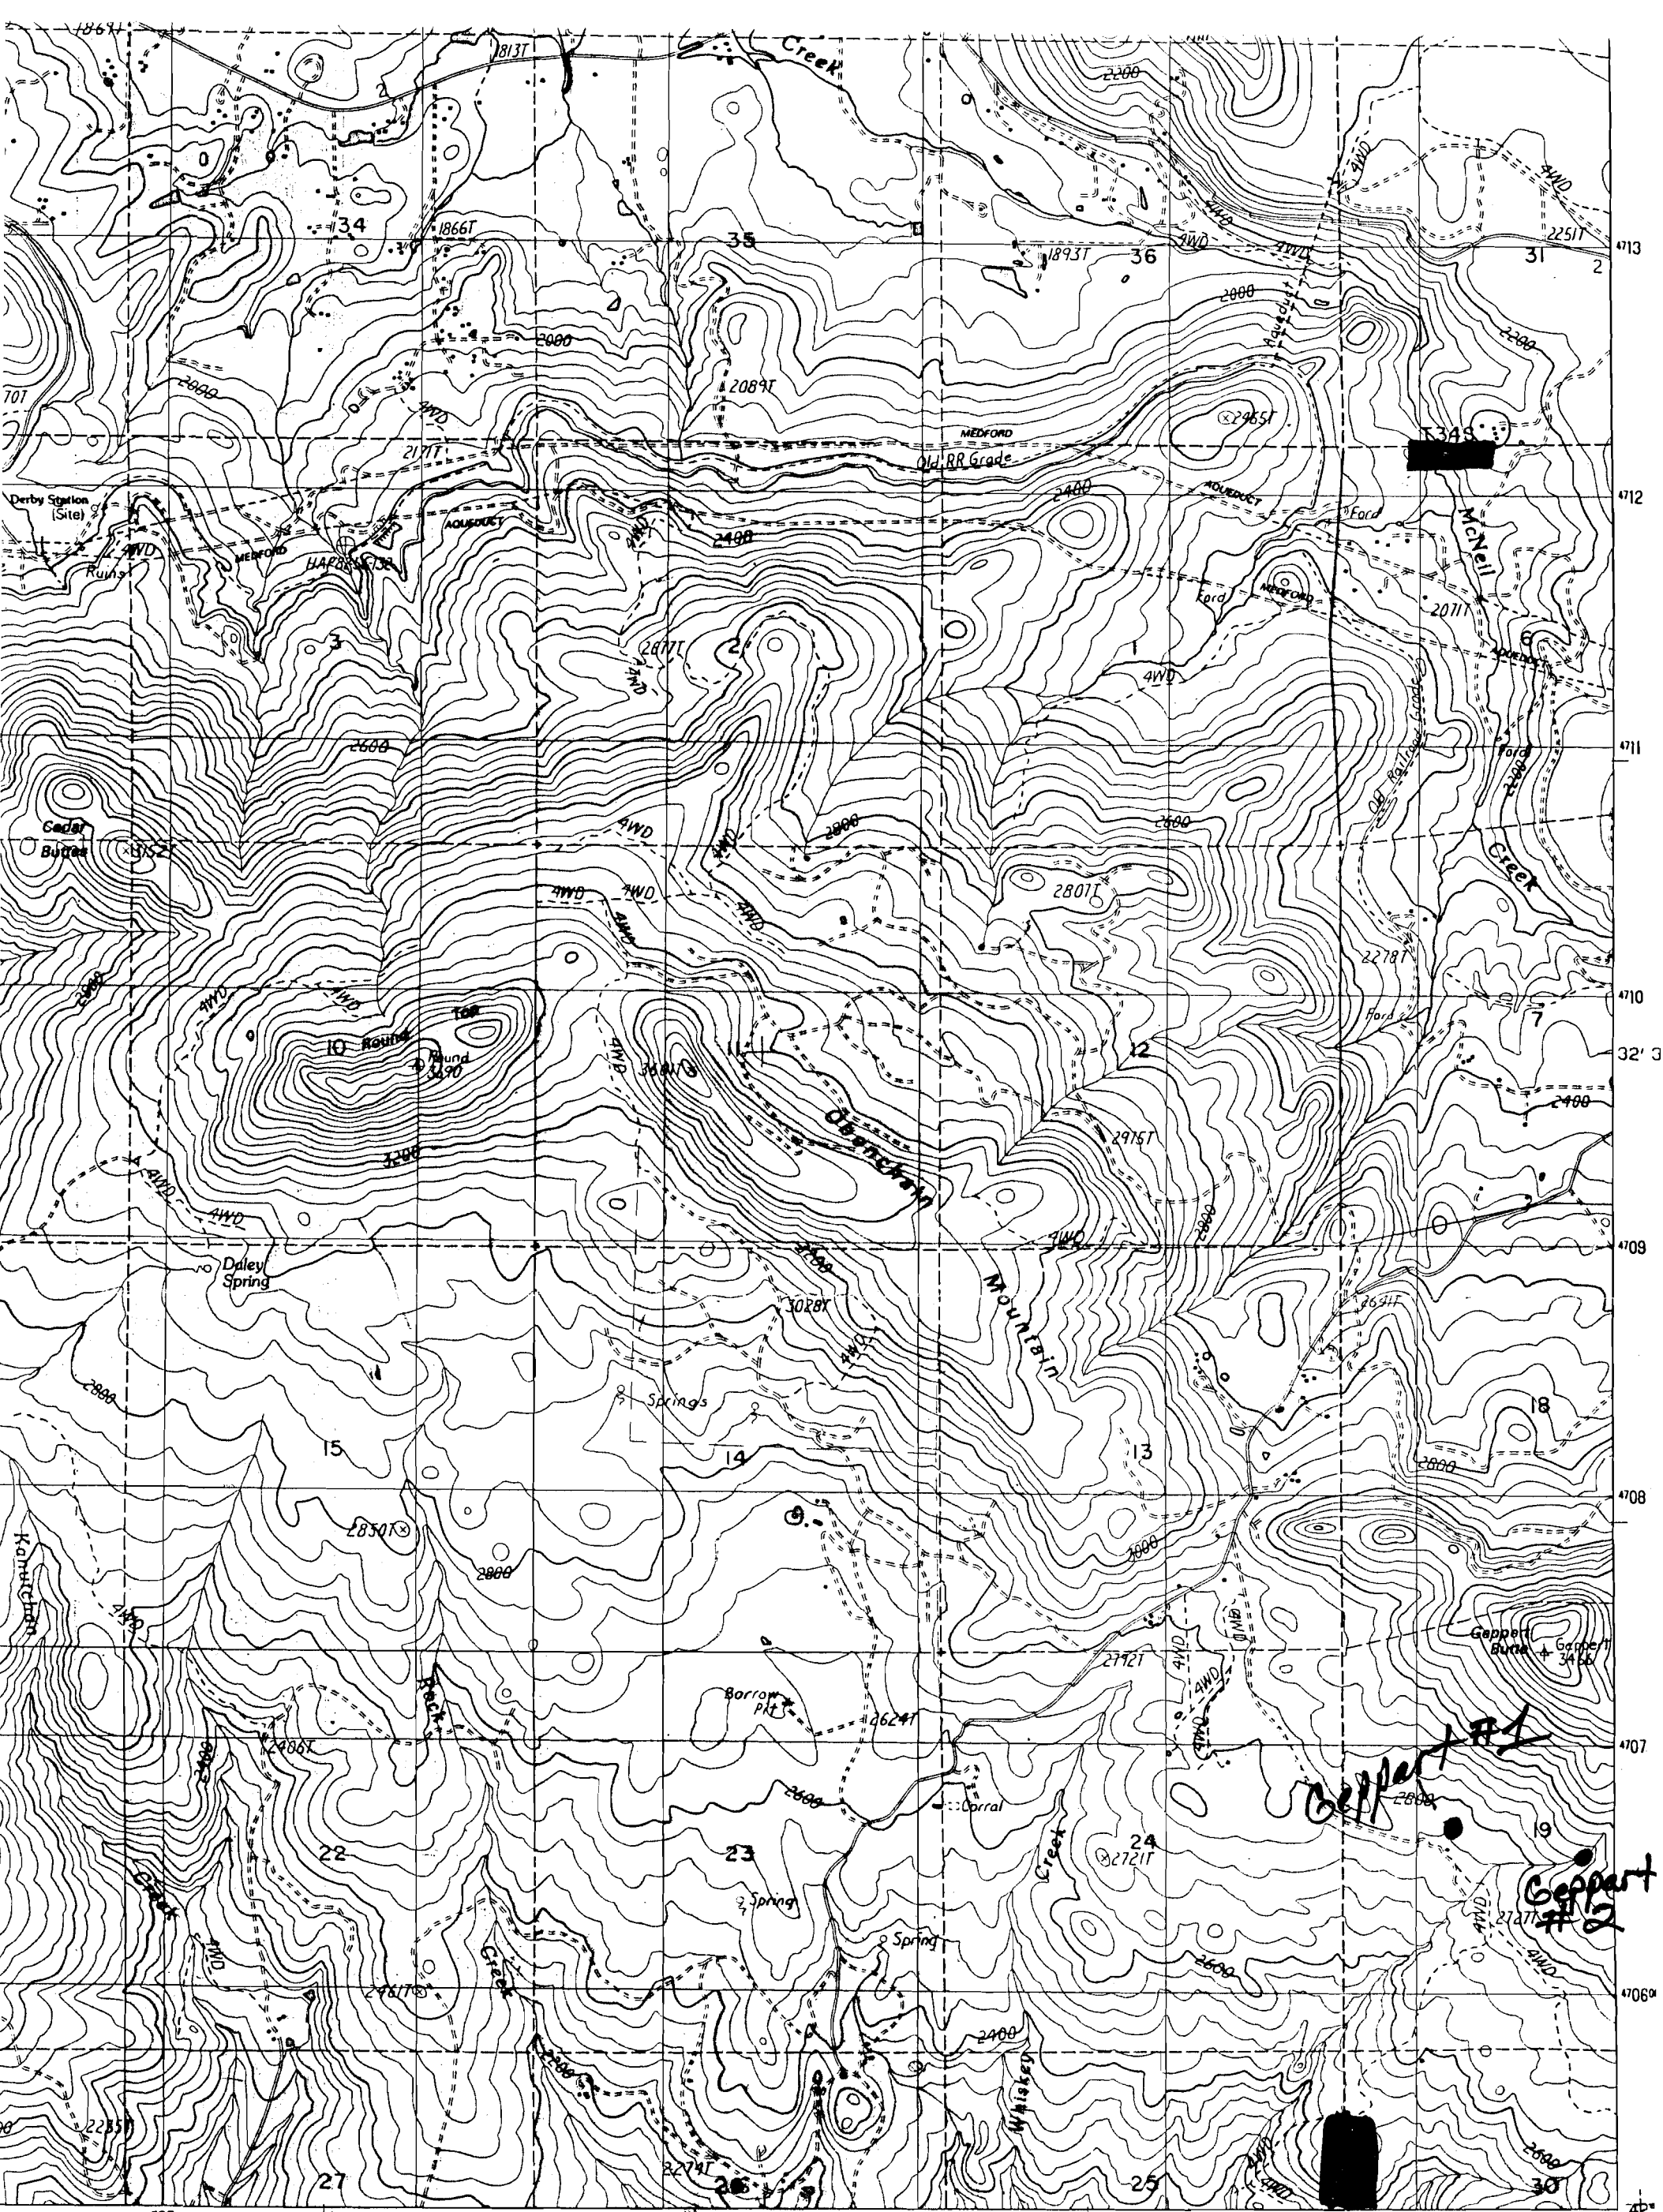

SCALE 1:24 000

INTERIOR GEOLOGICAL SURVEY, RESTON, VIRGINIA—1986

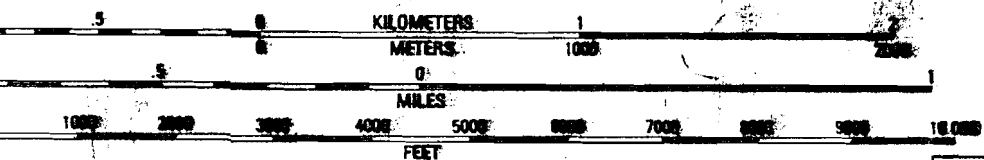

CONTOUR INTERVAL 40 FEET

To convert meters to feet multiply by 3.2808
To convert feet to meters multiply by 0.3048



QUADRANGLE LOCATION

1	2	3	1: Trail
4	5	6	2: McLean
			3: Cascade Gorge
			4: Shady Cove
			5: Butte Falls
			6: Eagle Point
			7: Brownboro
			8: Brownboro

ADJOINING 7.5' QUADRANGLE NAMES

Application No R 79206
Permit No. ROAD LEGEND

Improved Road
Unimproved Road
Trail
Interstate Route U.S. Route State Route

20 OBENCHAIN MTN., OREG.

PROVISIONAL EDITION 1988