


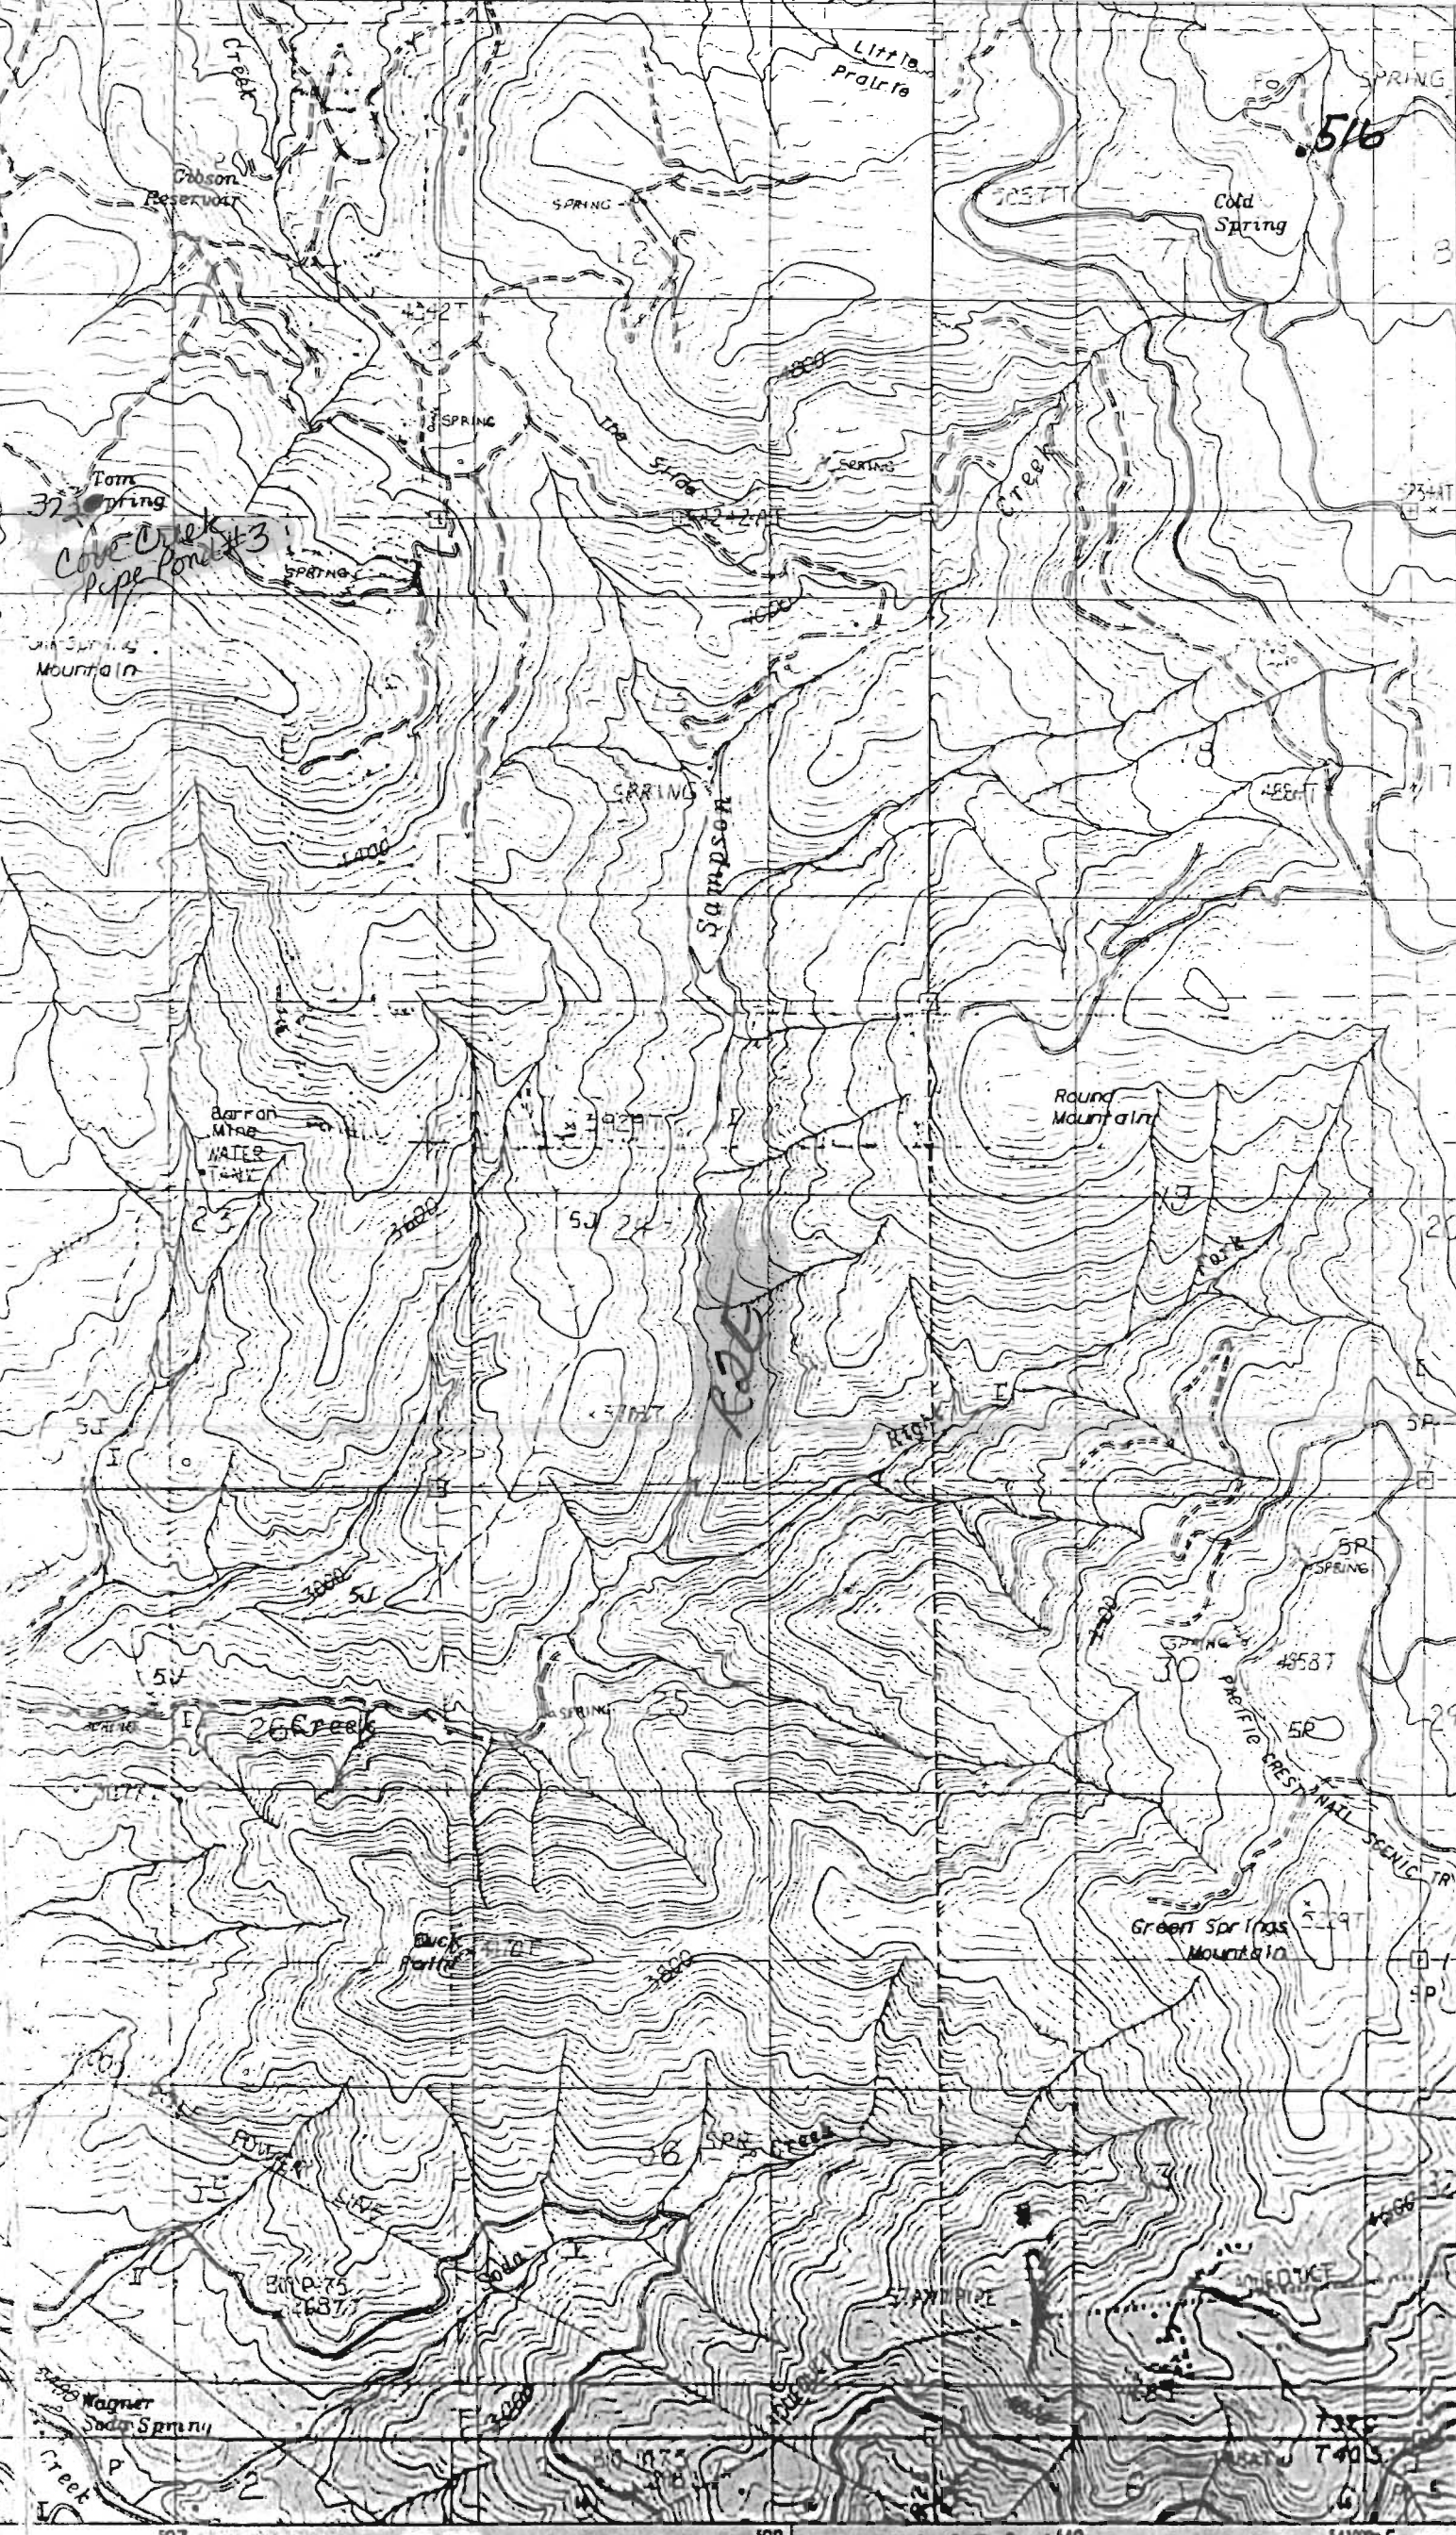

T395

[Scale = 1:24000]

EMIGRANT LAKE QUAD

ROAD LEGEND

Improved Road

Unimproved Road

Trail

Interstate Route

U.S. Route

State Route

Application No. 79220

Permit No. 71436

QUADRANGLE LOCATION

1 Rio Canyon

2 Grizzly Peak

3

Scale

0 1000 2000

0 1000 2000