


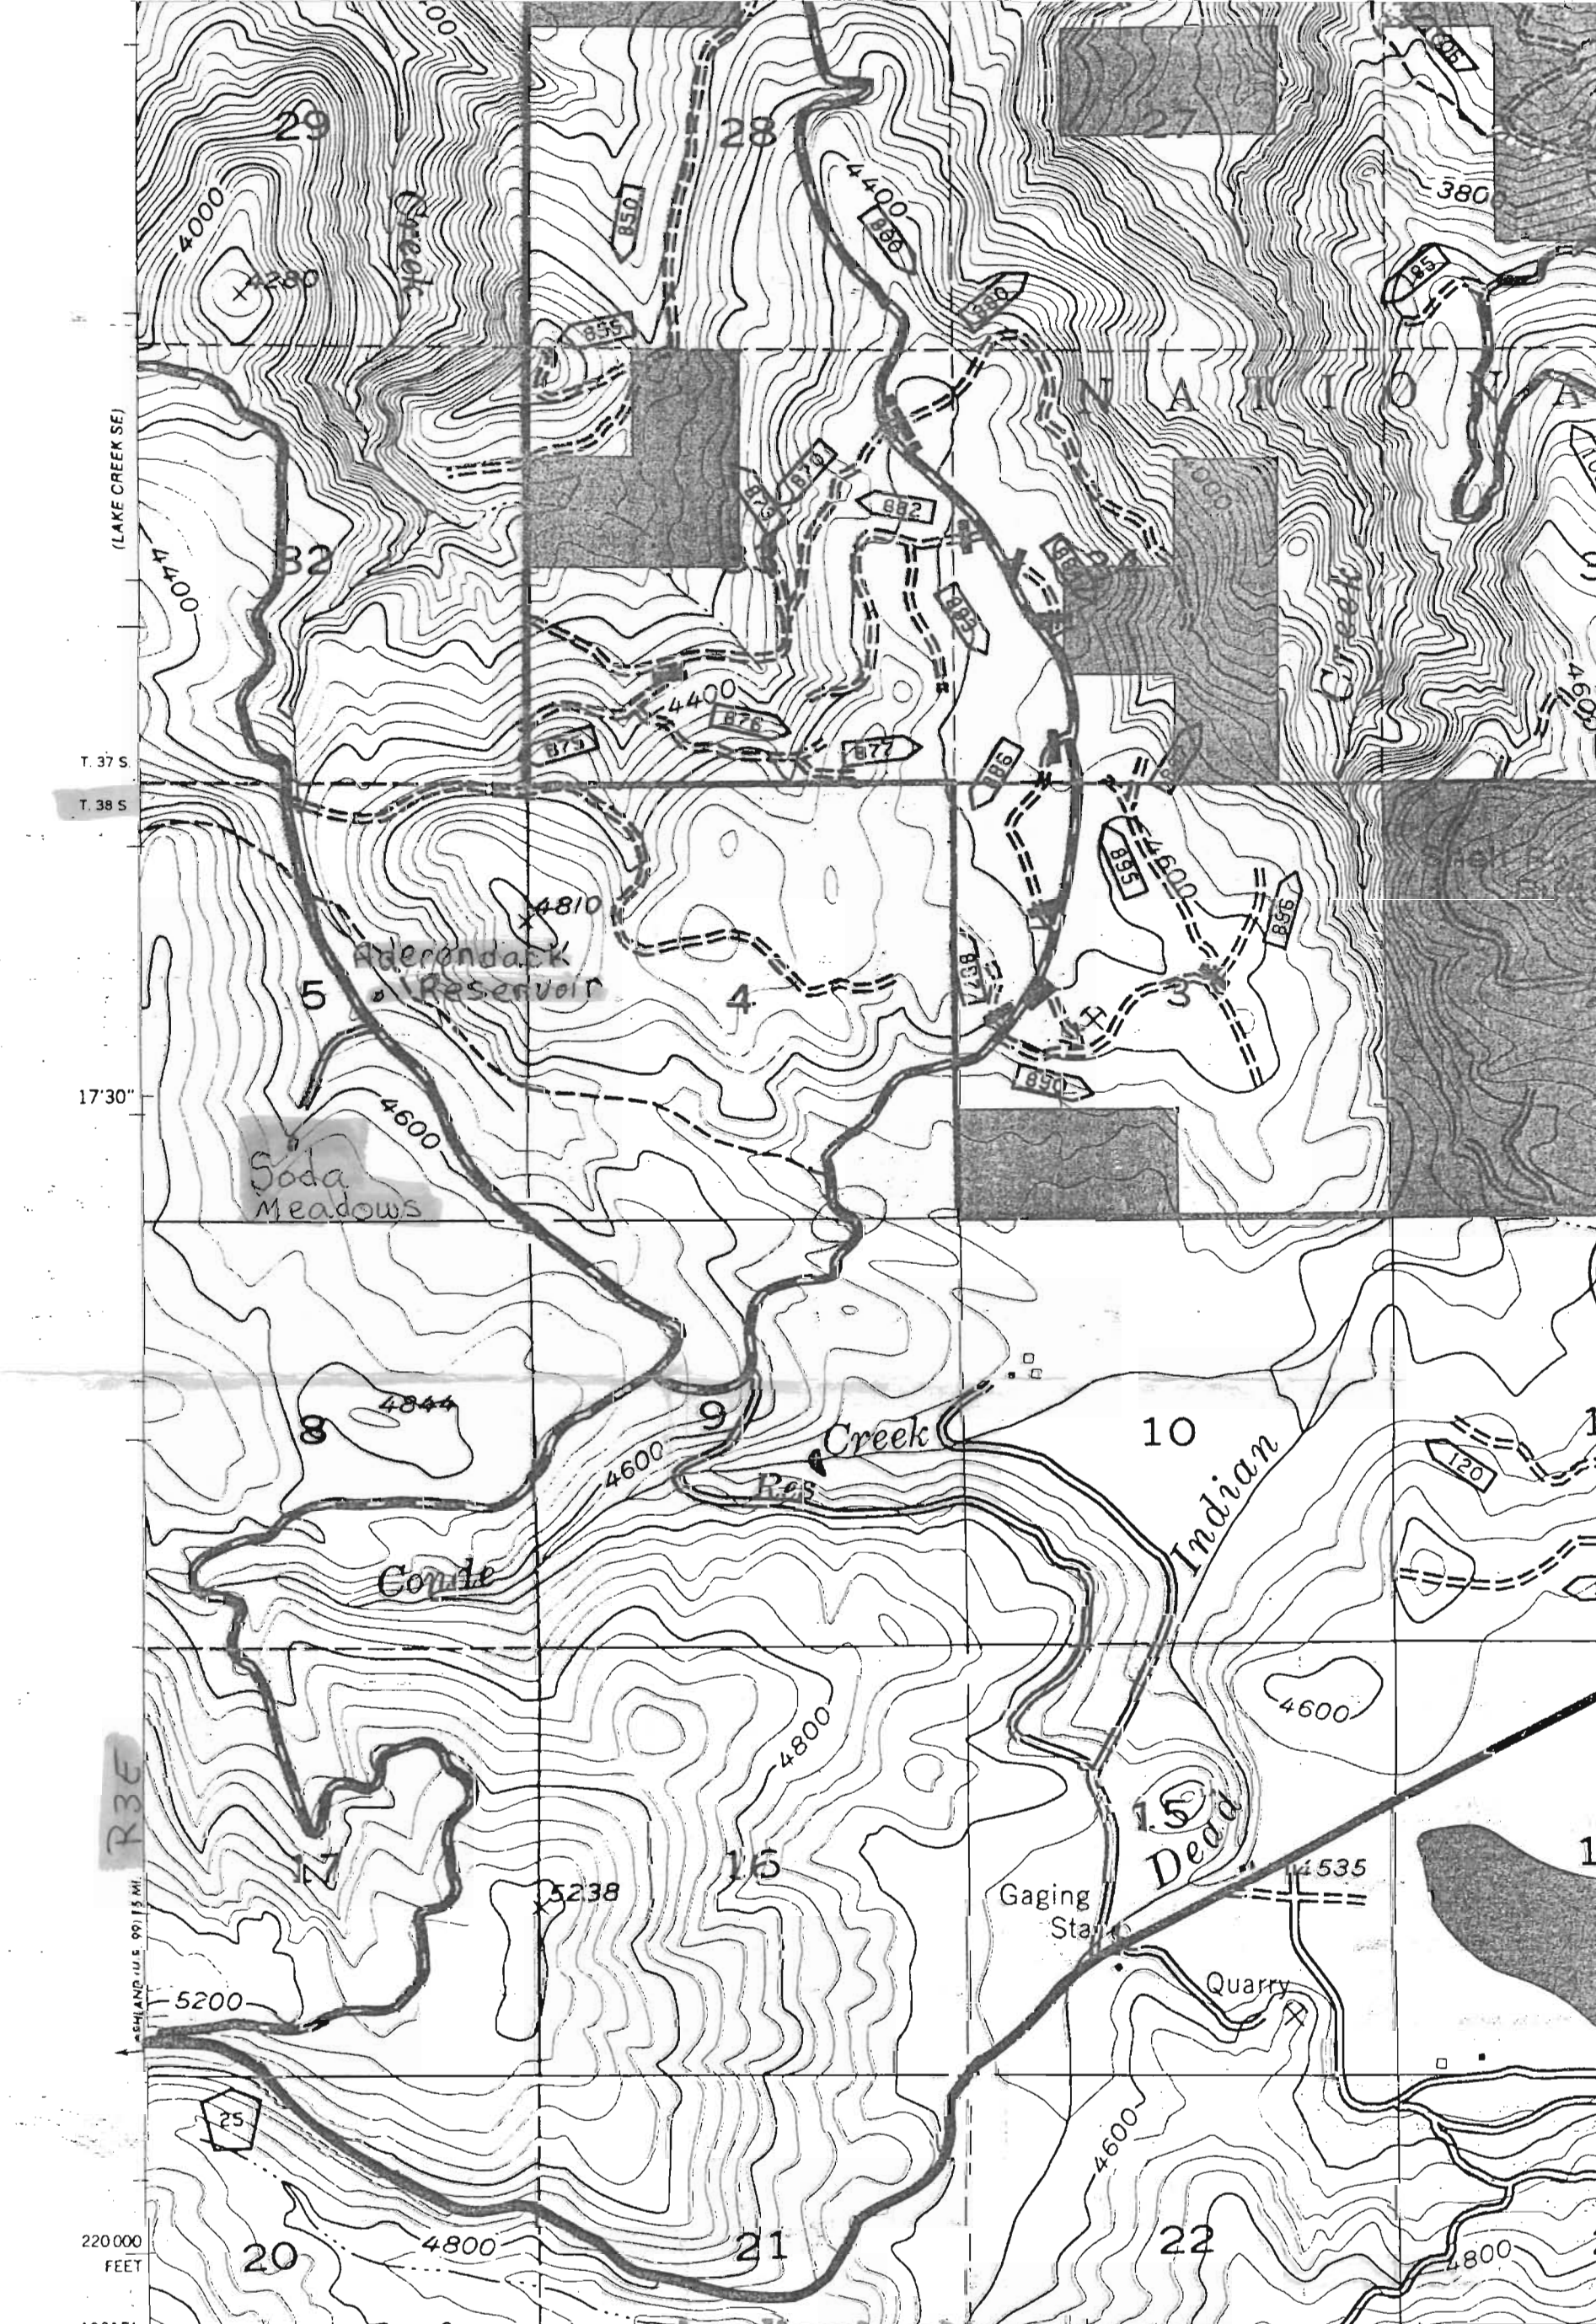

Application No. R-79240
Permit No.

(HYATT RESERVOIR SCALE 1:24,000)



Base map prepared by the U.S. Geological Survey
Control by USGS and USC&GS

Topography by photogrammetric methods from aerial photographs taken 1953. Field check 1955
Polyconic projection. 1927 North American datum
10,000-foot grid based on Oregon coordinate system, south zone

1000-meter Universal Transverse Mercator grid ticks, zone 10, shown in blue.

INTERMEDIATE EDITIONIFICATE NO. 71446

Modification to USGS base map prepared by the Geometronics Service Center from 1980 aerial photography and 1982 correction guides furnished by the Pacific Northwest Region.

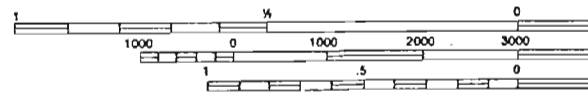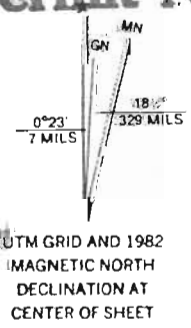

CONTOUR INTERVAL 40 FEET
NATIONAL GEODETIC VERTICAL DATUM 1985

Robinson Butte Quadd.

- LEGEND
- National Forest Boundary
 - Alienated Land Within the National Forest Boundary as of 1981
 - Special Area Boundary
 - TOWNSHIP AND SECTION LINE CLASSIFICATION
 - Surveyed, Location Reliable