


Siskiyou Pass,
Oreg. & Calif. Quad

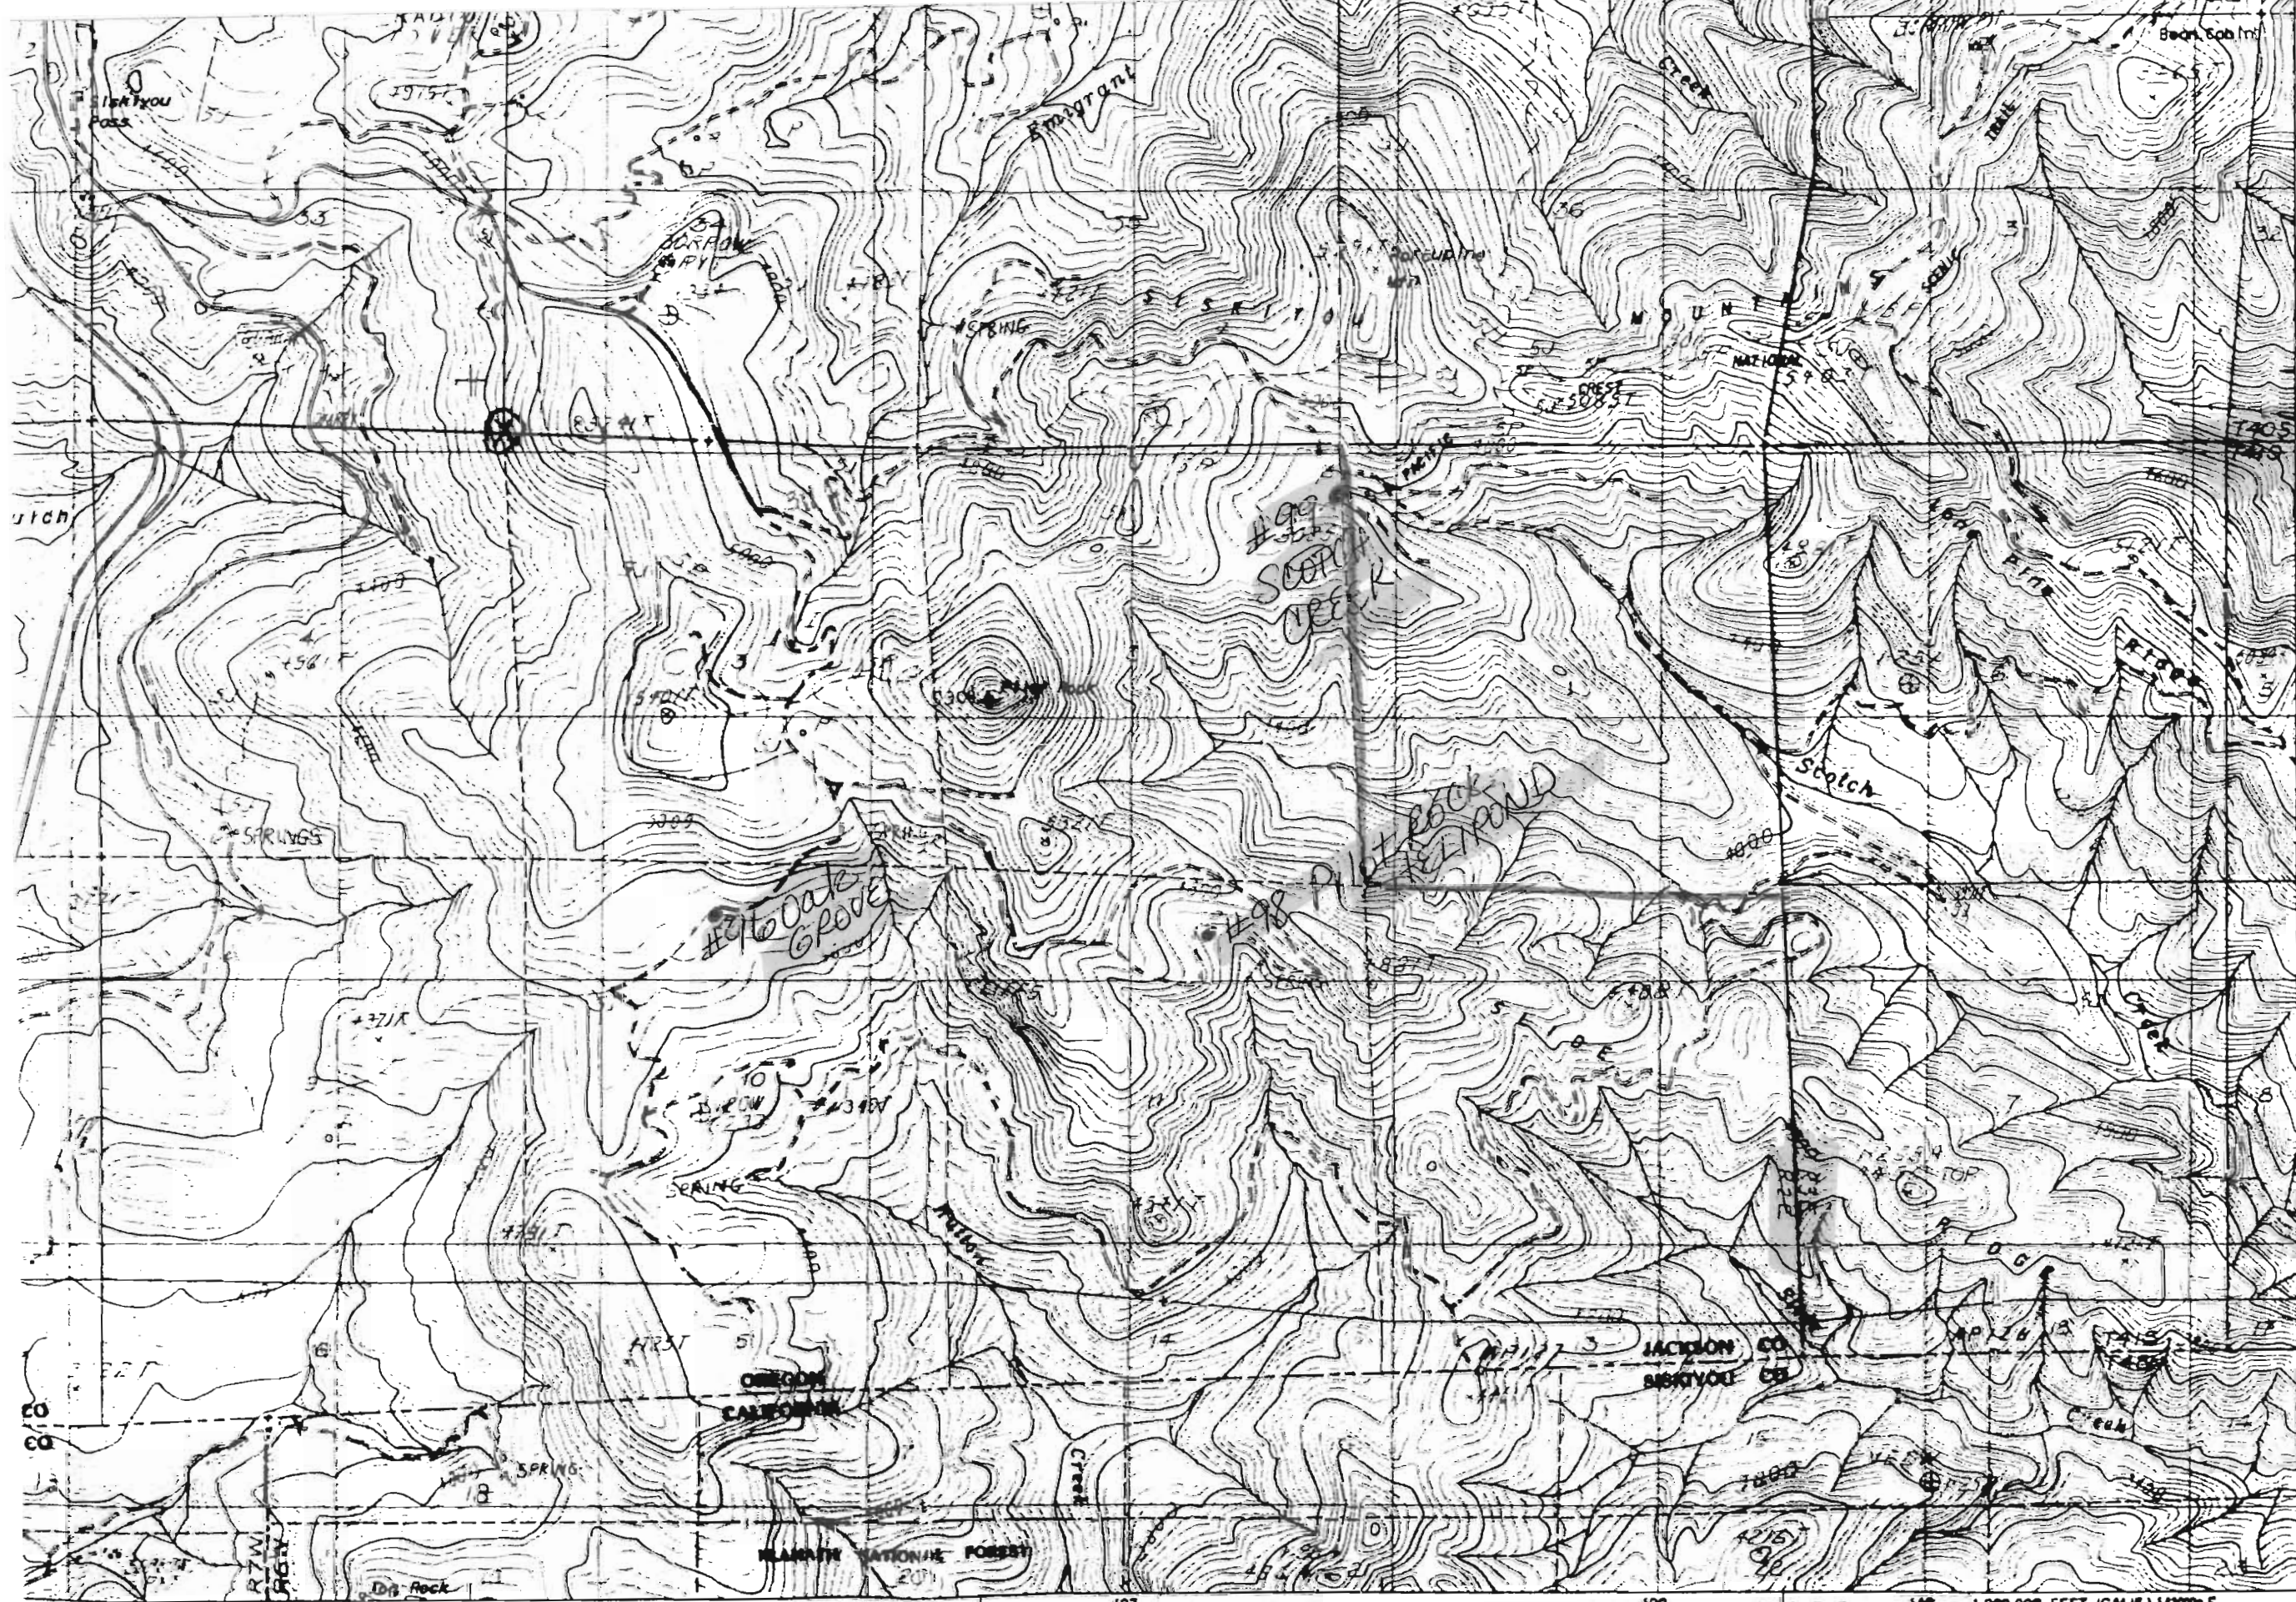

455
2' 3
454
453
452
451
450000 N
42° 00'

000 FEET (OREG.)




















SCALE 1:24 000

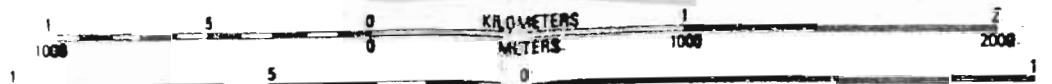

CERTIFICATE NO. 71447

ROAD LEGEND

Improved Road

Unimproved Road

Application No. 12-79242
Permit No.

3ICAL SURVEY
1988, NOS. 1800A
1988
1988
FORMAL CONIC
TOR... ZONE 18
A.C.