



466
469 5'
467
466
465
464
463
462
461

Application No. E-79244
Permit No.

71448

Scale = 1:2400

900 000 FEET
(CALIF.)

450000 N

OREGON
CALIFORNIA

JACKSON CO
SISKIYOU CO

BLANKET NATIONAL FOREST


Hyatt Reservoir, SW
Quad

Application No. R 79244
Permit No.

CERTIFICATE NO.

71448

1 010 000
FEET (CALIF)

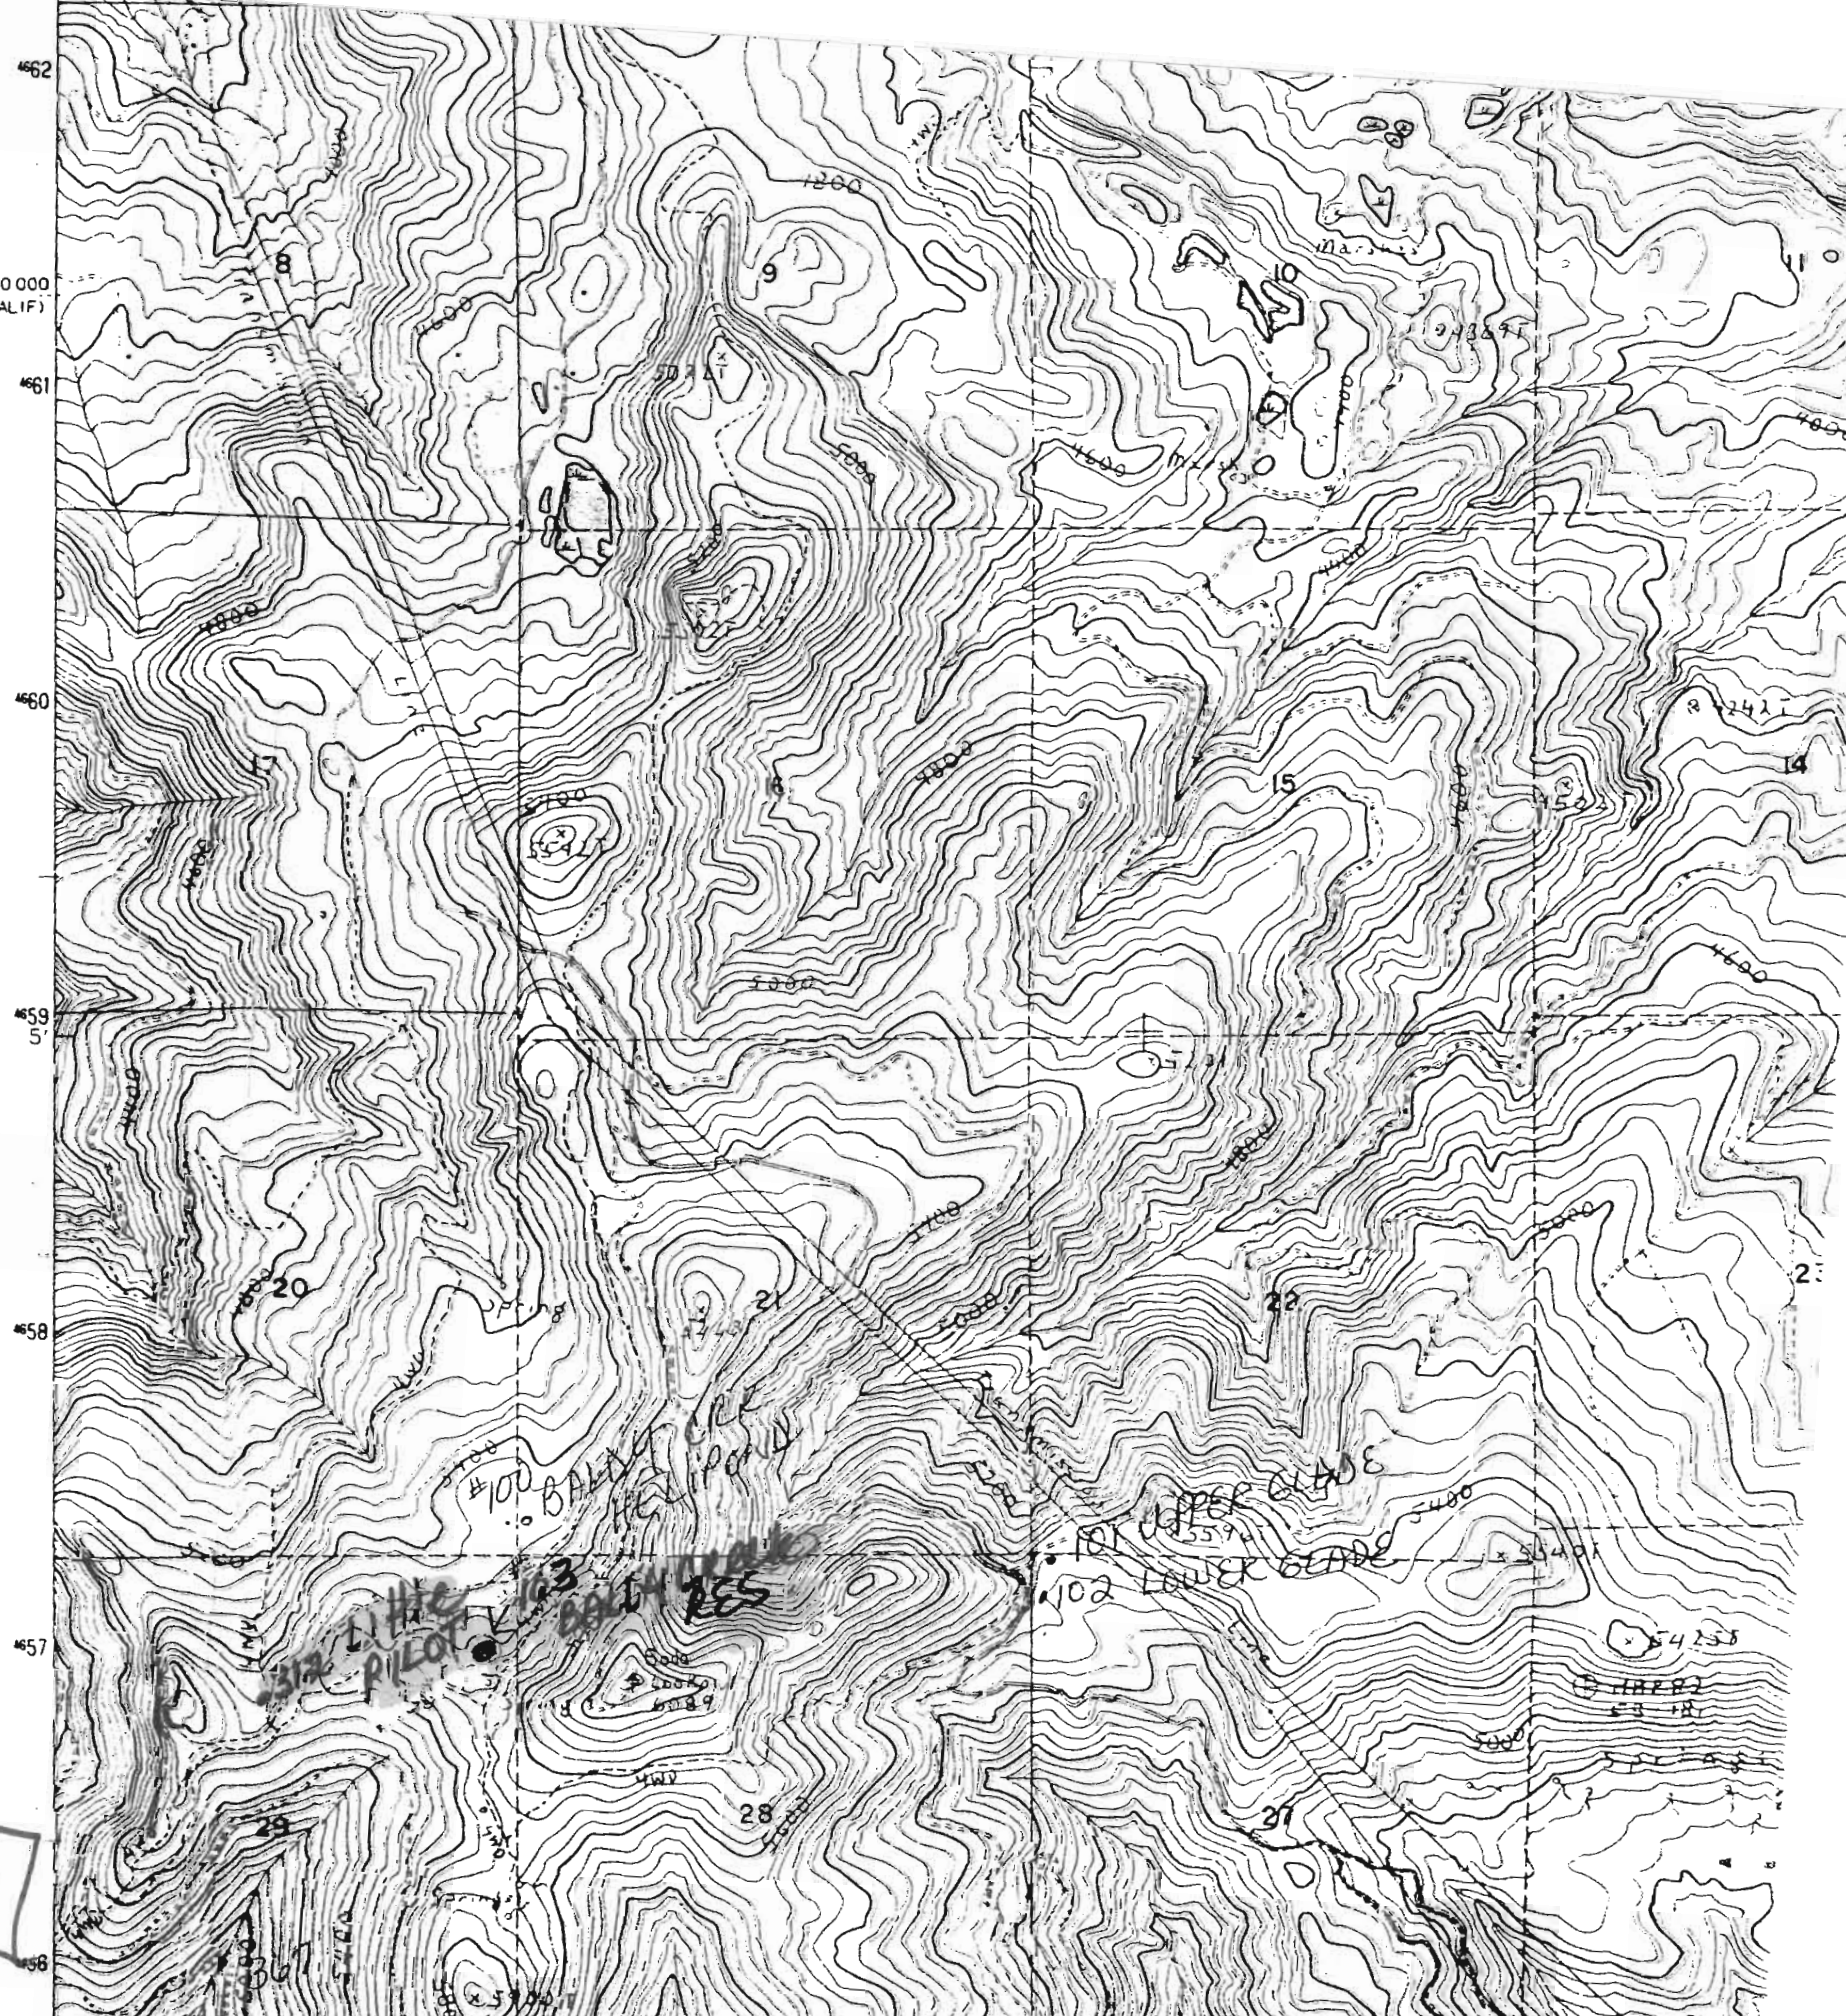

R3E

T40S

Scale = 1:24000