

Agate Nat
Soda Mtn

Scale = 1:24000

Hyatt Reservoir SW, Quad


SODA MOUNTAIN QUAD

Application No R-79248
Permit No.

71450

R3C

CERTIFICATE NO. 542000E 11870 000 FEET (CALIF) 544 27' 30" 545 546
42° 07' 30"

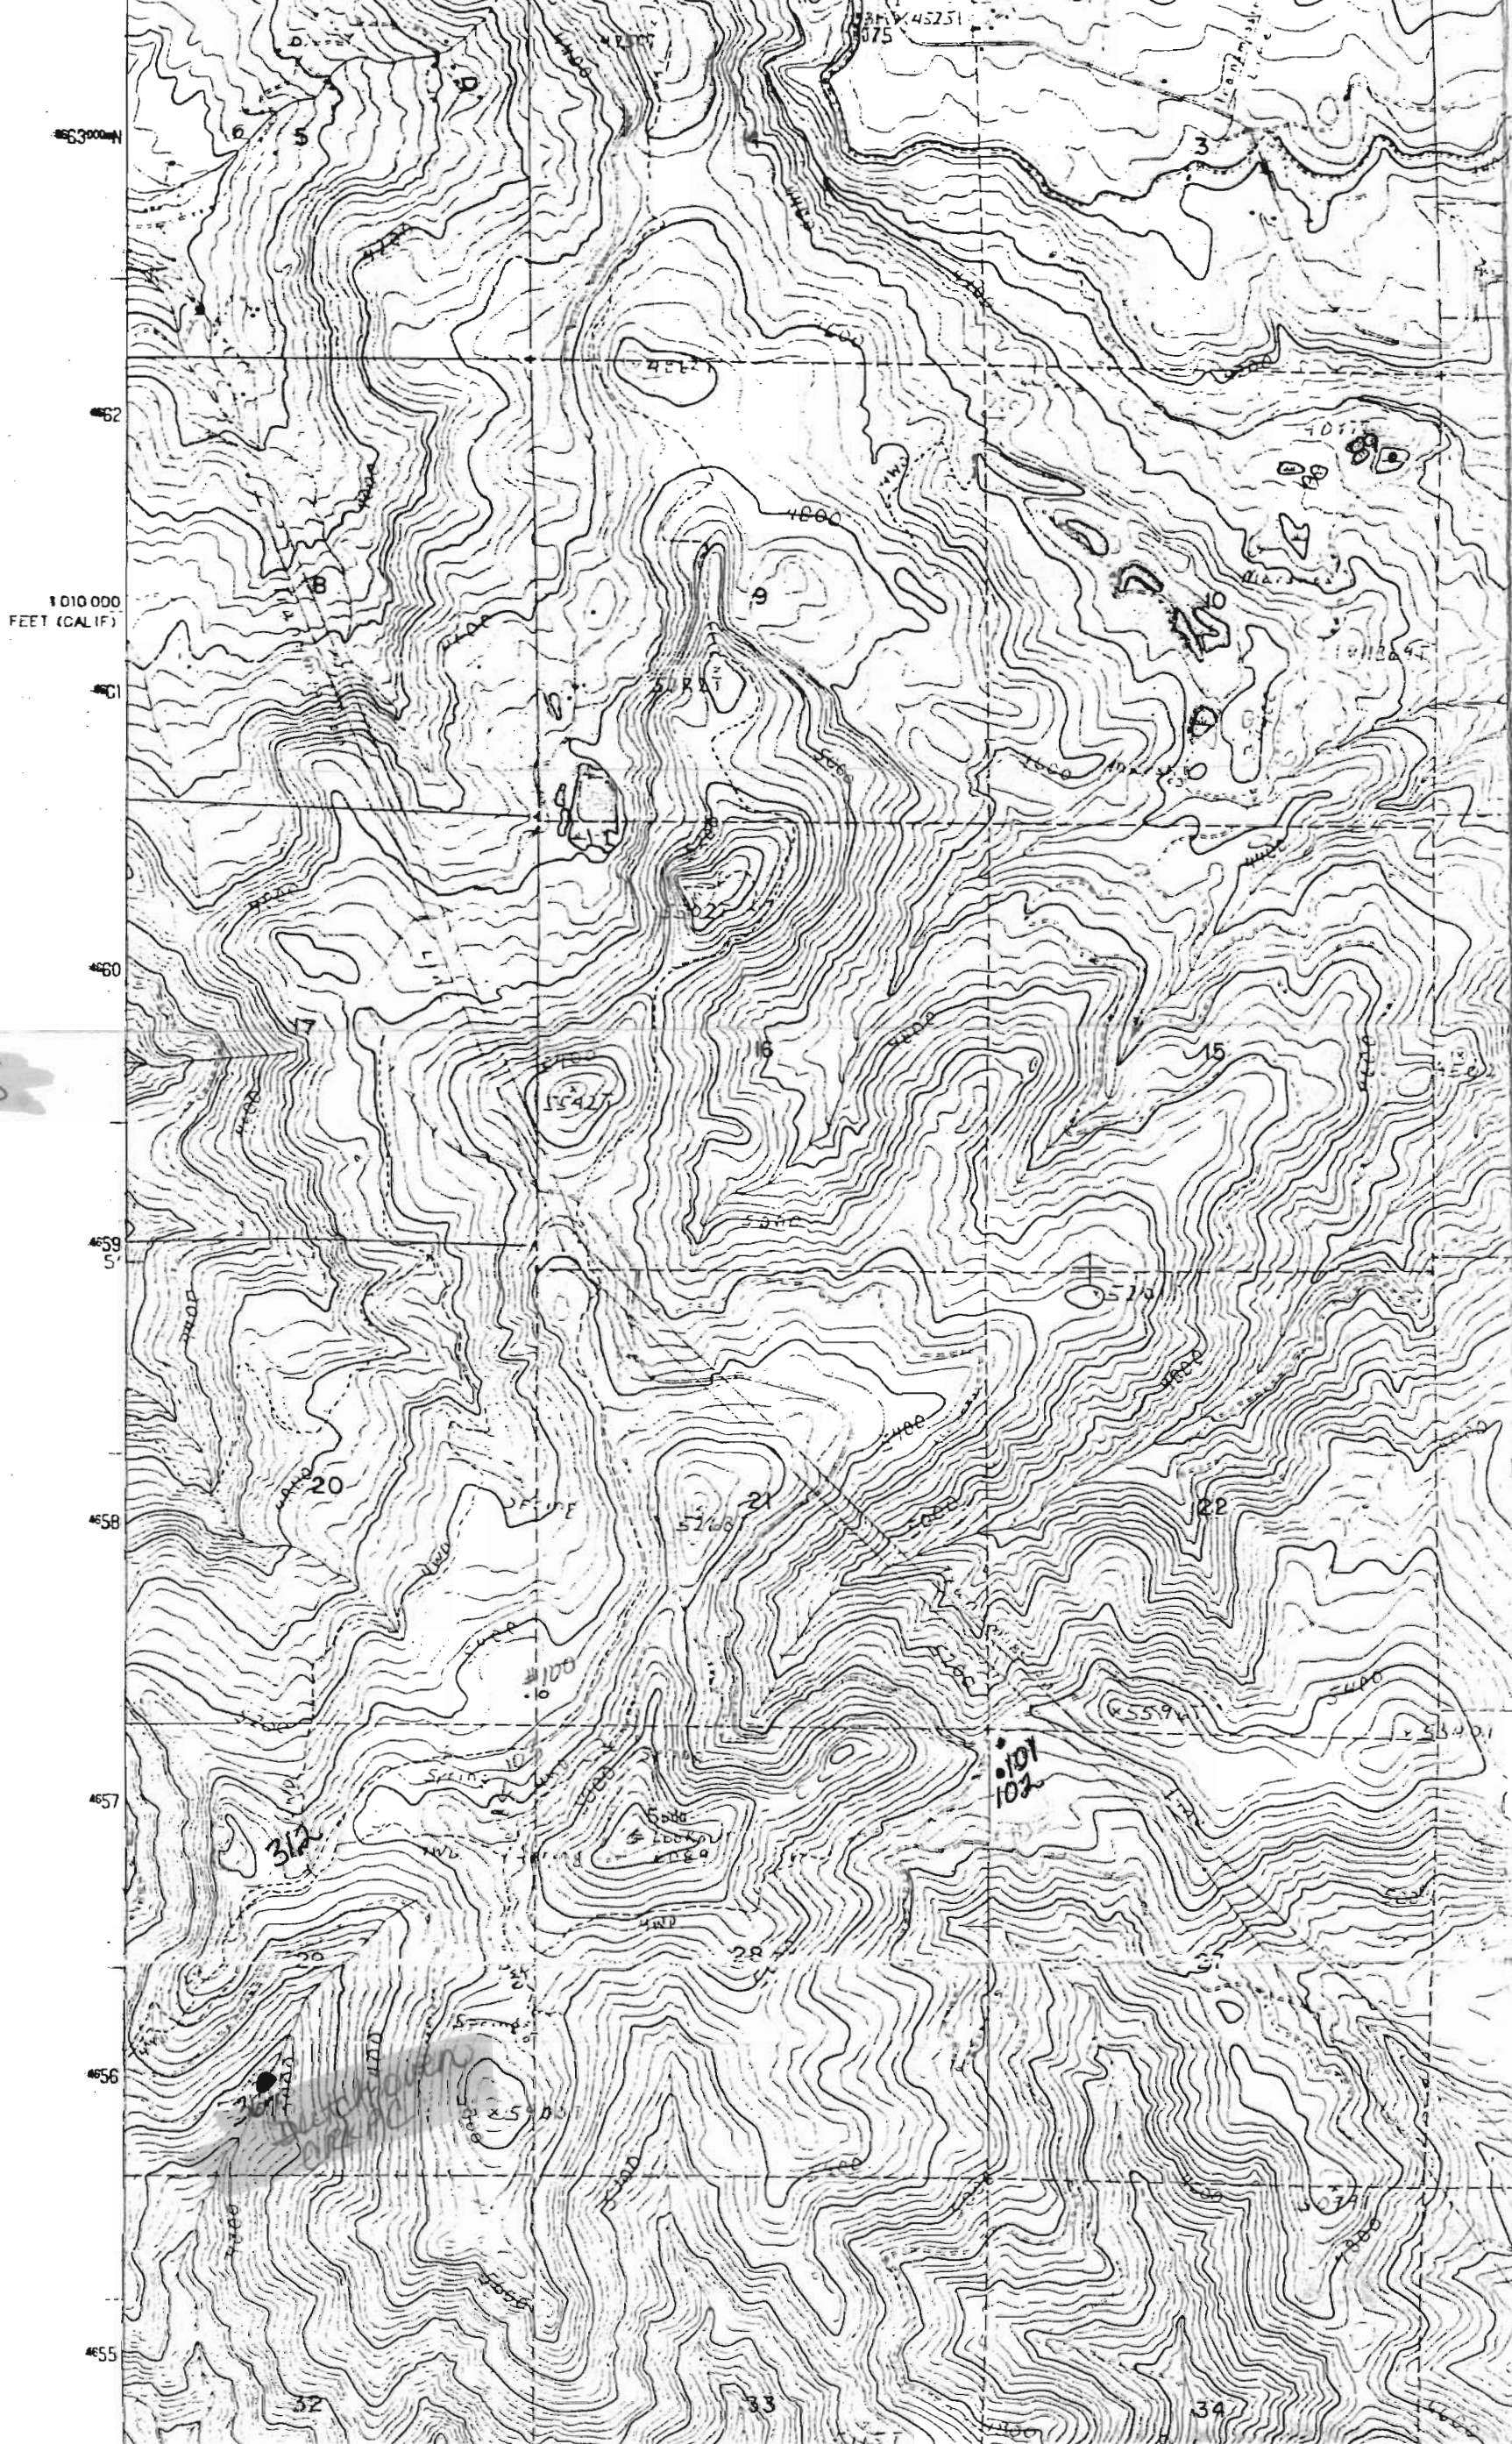

40S