


Scale 1:24,000

SQUAW LAKES QUADRANGLE
OREGON—CALIFORNIA
7.5 MINUTE SERIES (TOPOGRAPHIC)

← T403 →

UNITED STATES
DEPARTMENT OF THE INTERIOR
GEOLOGICAL SURVEY

DUTCHMAN PEAK QUAD.

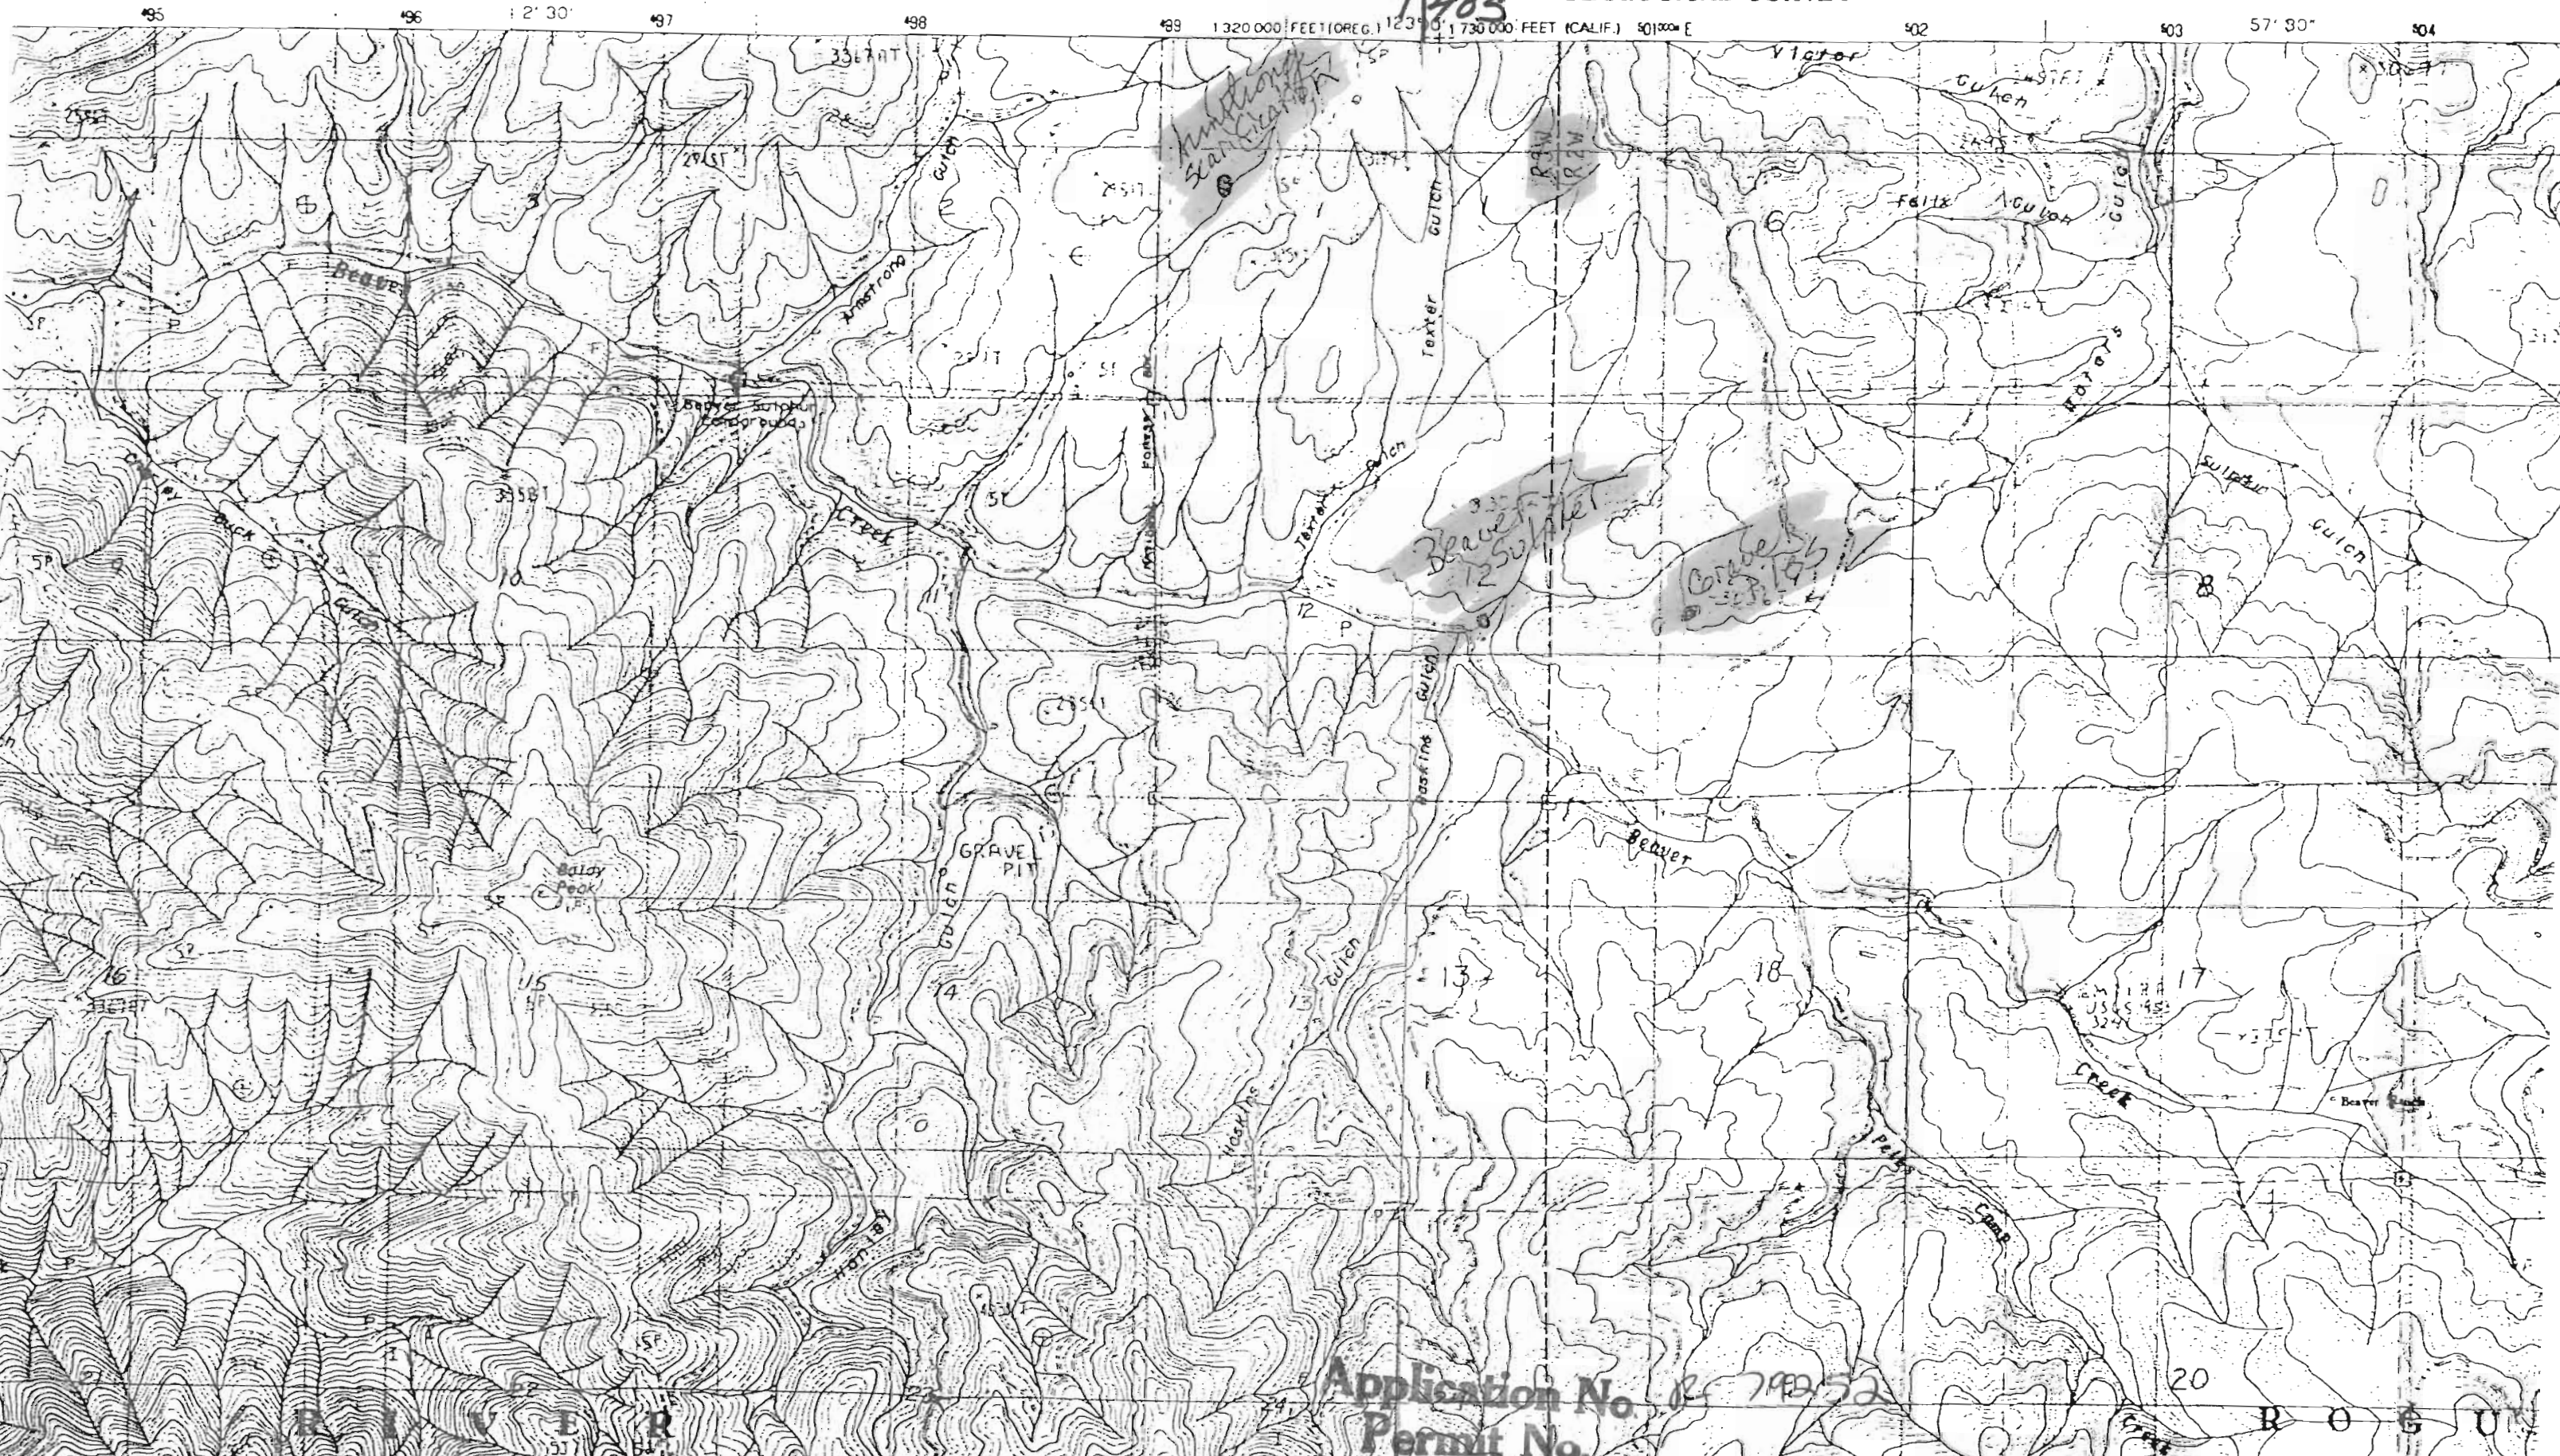


Application No. 12-79252

Permit No.

20

R O G U

71452

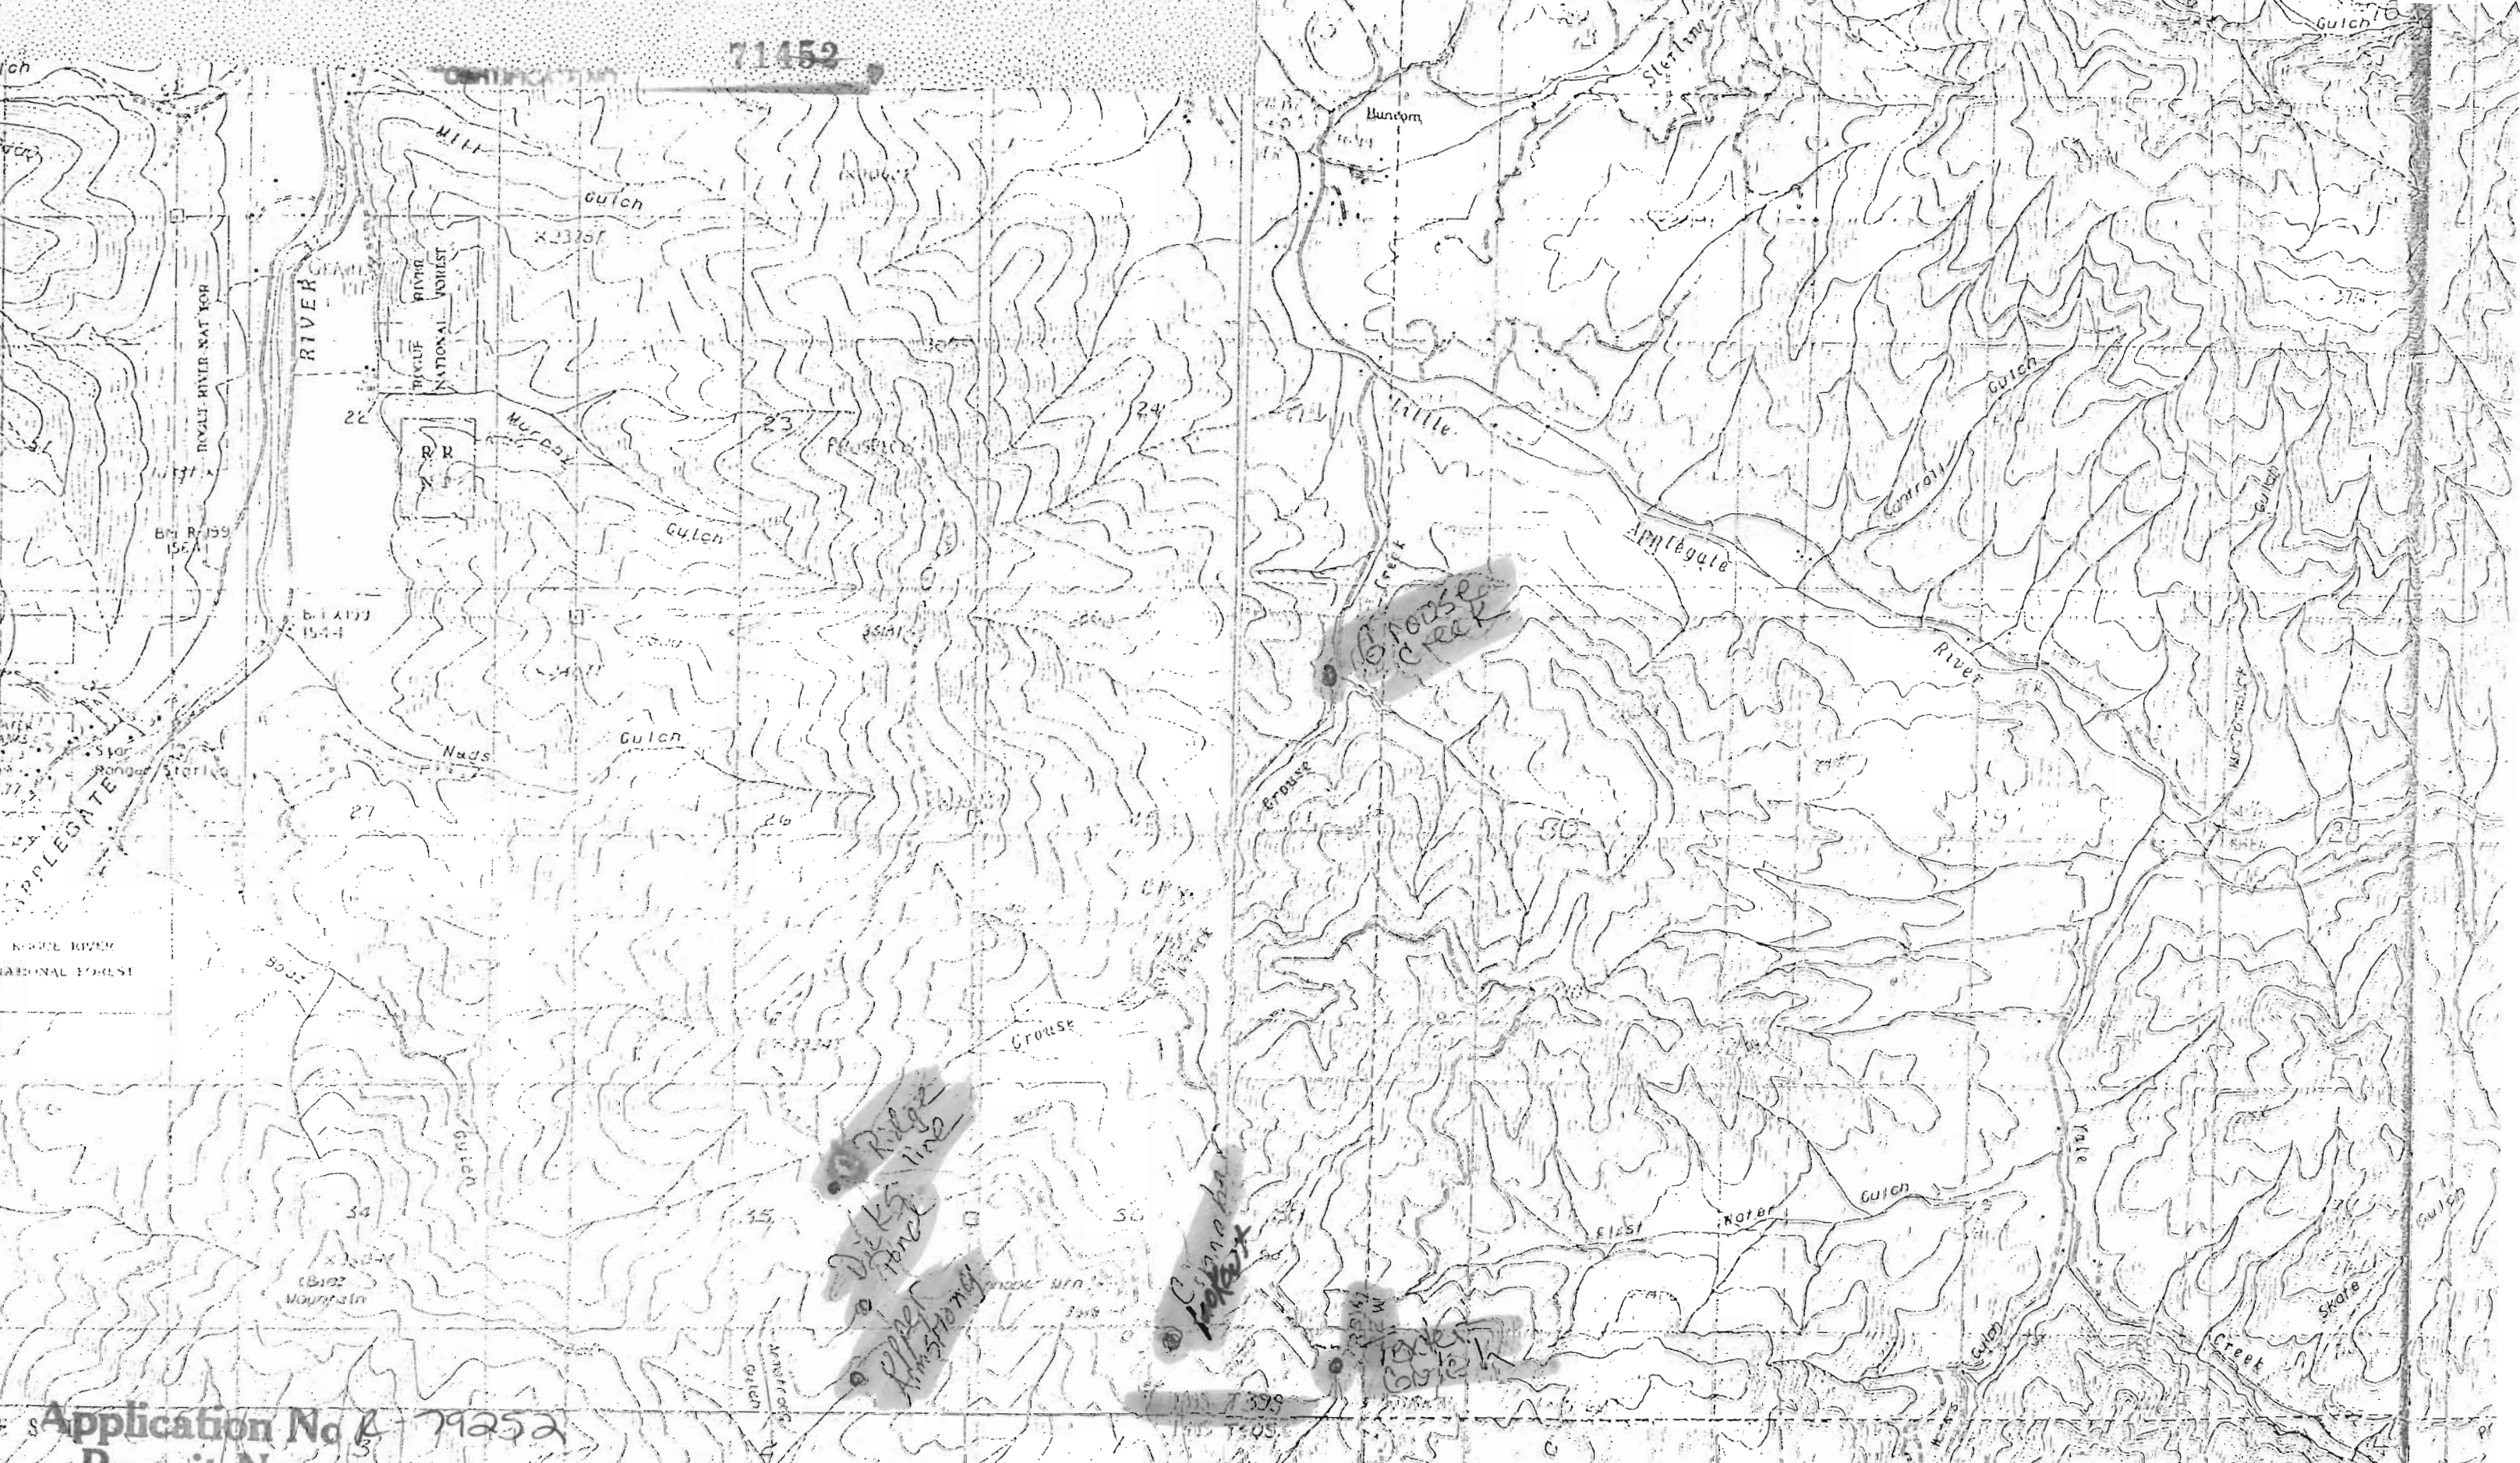

Application No. **A-79252**
 Permit No. **3**

RUCH QUADRANGLE

ROAD LEGEND

Improved Road

Scale **1:2400**

PRODUCED BY THE UNITED STATES GEOLOGICAL SURVEY
 CONTROL BY USGS NOS. 500A
 COMPILED FROM AERIAL PHOTOGRAPHS TAKEN 1976
 FIELD CHECKED 1979 MAP SCALE 1:2400

STERLING CREEK QUADRANGLE

SCALE 1:2400