

Application No. R-79264
Permit No.


[scale = 1:24000]
71458

R4W
R3W

CERTIFICATE NO. _____

UNITED STATES
DEPARTMENT OF THE INTERIOR
GEOLOGICAL SURVEY

RUCH QUADRANGLE

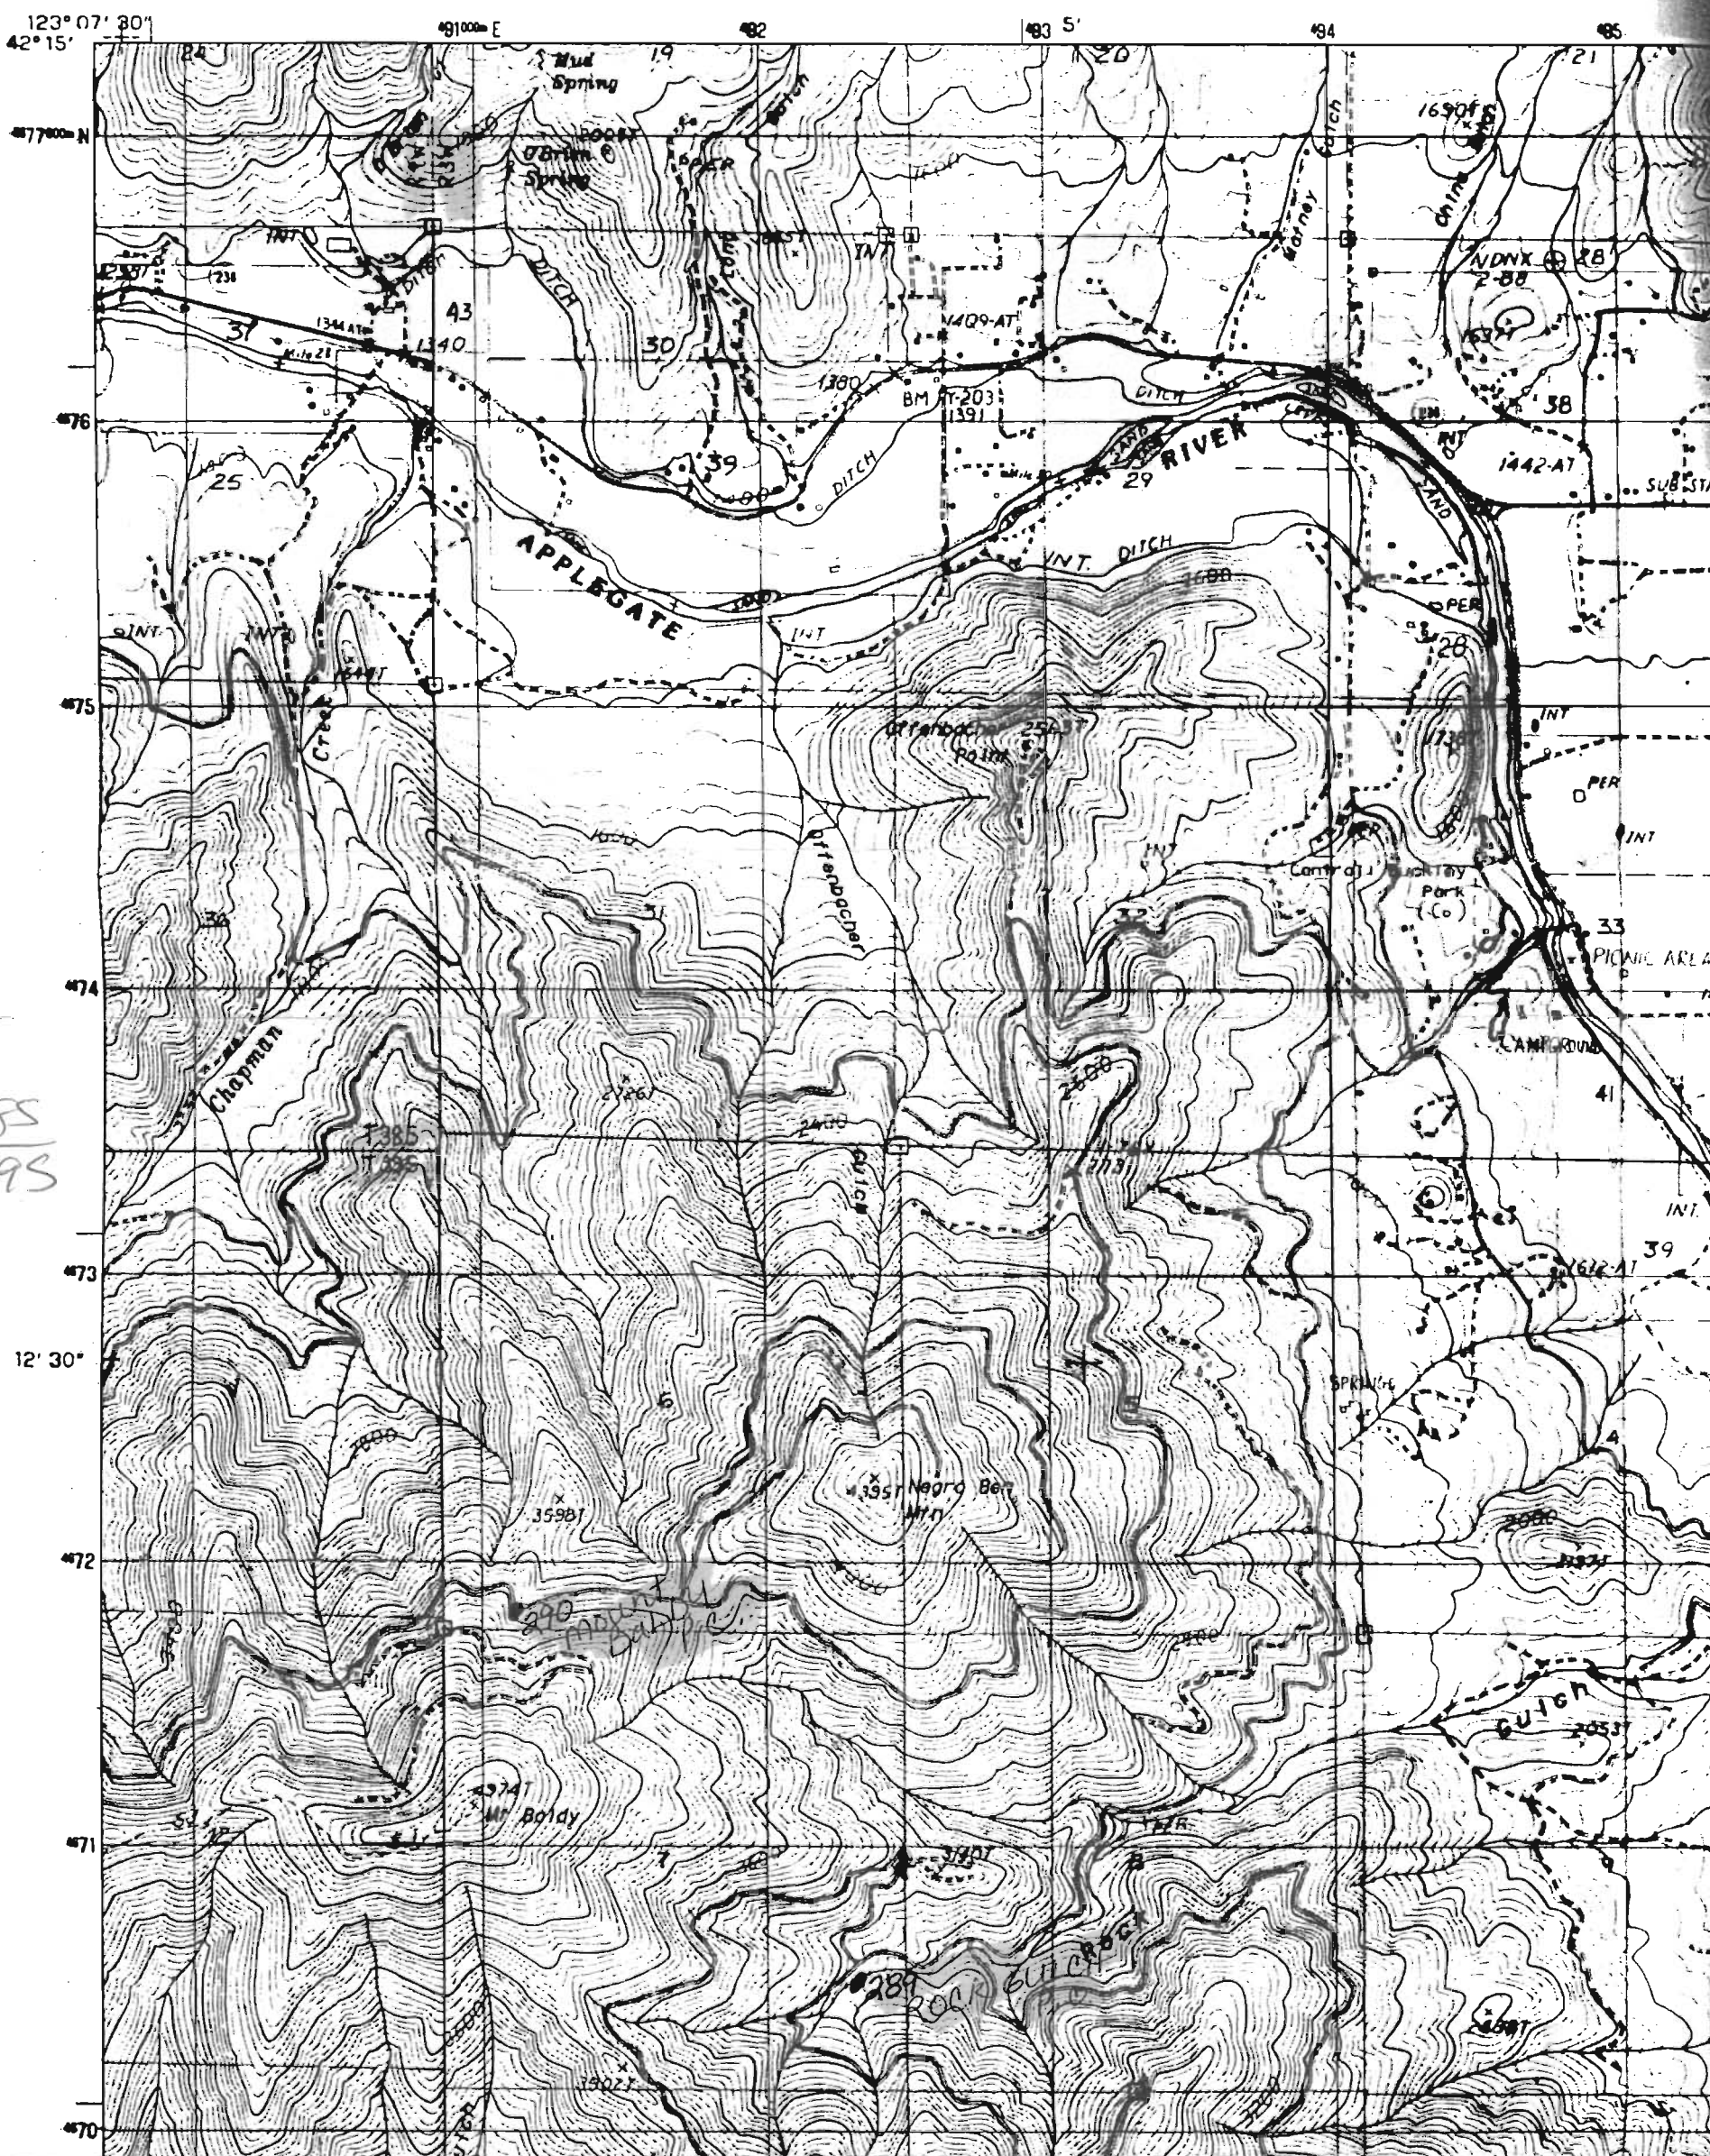

T385
T395


271458 TALLOW BOX QUADRANGLE

Application No. R 9264
Permit No.

1738 R3
38 R3

R355
R393

alder
pocket
P.C.

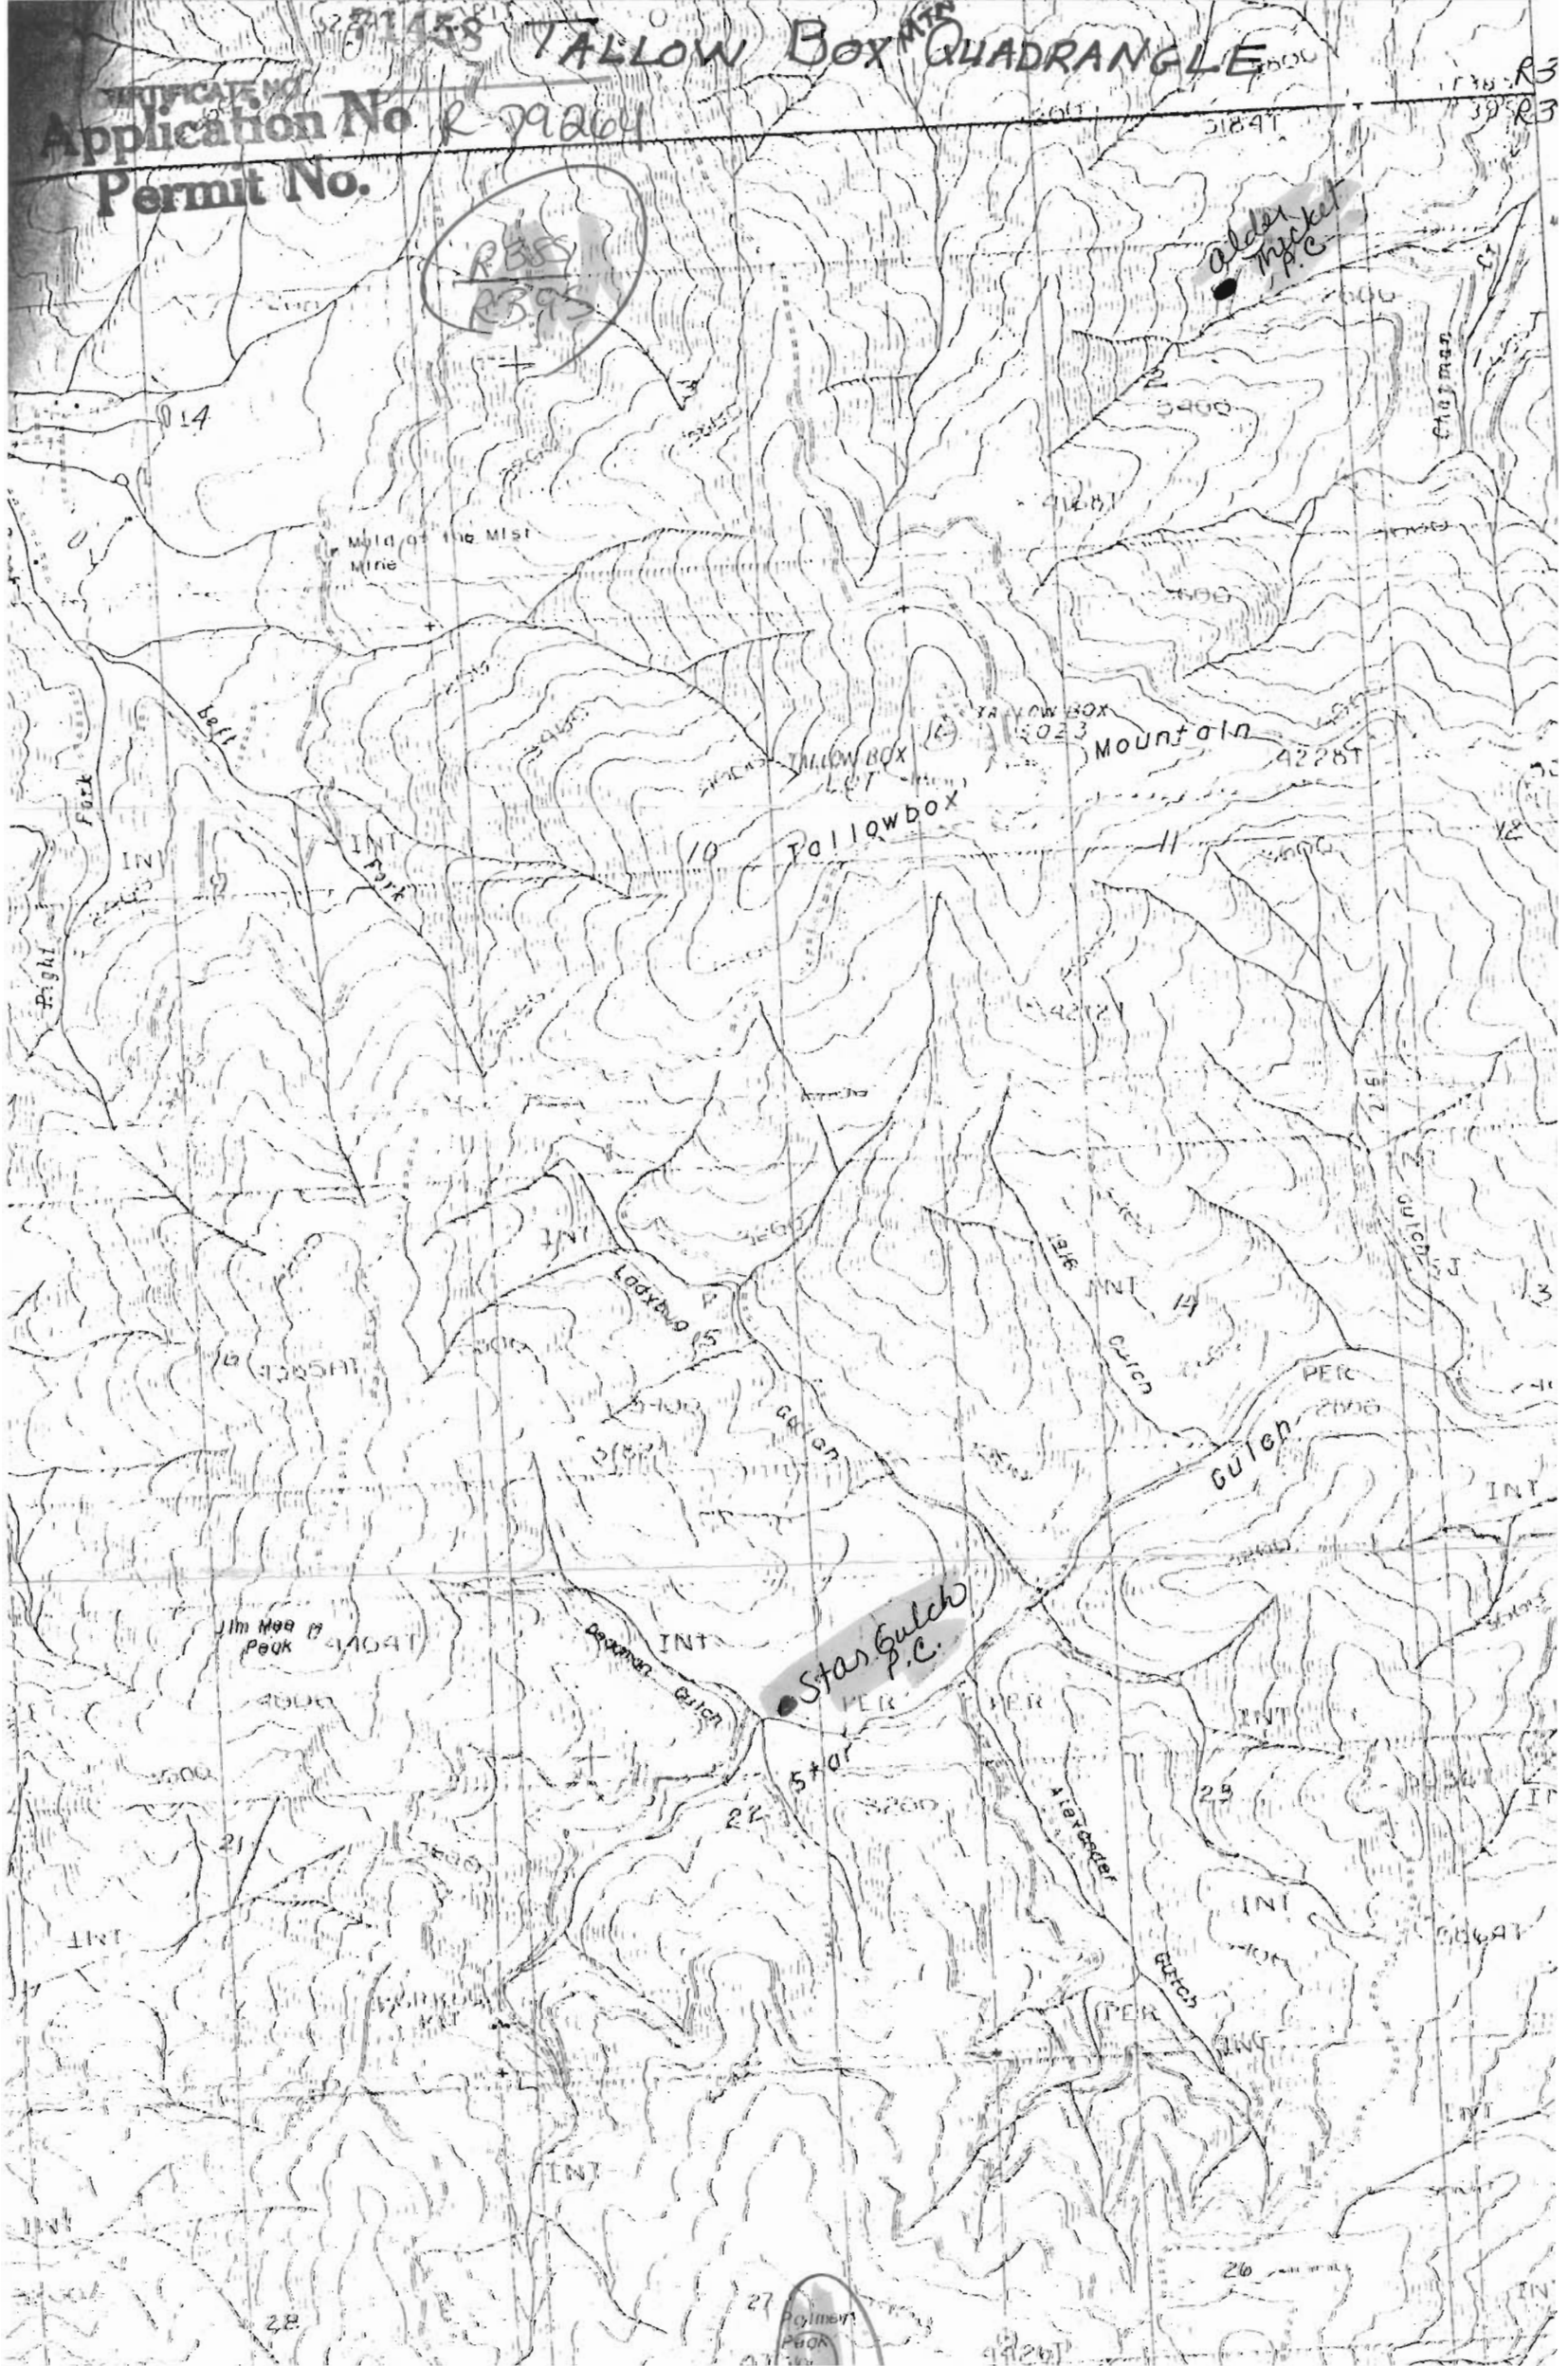

Maid of the Mist Mine

TALLOW BOX MOUNTAIN
42281

Tallowbox

Star Gulch
P.C.

Jim Mear Peak

5701

29

27

26

28

44261