


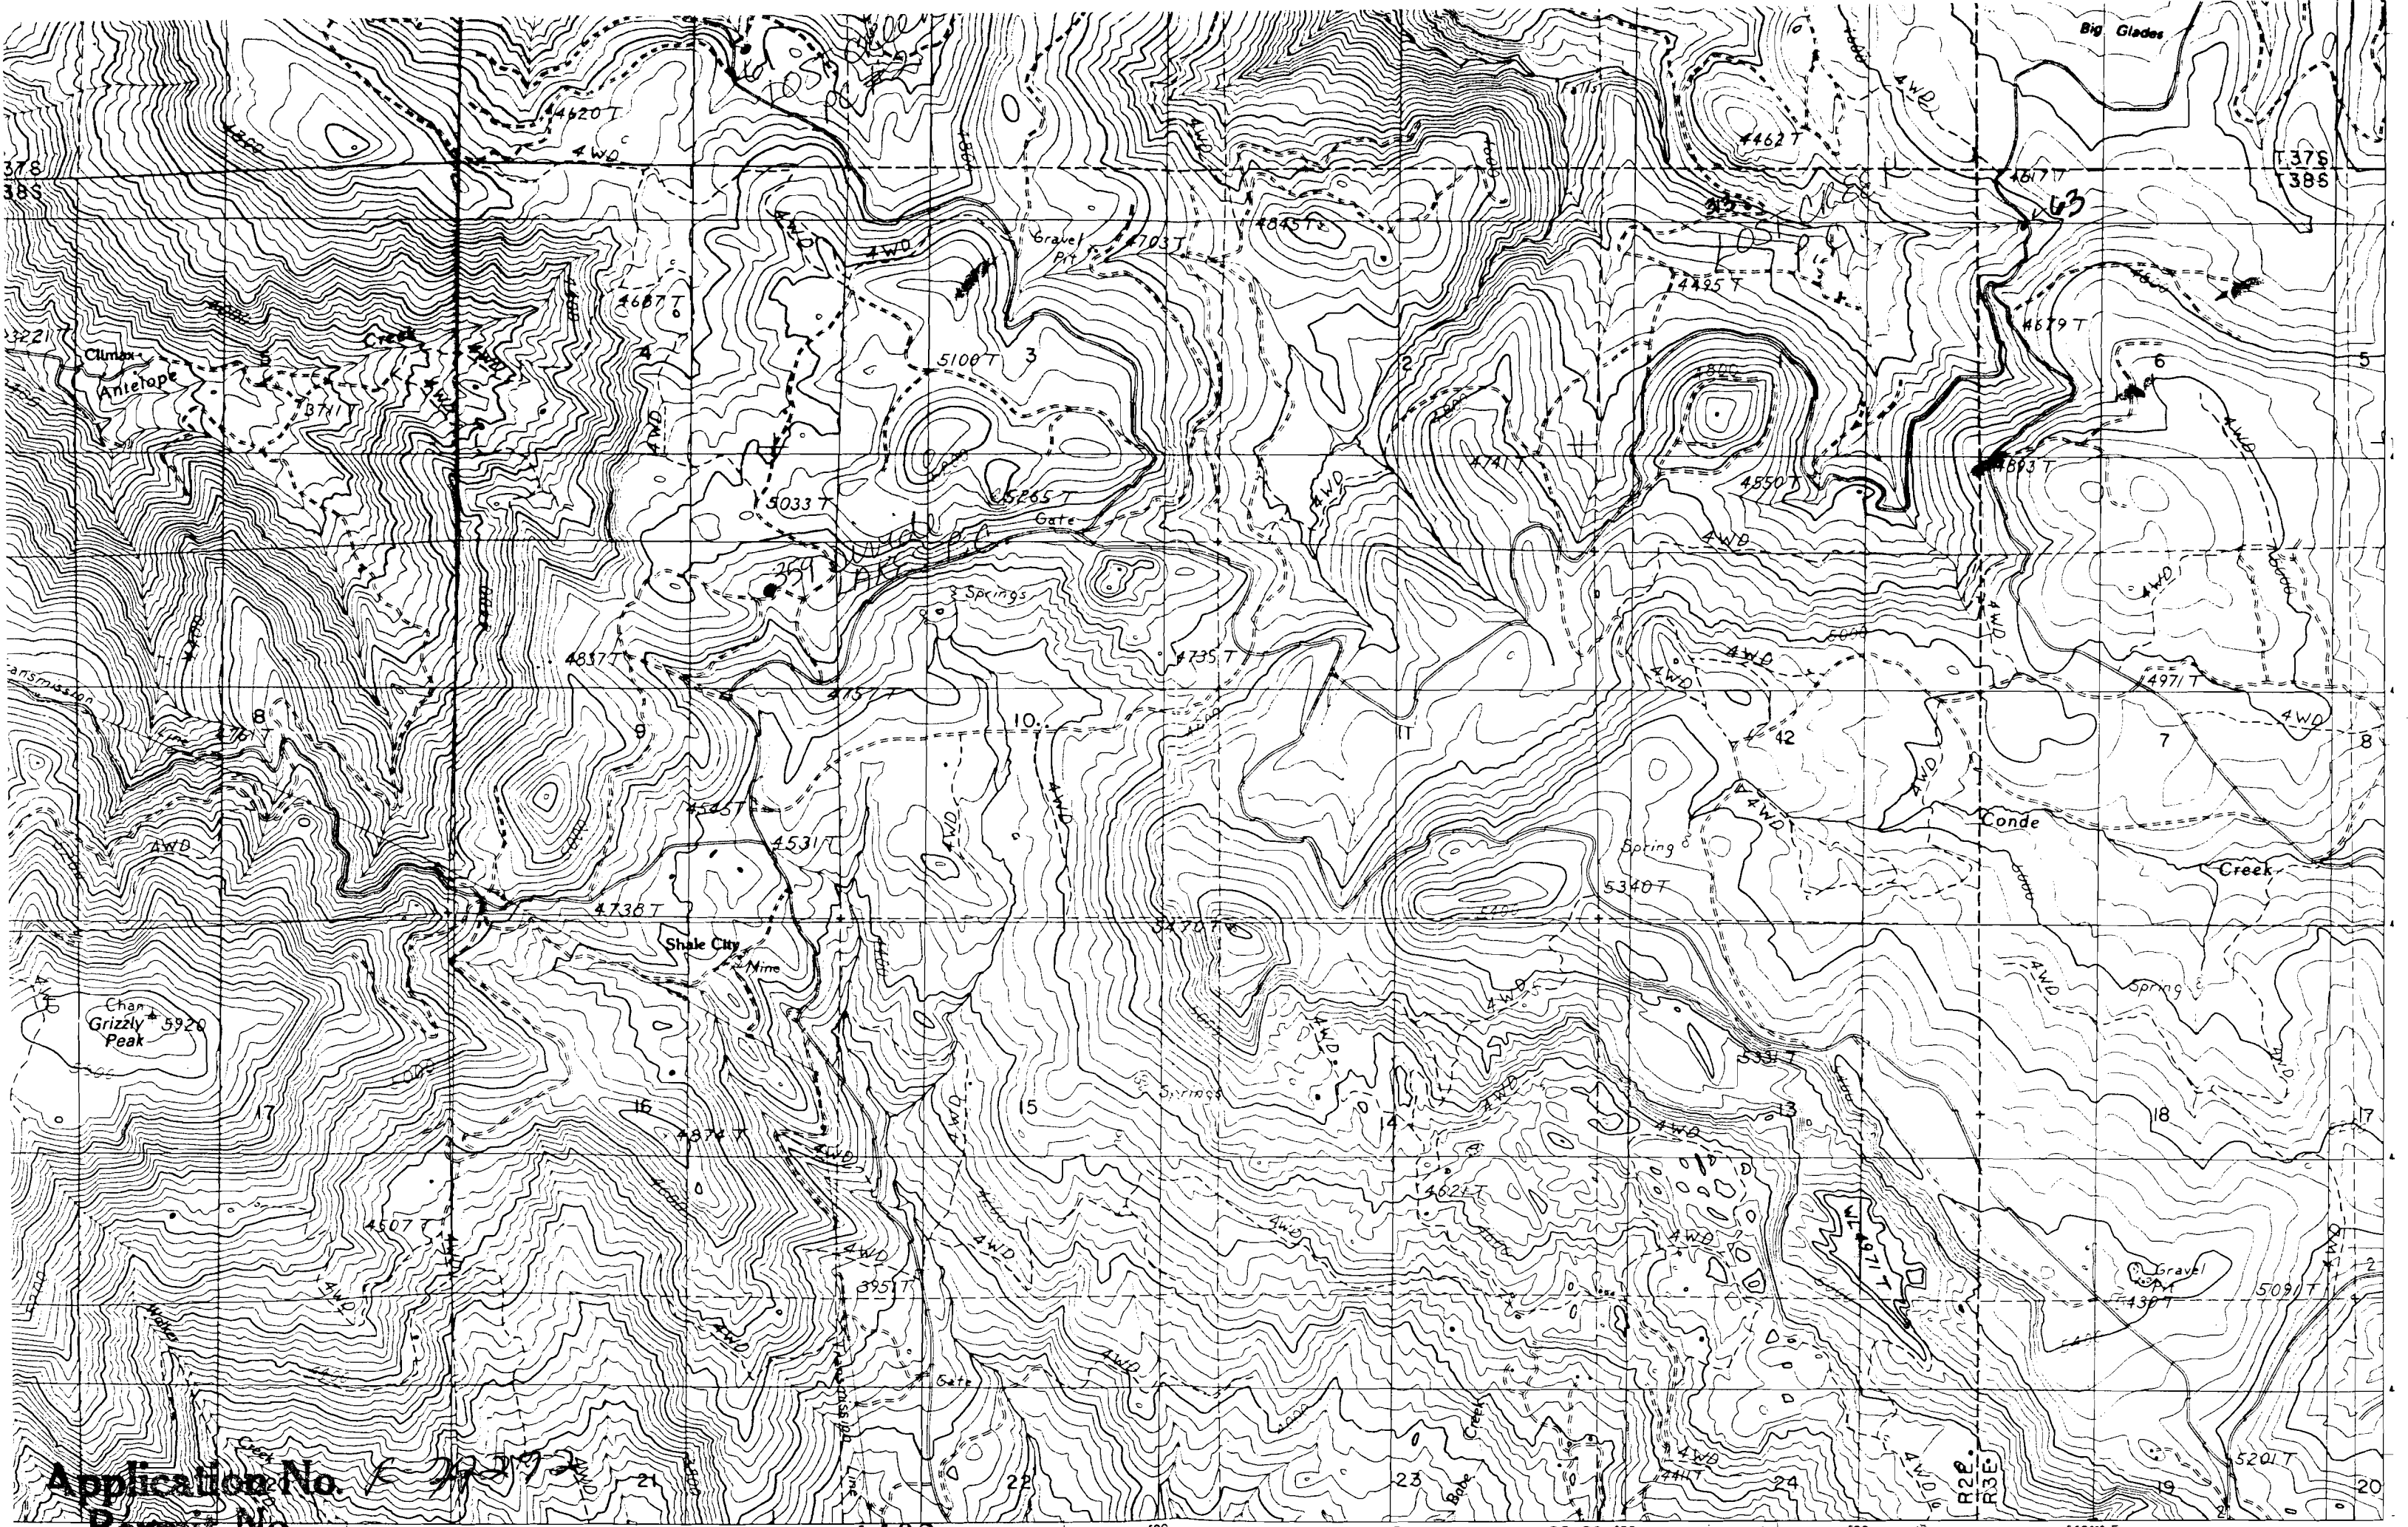

Application No. *6-29272*
Permit No. *11430000*

PRODUCED BY THE UNITED STATES GEOLOGICAL SURVEY
CONTROL BY USGS, NODMMA

CERTIFICATE NO.

SCALE 1:24 000

INTERIOR-GEOLOGICAL SURVEY, RESTON VIRGINIA-1990

Grizzly Peak, Dry. Quadrangle