


R4E

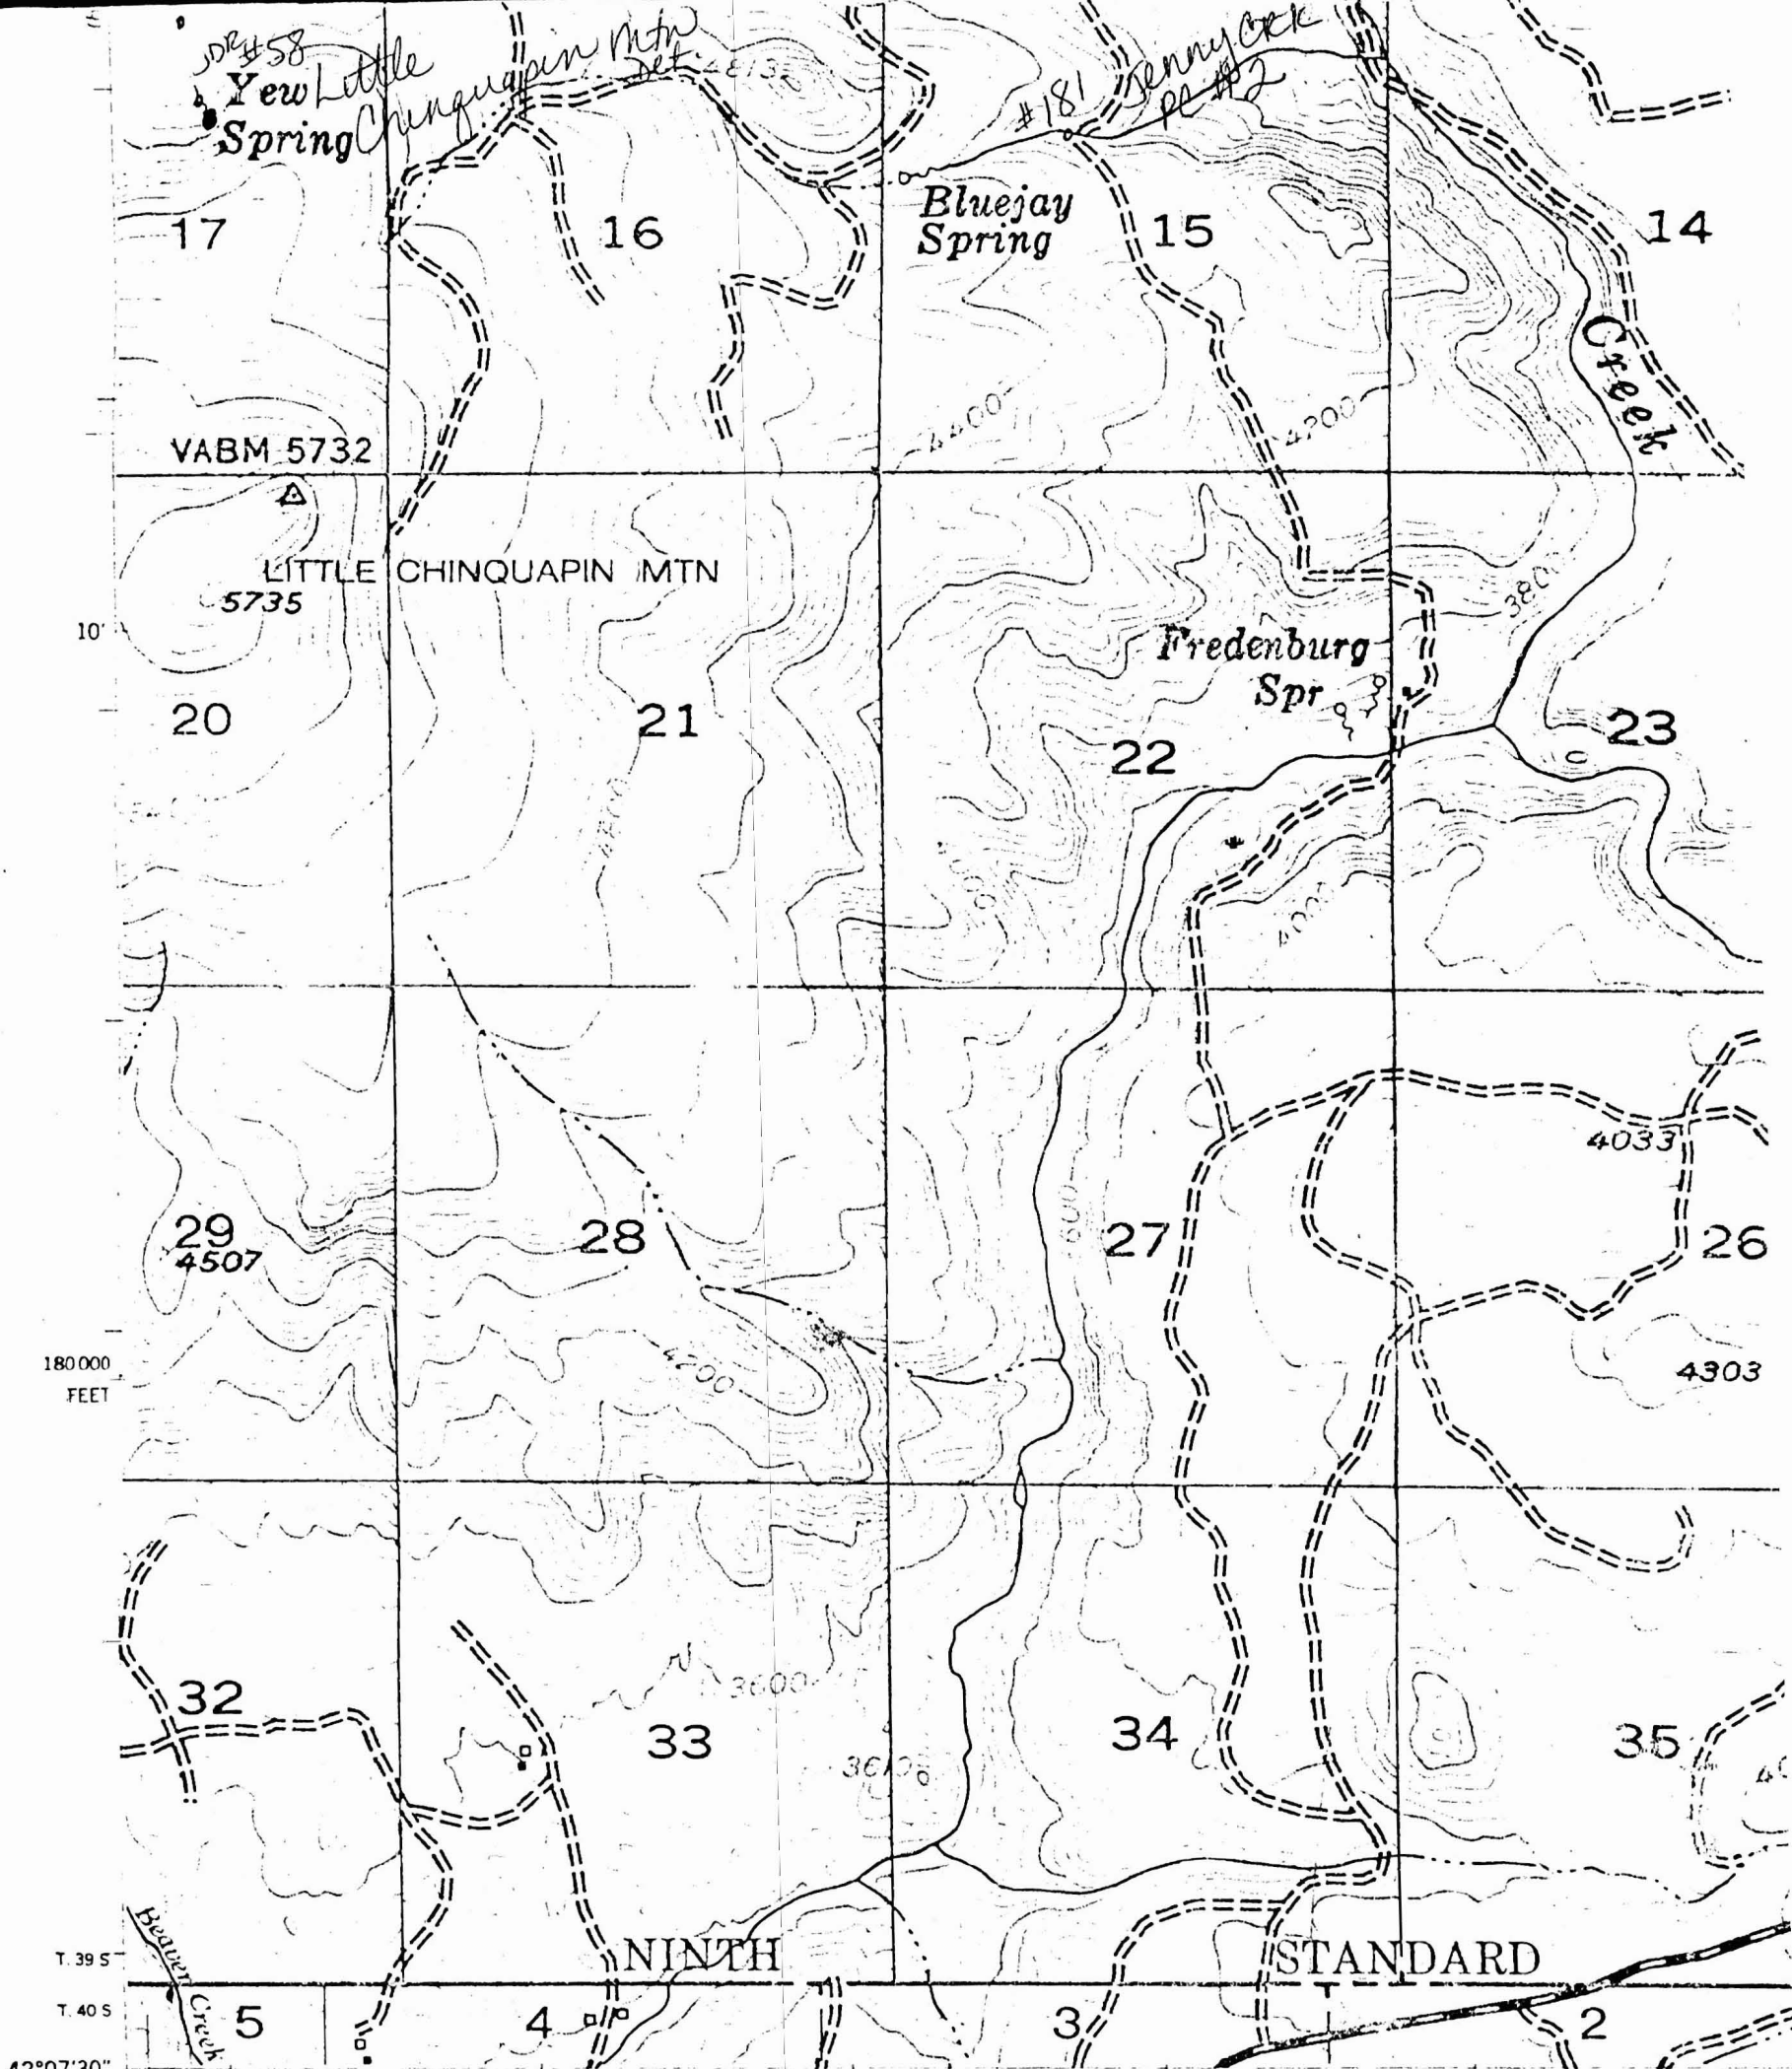

Base map prepared by the U.S. Geological Survey
Control by USGS and USC&GS
Topography by photogrammetric methods from aerial
photographs taken 1953. Field check 1955
Polyconic projection. 1927 North American datum
10,000-foot grid based on Oregon coordinate system, south zone
1000-meter Universal Transverse Mercator grid ticks,
zone 10, shown in blue.
INTERMEDIATE EDITION
Modification to USGS base map prepared by the
Geometronics Service Center from 1930 aerial photography
and 1982 correction guides furnished by the
Pacific Northwest Region.
Mapnet revised according to additional Forest
Service evidence.

[Scale = 1:24,000]

UTM GRID AND 1982
MAGNETIC NORTH
DECLINATION AT
CENTER OF SHEET

Hyatt Reservoir, NE
Quadrangle

- LEGEND
- National Forest Boundary
 - Alienated Land Within the National Forest Boundary as of 1981
 - Special Area Boundary
 - TOWNSHIP AND SECTION LINE CLASSIFICATION
 - Surveyed, Location Reliable
 - Surveyed, Location Approximate
 - Unsurveyed, Protraction by BLM

"CERTIFICATE NO. 7-166"
Application No. R-79280
Permit No.