


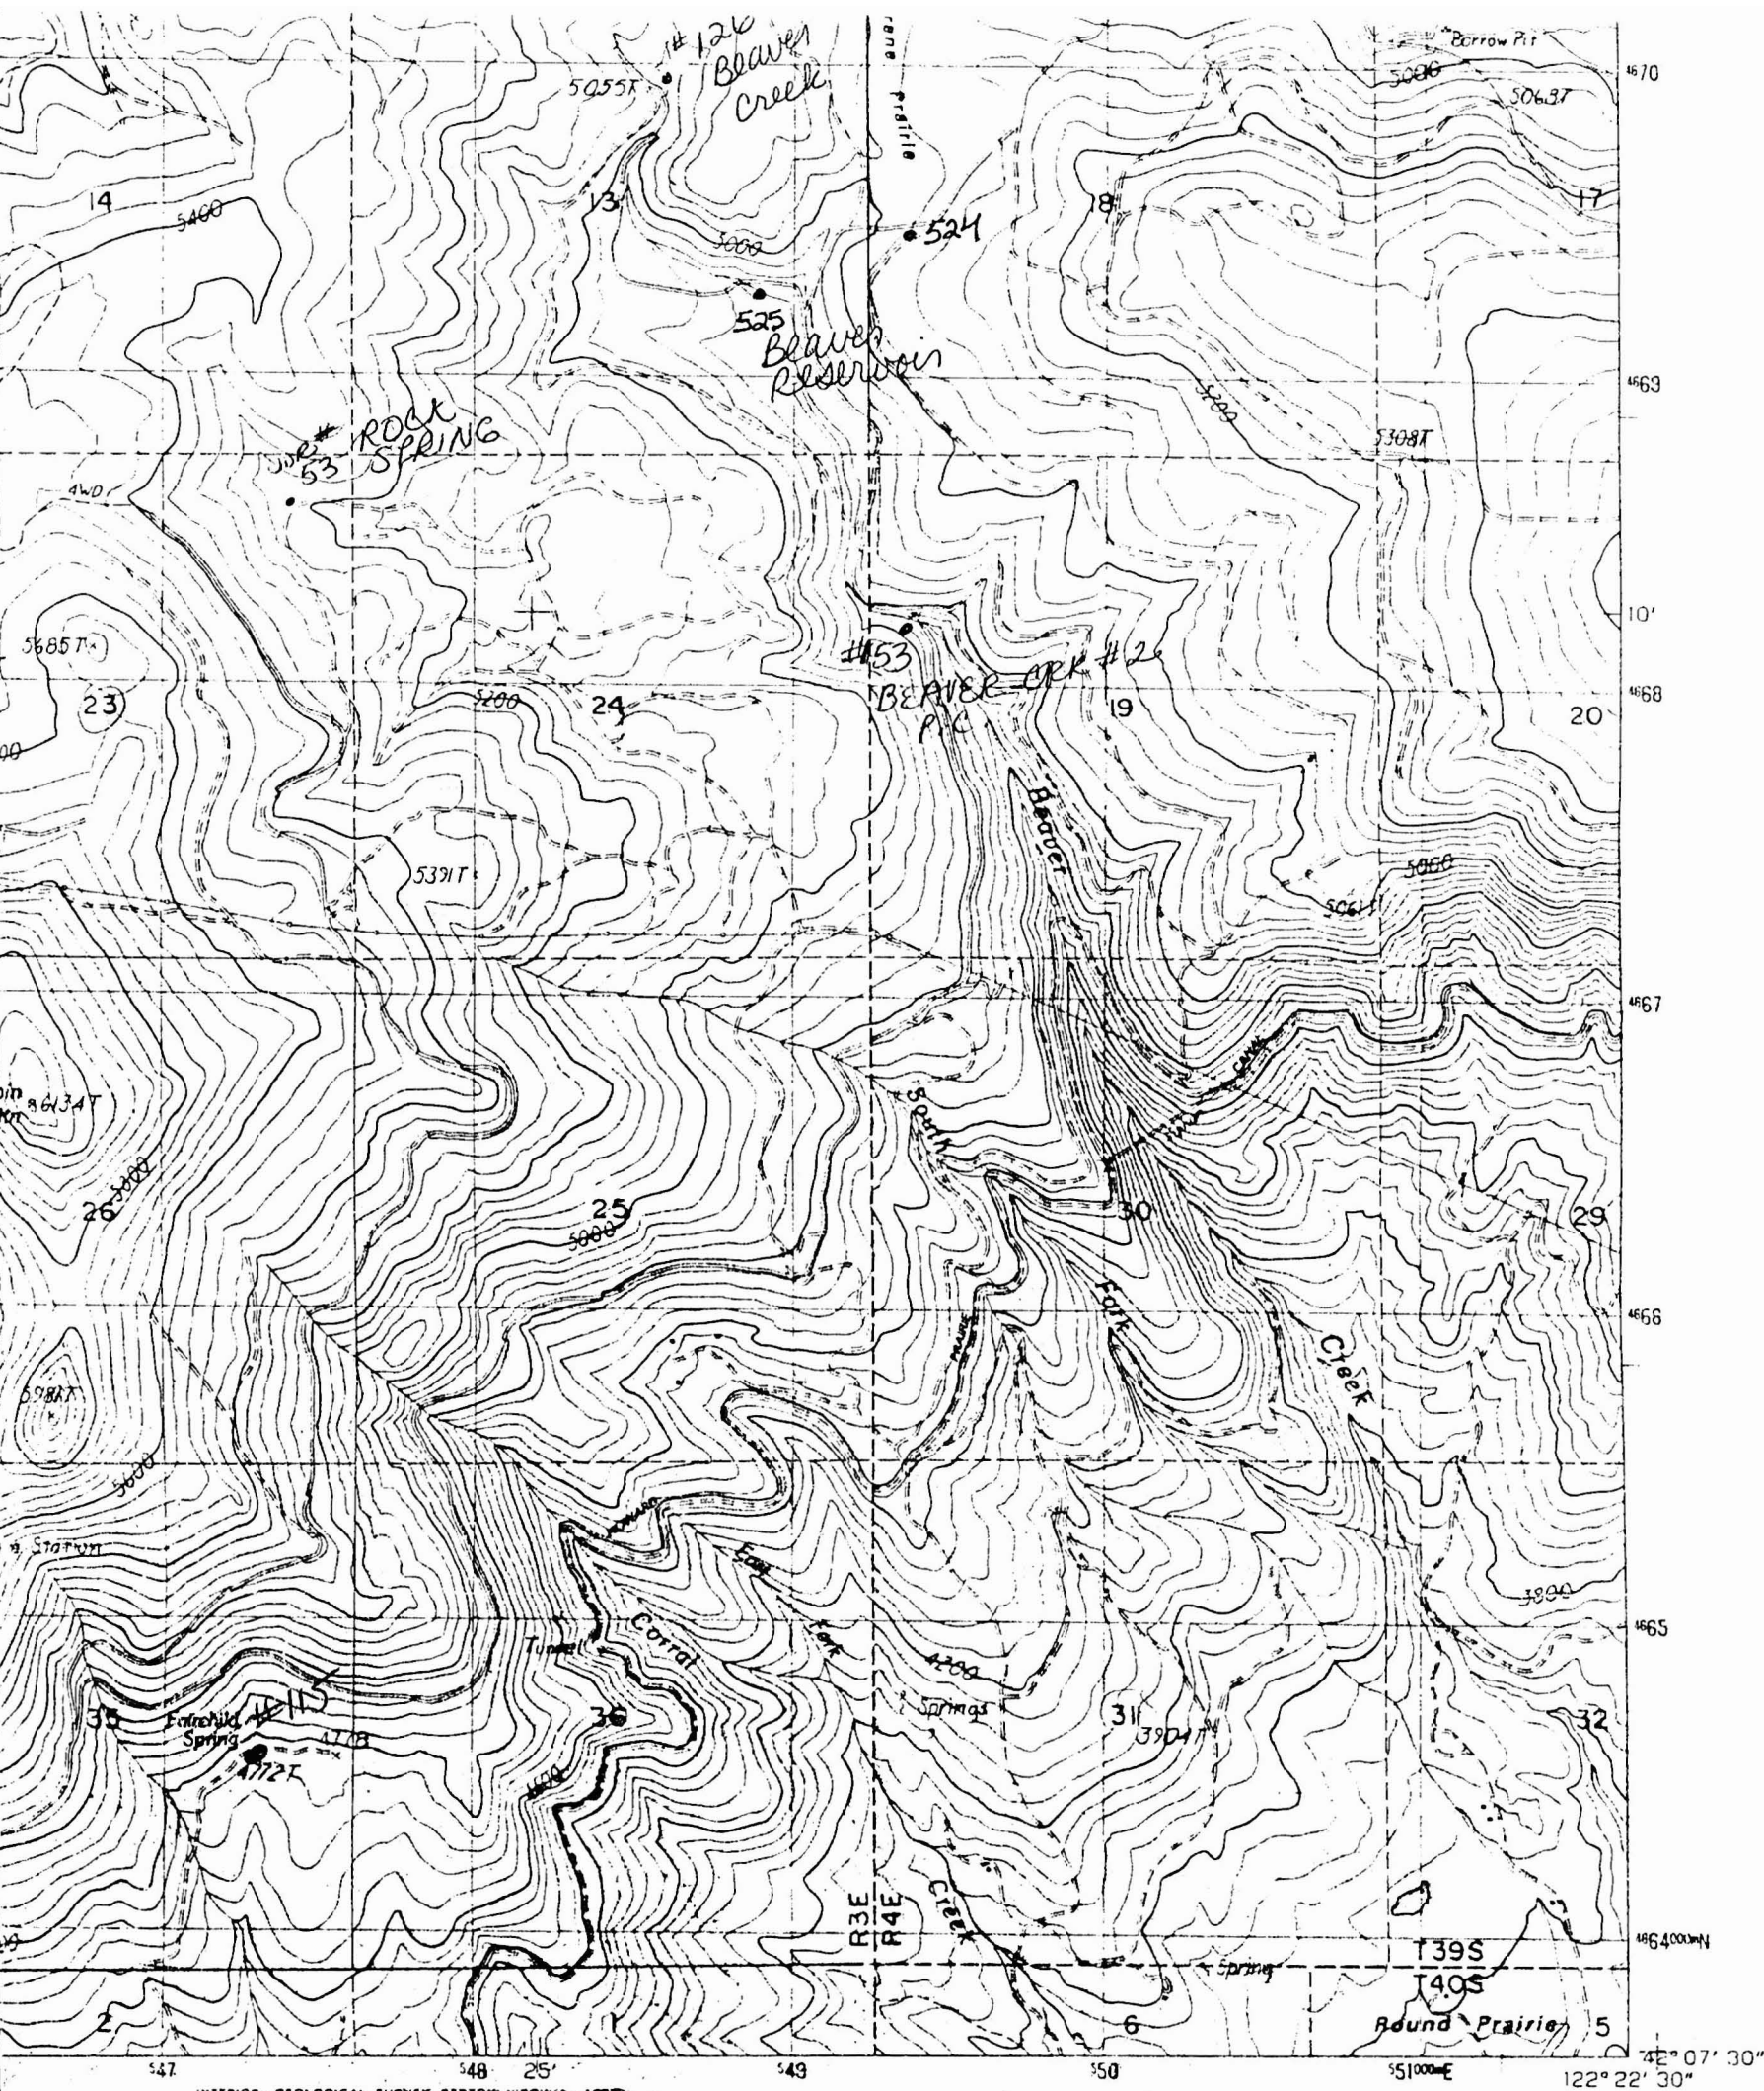

1:24 000

METERS
1 2
1000 2000

FEET
0 5000 6000 7000 8000 9000 10 000

INTERVAL 40 FEET

TO THE NEAREST 0.1 FOOT
TO THE NEAREST FOOT
Multiply by 3.2808
Multiply by 8.3043

MAP ACCURACY STANDARDS
COLORADO 80225, OR RESTON, VIRGINIA 17092

OREGON

QUADRANGLE LOCATION

1	2	3	1 Grizzly Peak
4		5	2 Robinsons Butte
6	7	8	3 Browns Mtn.
			4 Emigrant Lake
			5 Little Chinquapin Mtn.
			6 Siskiyou Pass
			7 Soda Mountain
			8 Parker Mtn.

ADJOINING 2.5' QUADRANGLE NAMES

ROAD LEGEND

Improved Road _____

Unimproved Road _____

Trail _____

Interstate Route U.S. Route State Route

HYATT RESERVOIR, OREG.

PROVISIONAL EDITION 1988

42122-B4-TF-024

Application No. *R-79282*

Permit No.

"CERTIFICATE NO. *77167*"

HYATT RESERVOIR NW