



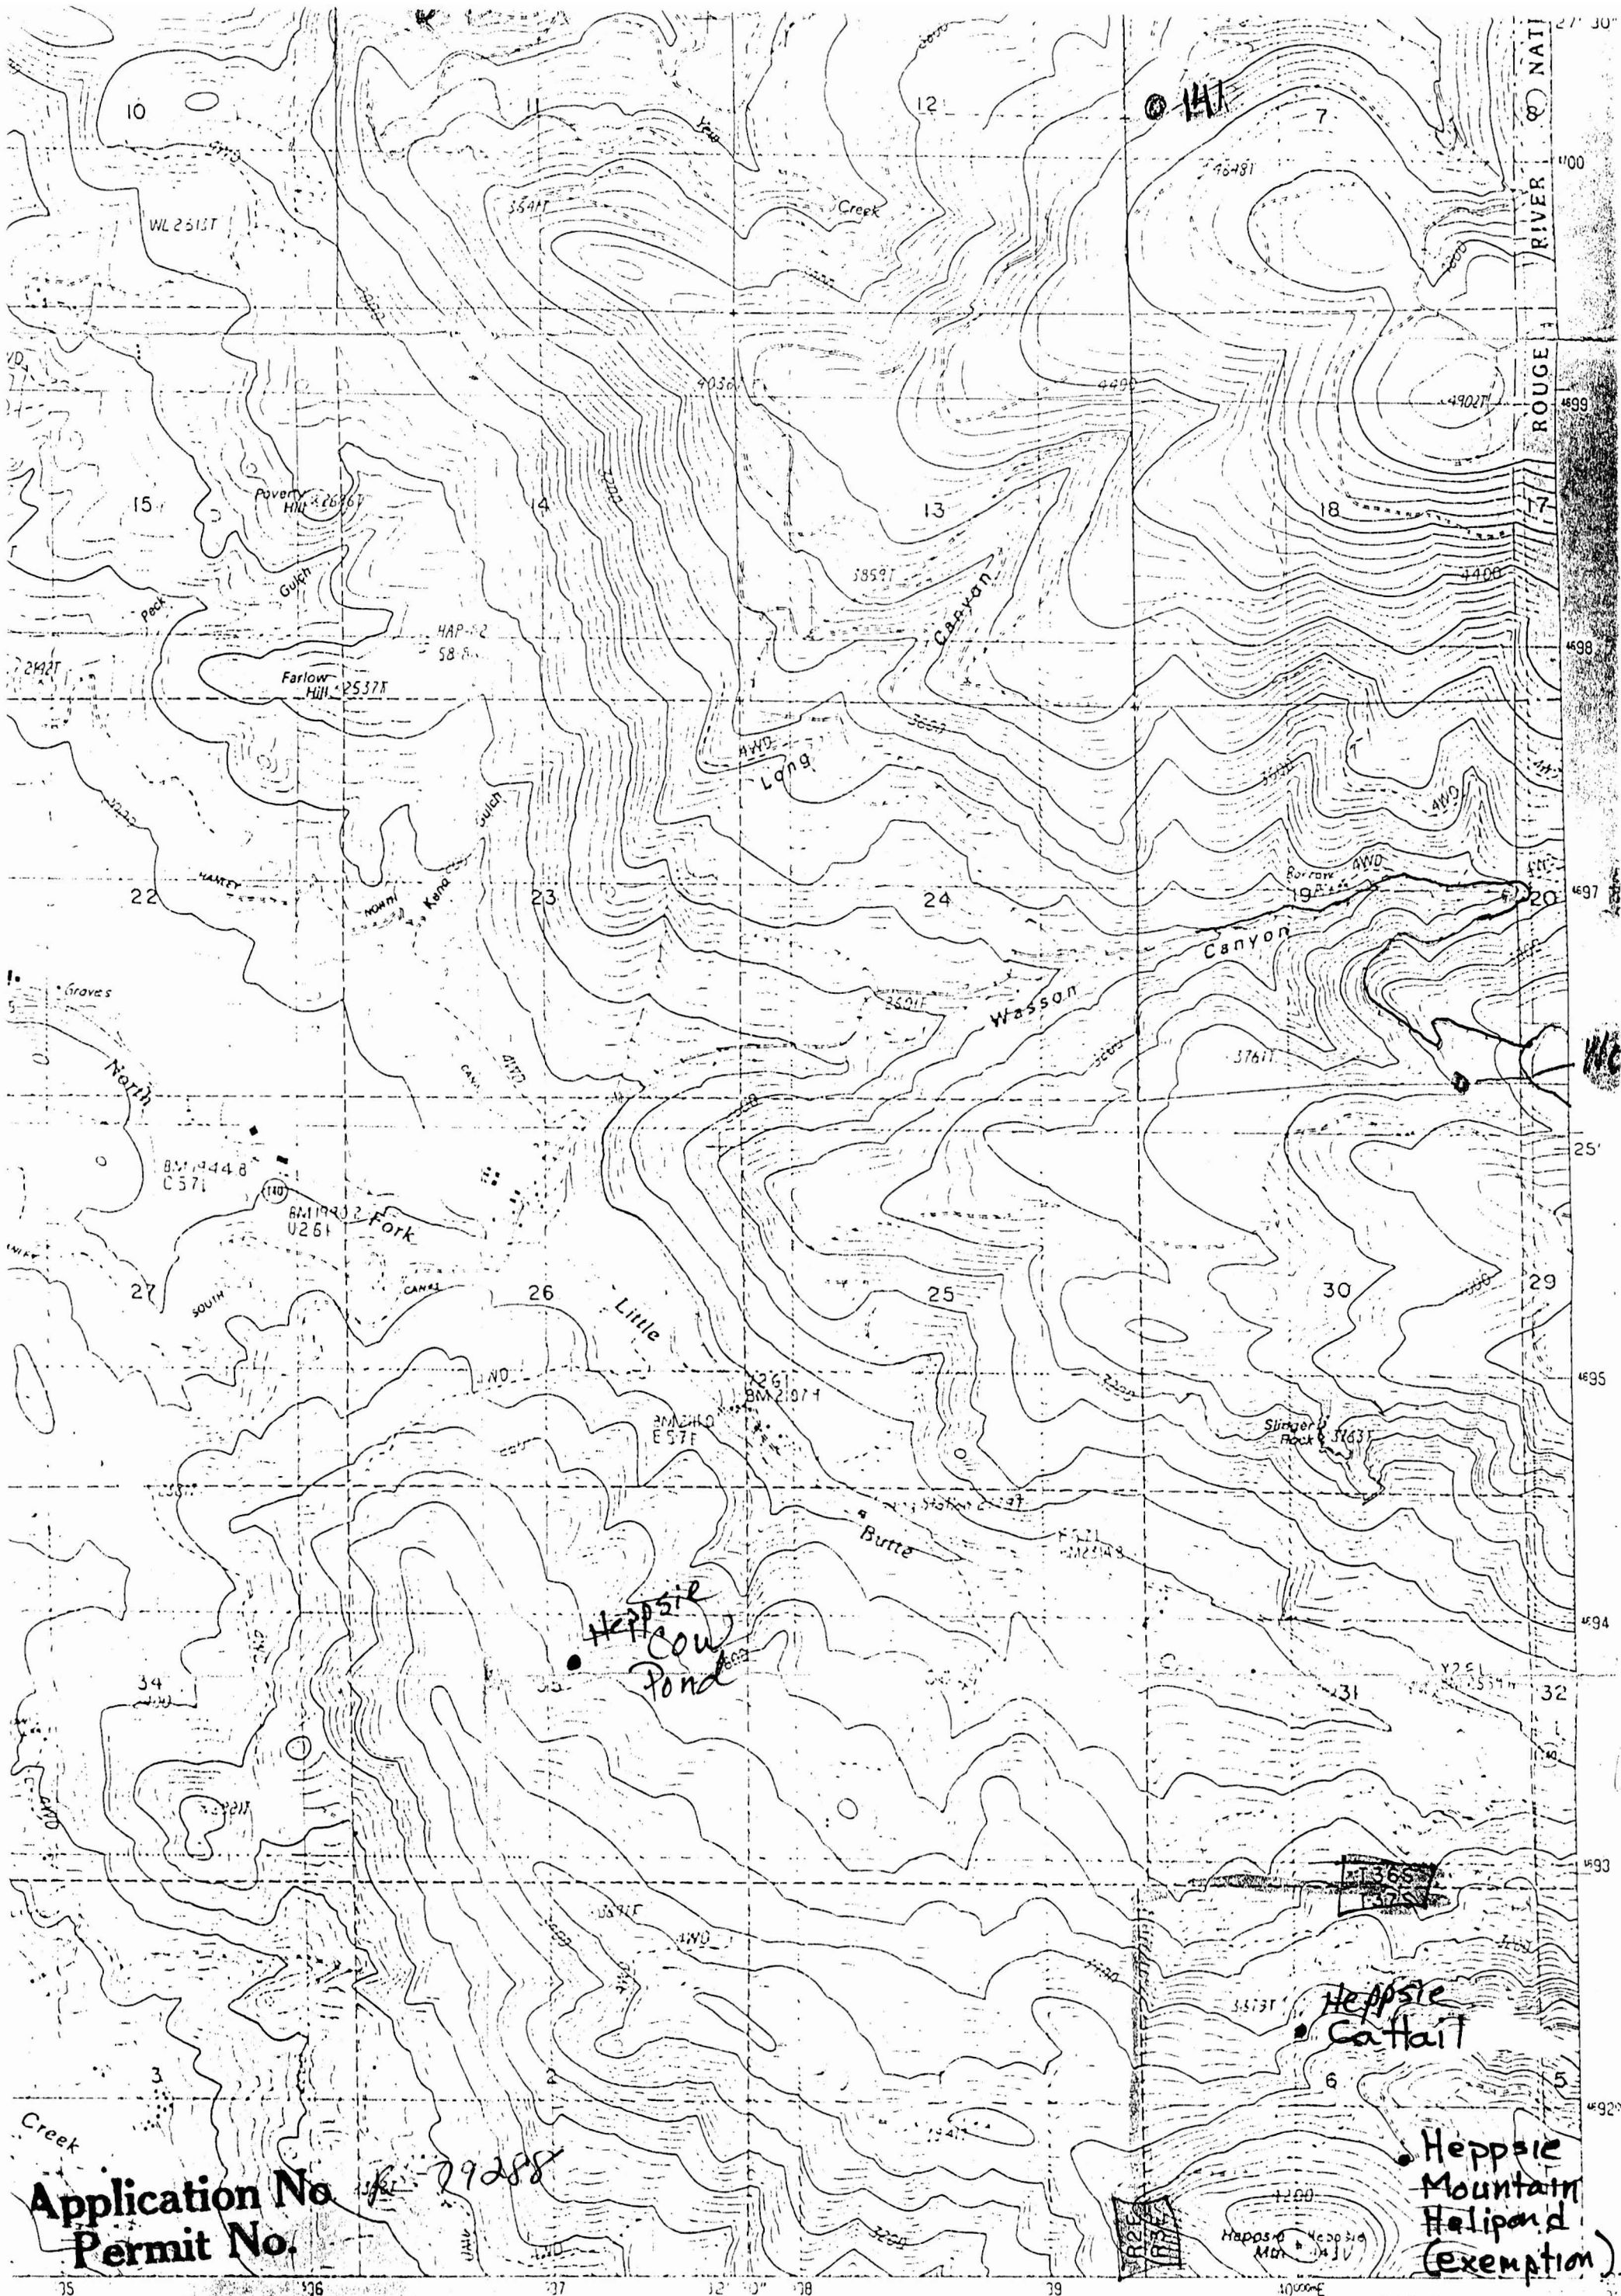

Application No. *29288*
Permit No.

SCALE 1:24 000

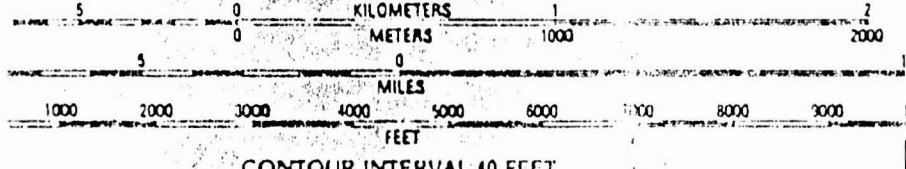

CONTOUR INTERVAL 40 FEET



QUADRANGLE LOCATION

1	2	3	1 Obenchain Mtn.
---	---	---	------------------

Look for NE
ROAD LEGEND

- Improved Road.....
- Unimproved Road.....
- Trail.....

71470