


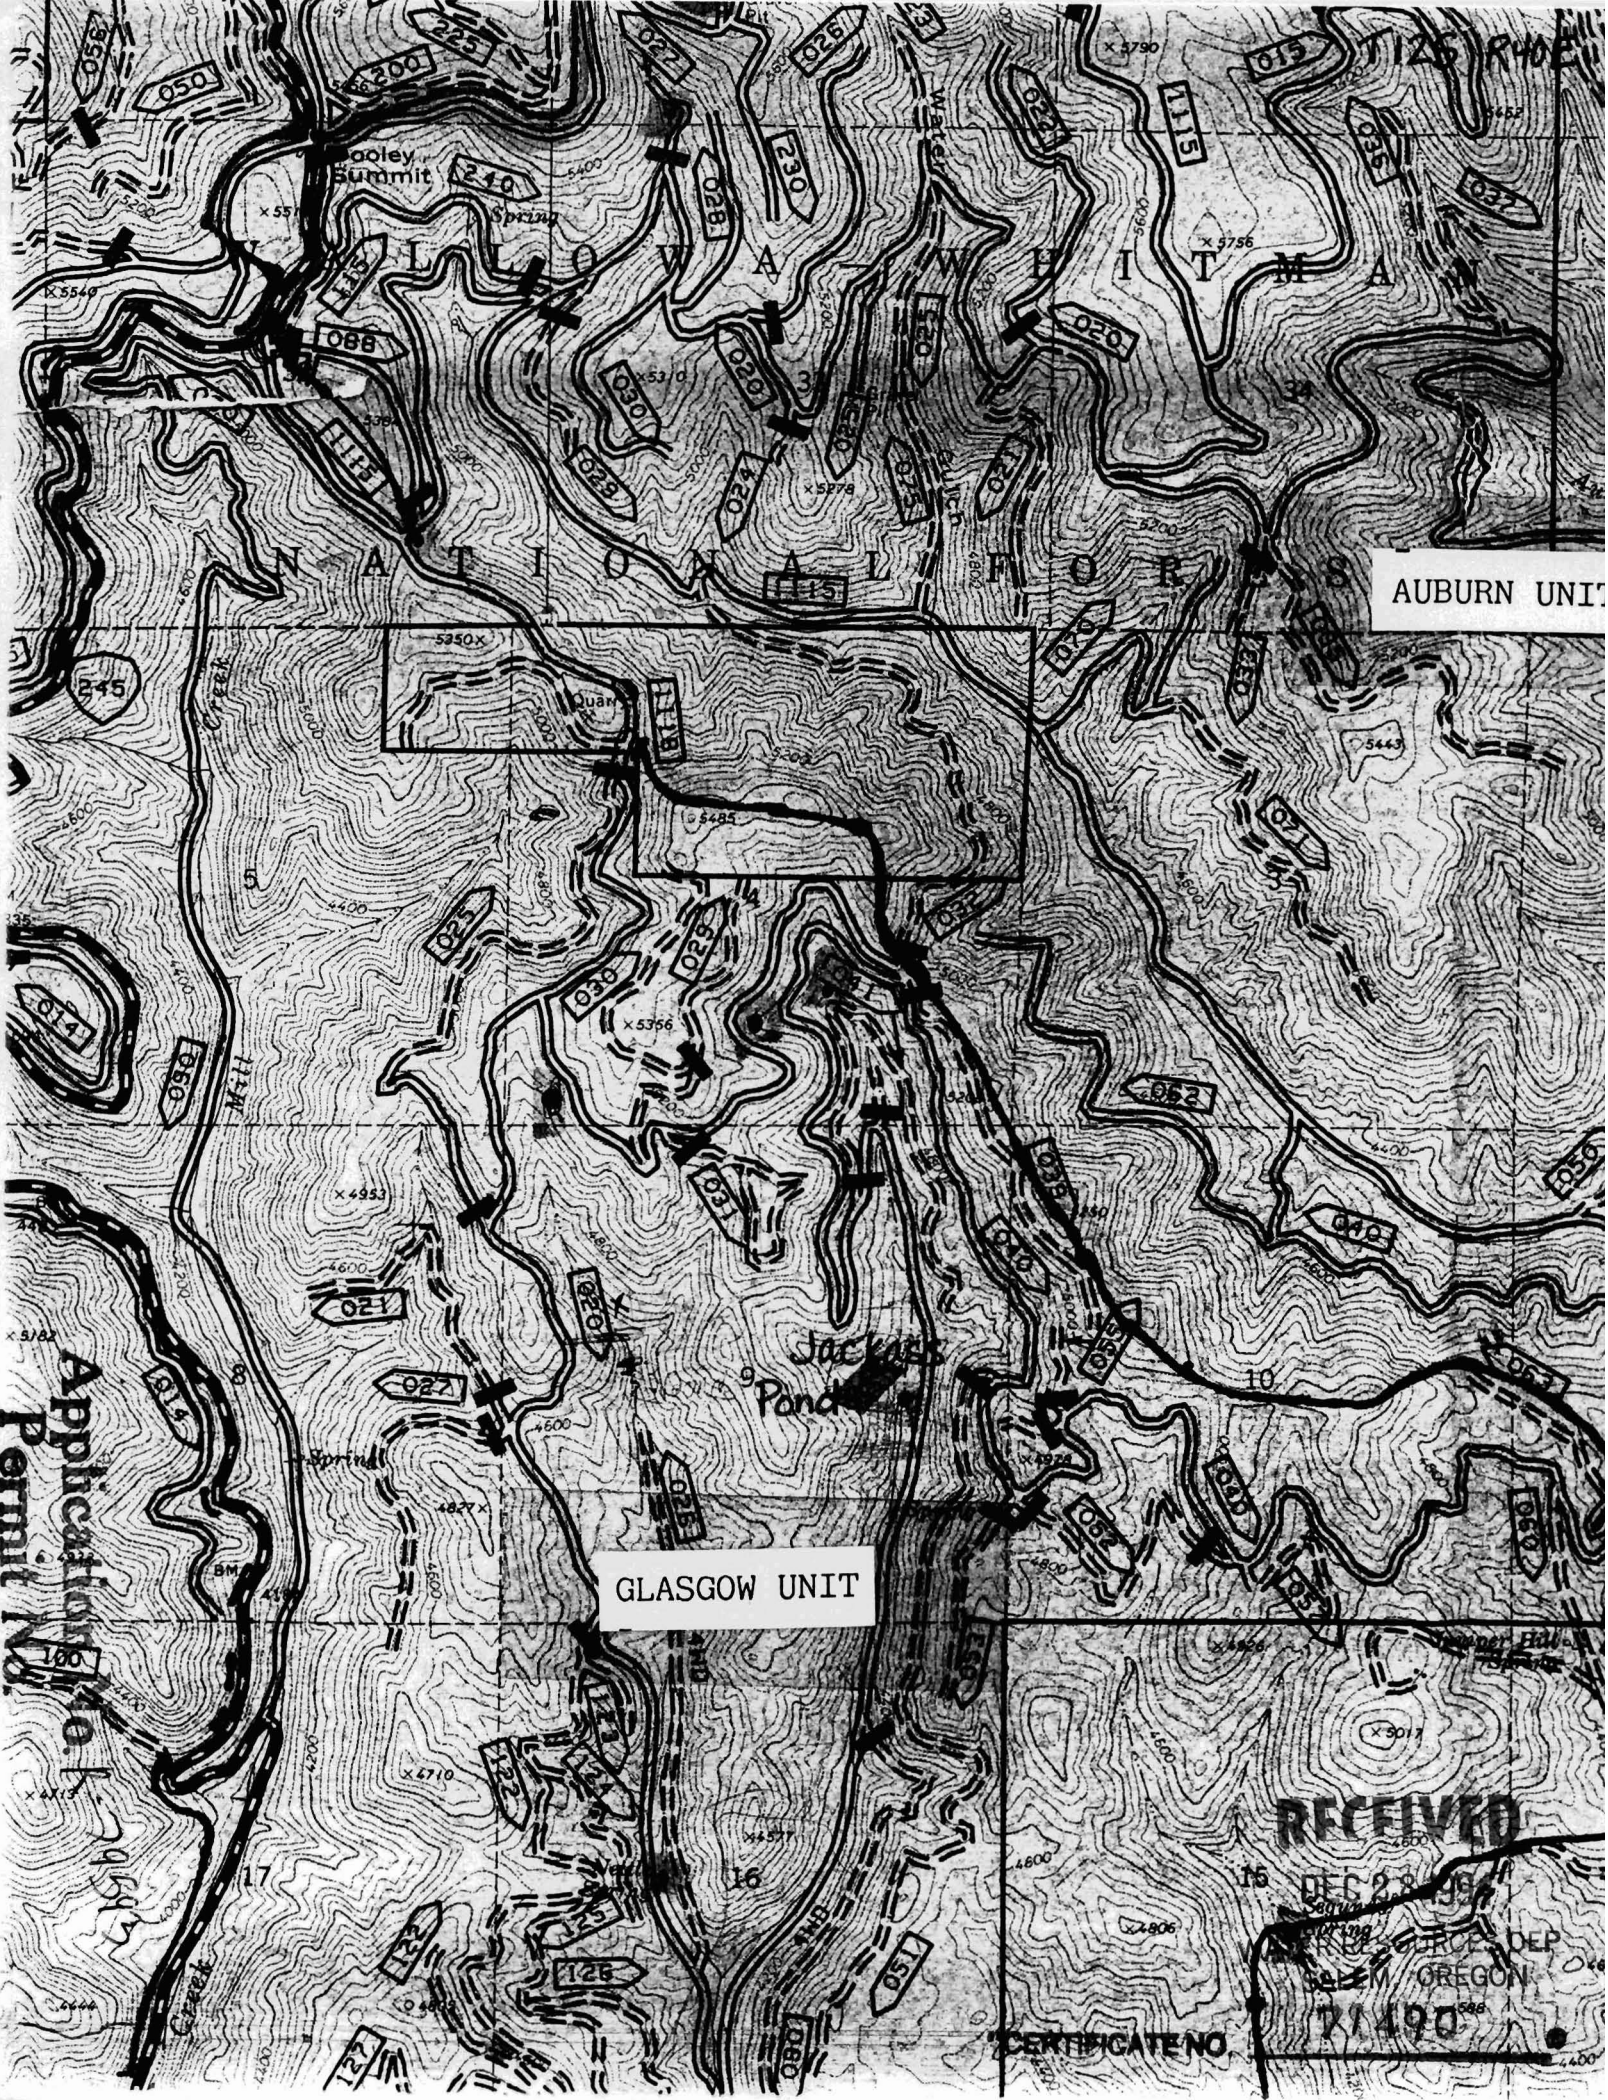

AUBURN UNIT

GLASGOW UNIT


RECEIVED

DEC 28 1994

OREGON DEPT OF FOREST
SALEM, OREGON

71490

CERTIFICATE NO.

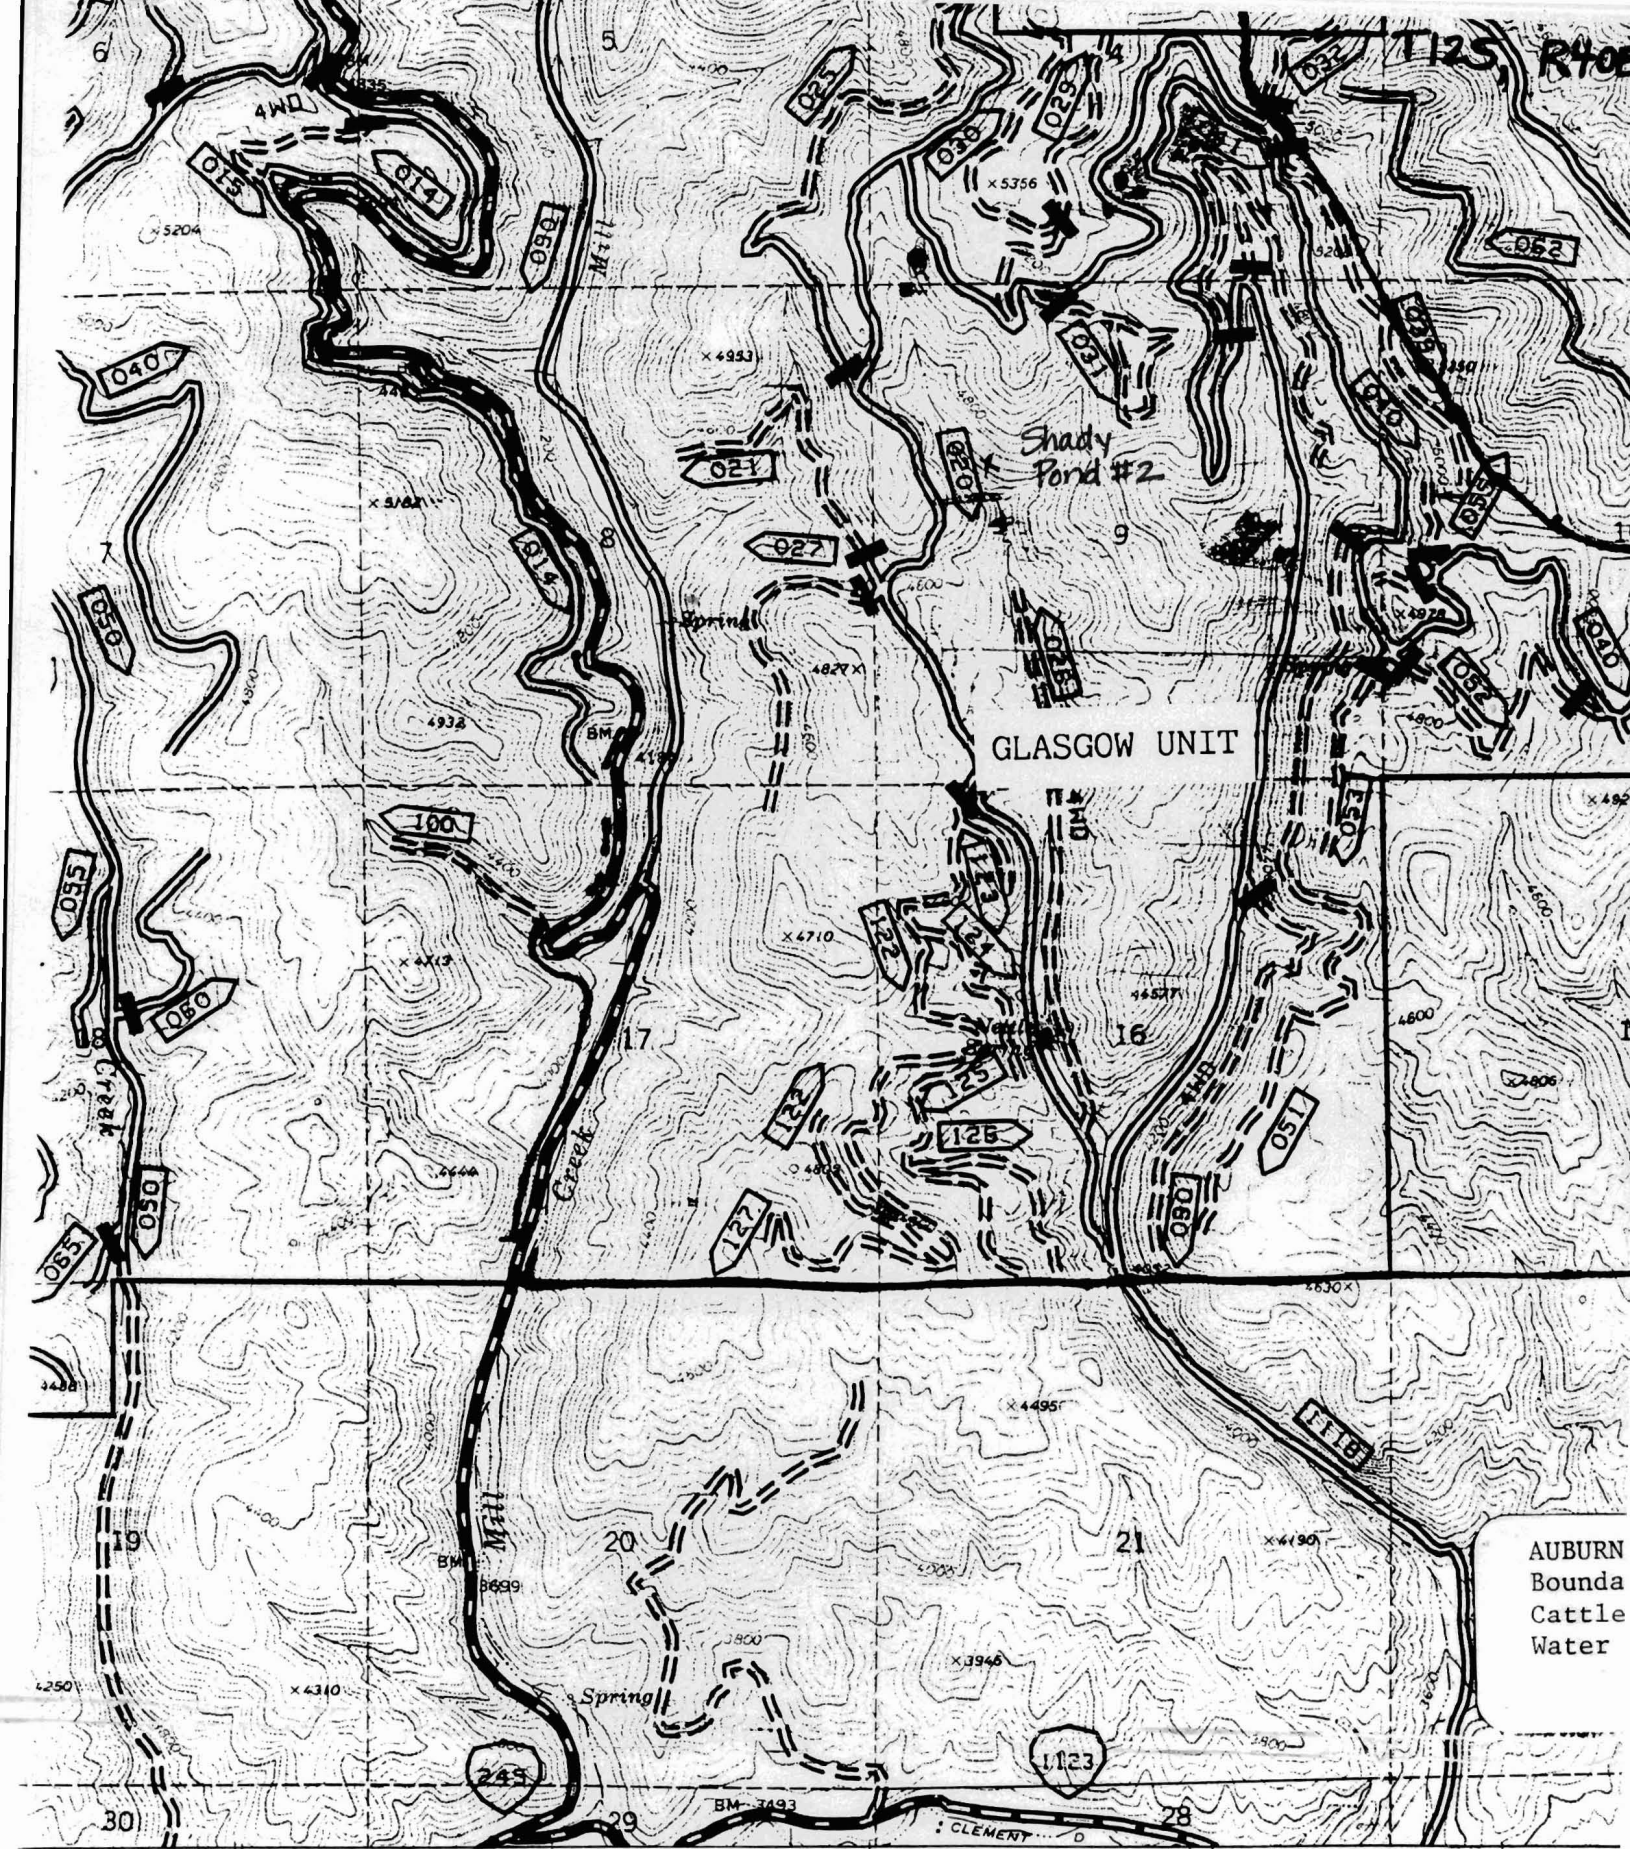


U.S. Geological Survey
 OAA
 etric methods from aerial
 Field checked 1967
 7 North American datum

Application No R-79593
Permit No.


"CERTIFICATE NO.

71490

CONTOUR INTERVAL 40 FEET
 DATUM IS MEAN SEA LEVEL

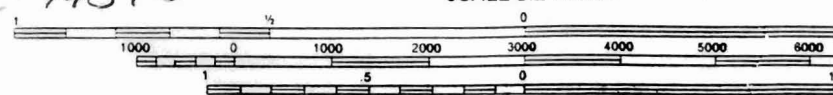

18 1/2°

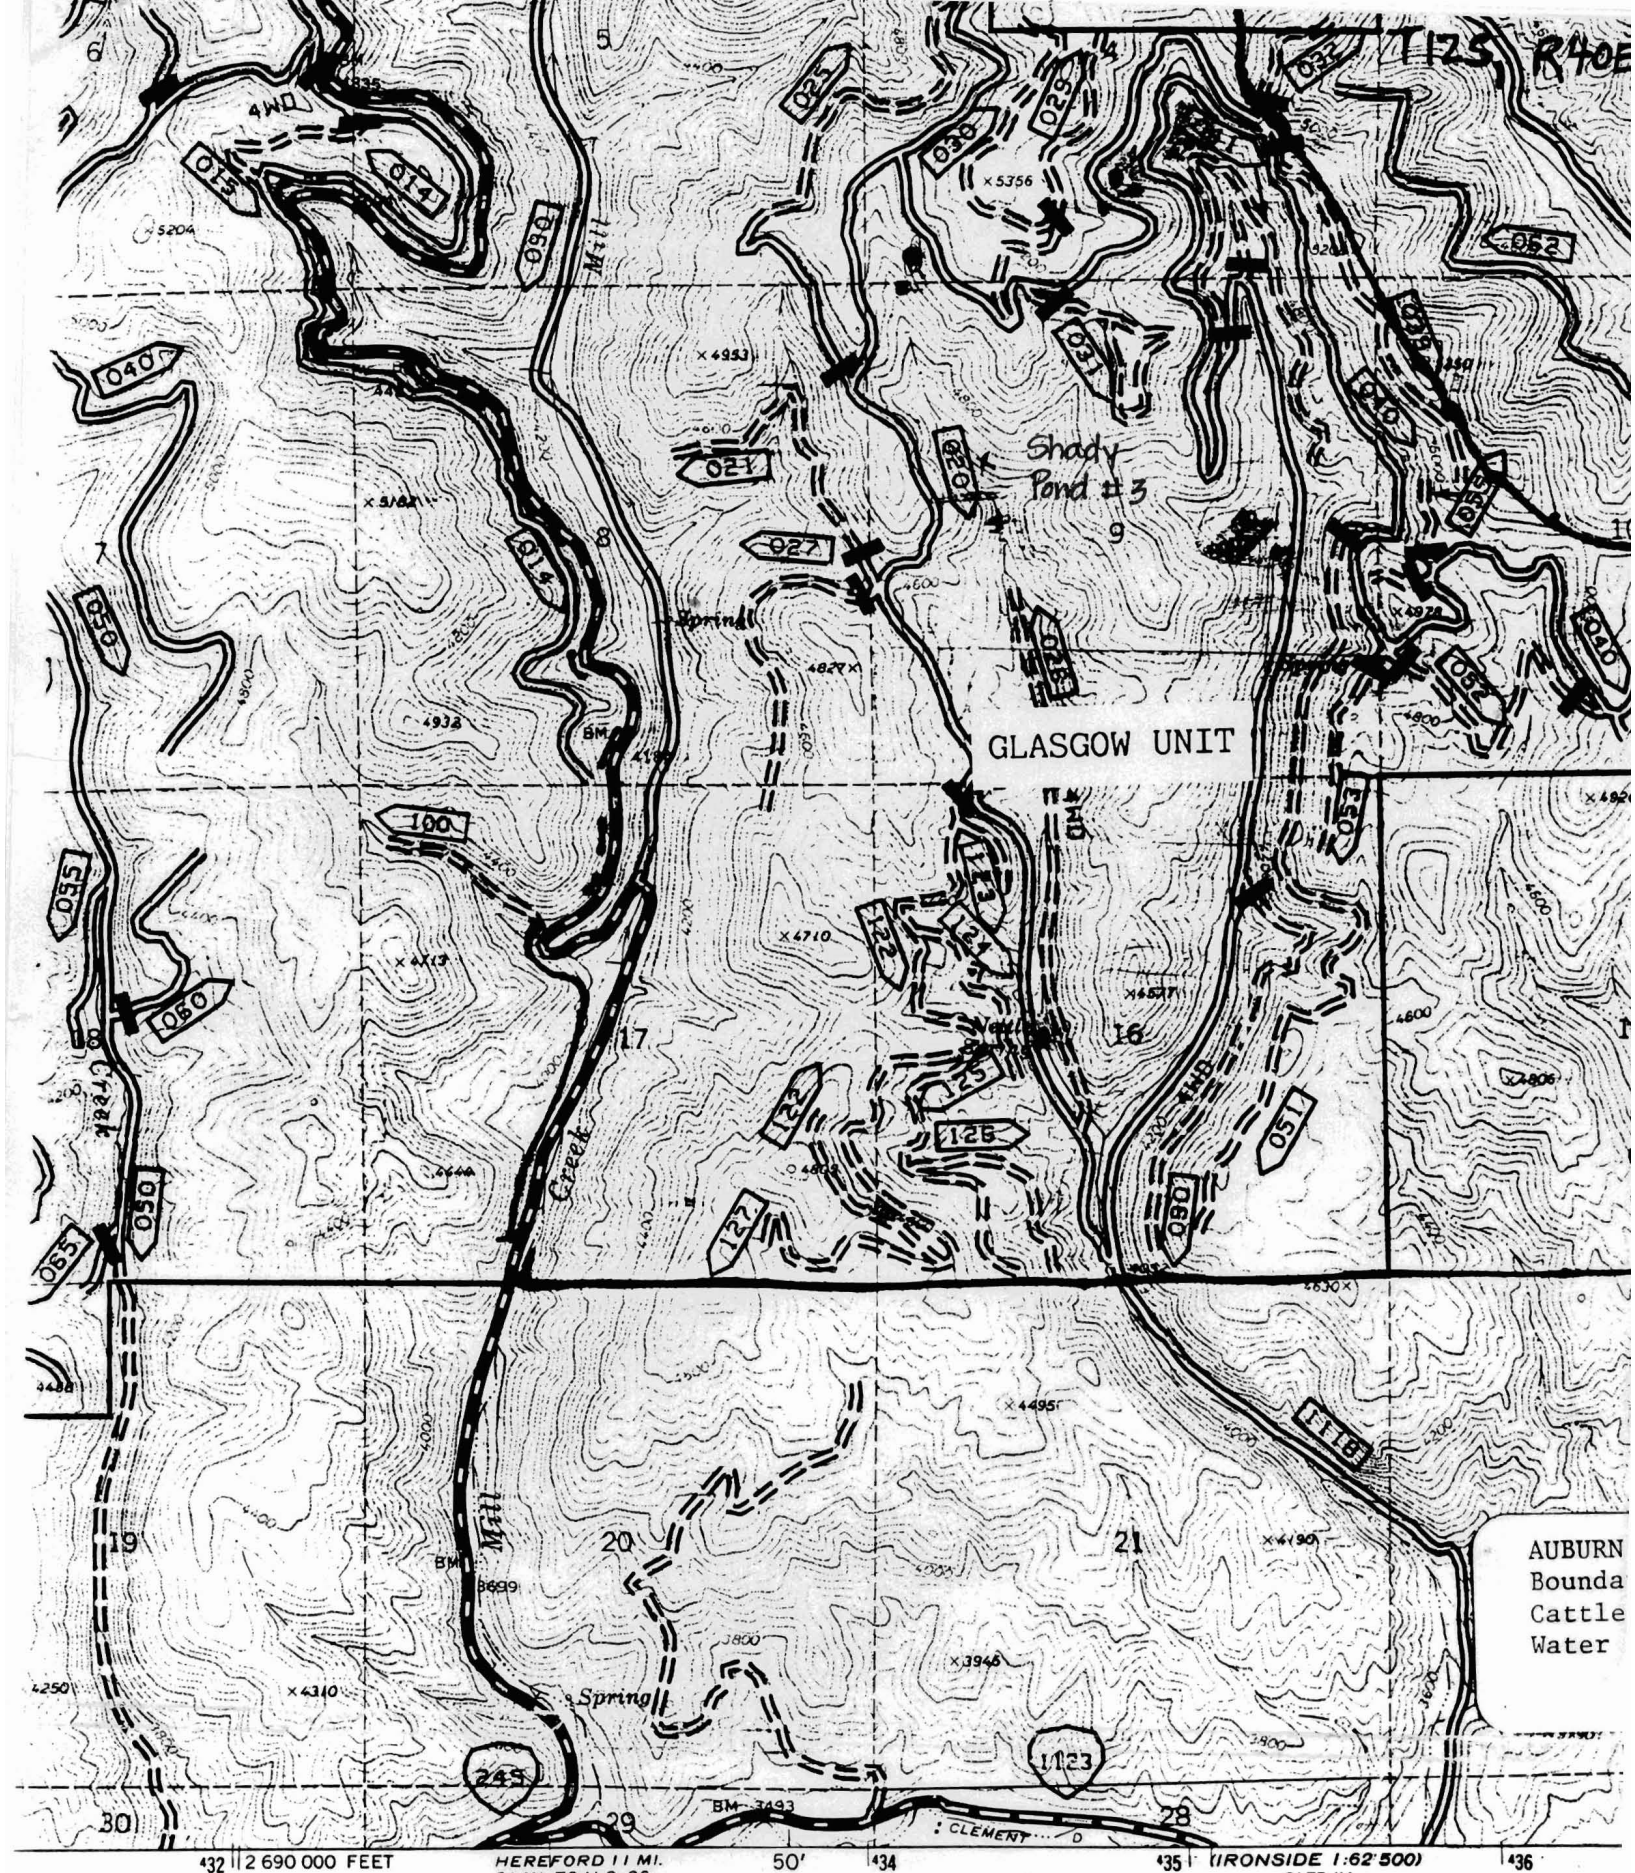

U.S. Geological Survey
OAA
Metric methods from aerial
Field checked 1967
North American datum


Application No. *R 79593*

Permit No.

"CERTIFICATE NO.

71490

SCALE 1:24 000

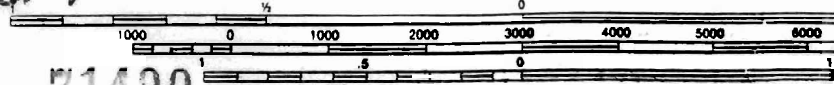

CONTOUR INTERVAL 40 FEET
DATUM IS MEAN SEA LEVEL

LEGEND