

Application No. R-80057  
Permit No. IN 4 34


RECEIVED

JAN - 5 1995

WATER RESOURCES DEP.  
SALEM, OREGON

71743

"CERTIFICATE NO."

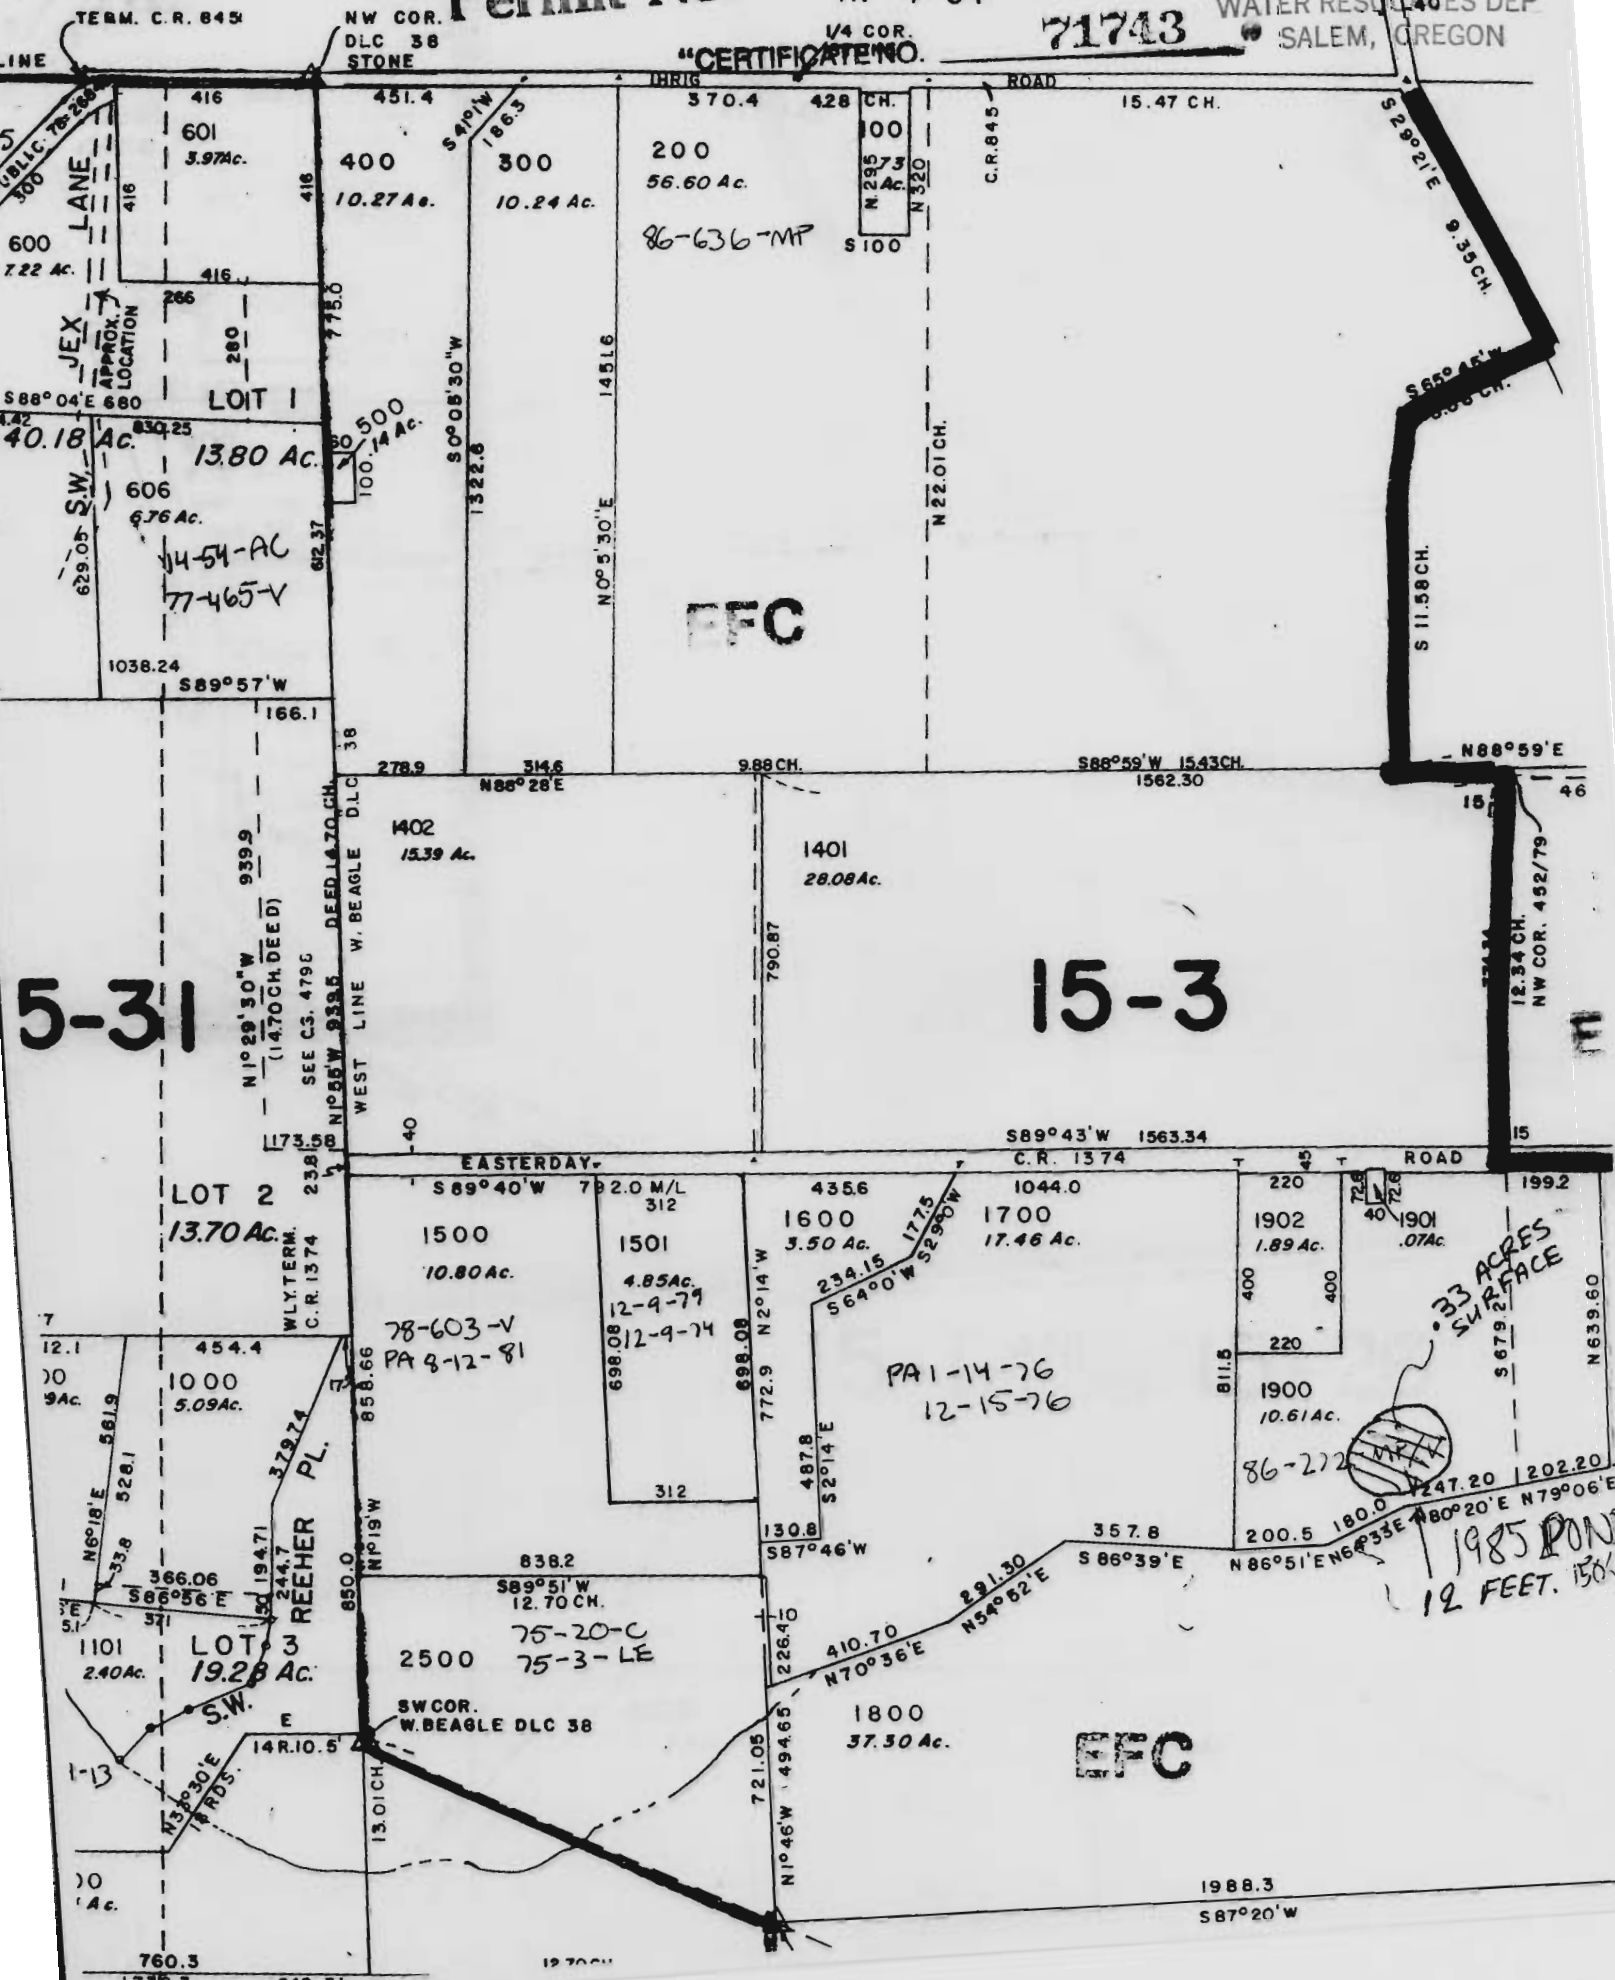

5-31

15-3

EFC

EFC

33 ACRES SURFACE

1985 POND  
12 FEET. 150x

1988.3  
S87°20'W