

SCALE 1:40000

2000 0 2000 4000

RECEIVED
JAN - 4 1995
WATER RESOURCES
DALE, OREGON

T9S R6E

DARRELL FRIEND

Box 41

ASHWOOD, DR

97711

ALL IN TAX LOT
1502

PONDOS

Sec. 26

1, 2, 3, 4

Sec. 25

5, 6

Sec 23


7, 9, 10

Sec 24

8

1. 8. 72 28' 01" E. 178.20'
2. 8. 08 39' 17" E. 478.10'
3. 8. 01 08' 34" E. 436.34'
4. 8. 00 47' 47" E. 343.40'
5. 8. 00 48' 59" E. 304.04'
6. 8. 00 00' 19" E. 2036.10'
7. 8. 00 38' 10" W. 136.10'
8. 8. 01 41' 30" W. 100.08'
9. 8. 48' 15' 22" W. 219.04'
10. 8. 08' 40' 00" W. 319.81'
11. 8. 39' 05' 16" W. 80.65'
12. 8. 27' 05' 03" W. 101.10'
13. 8. 08' 05' 20" W. 1, 078.70'

SEE MAP 9 15

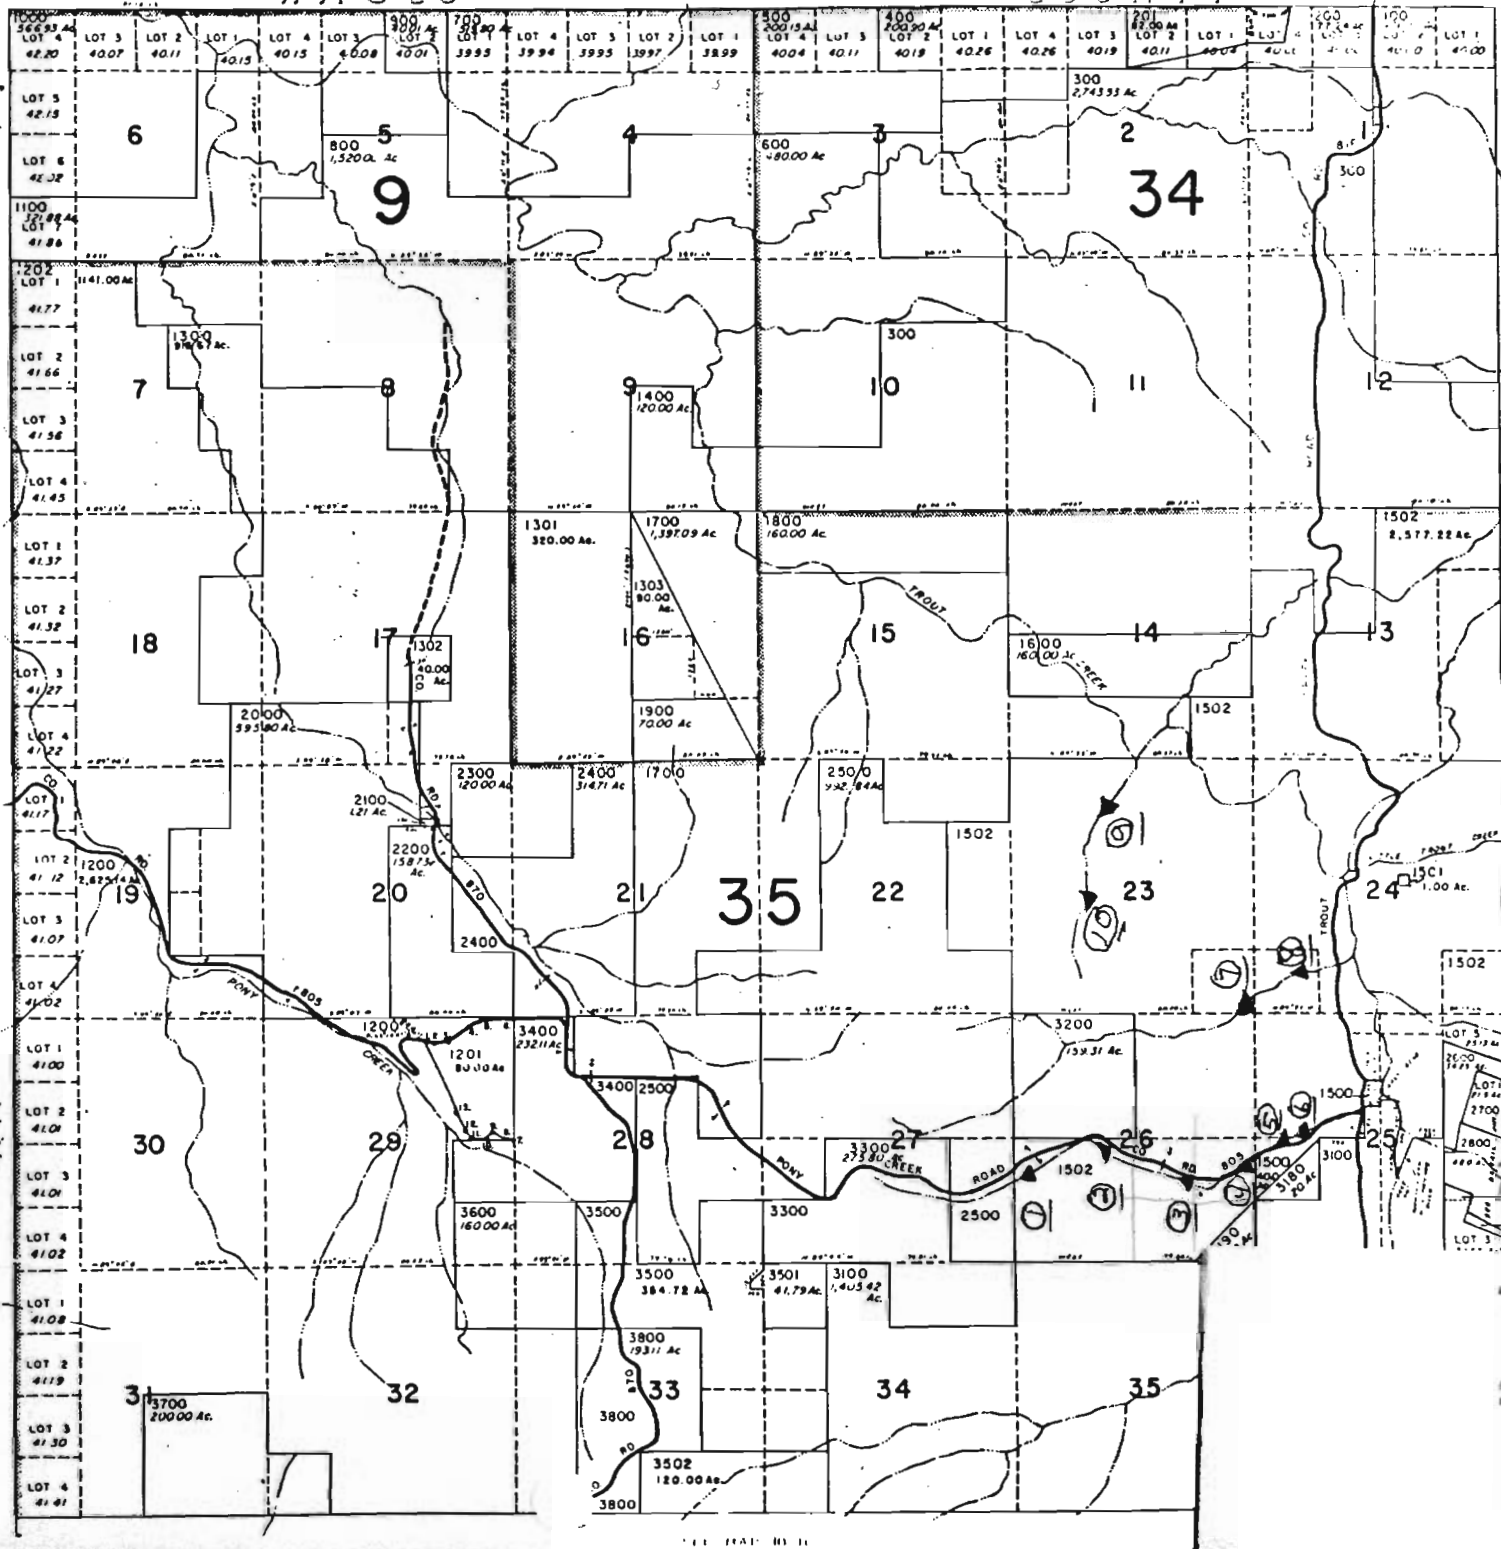

71764

"CERTIFICATE NO.

R-8002

Application No.

Permit No.