



Jefferson

SCALE 1:46000

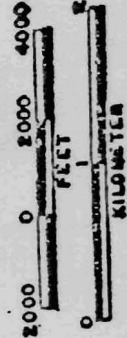

This map was prepared for assessment purposes only

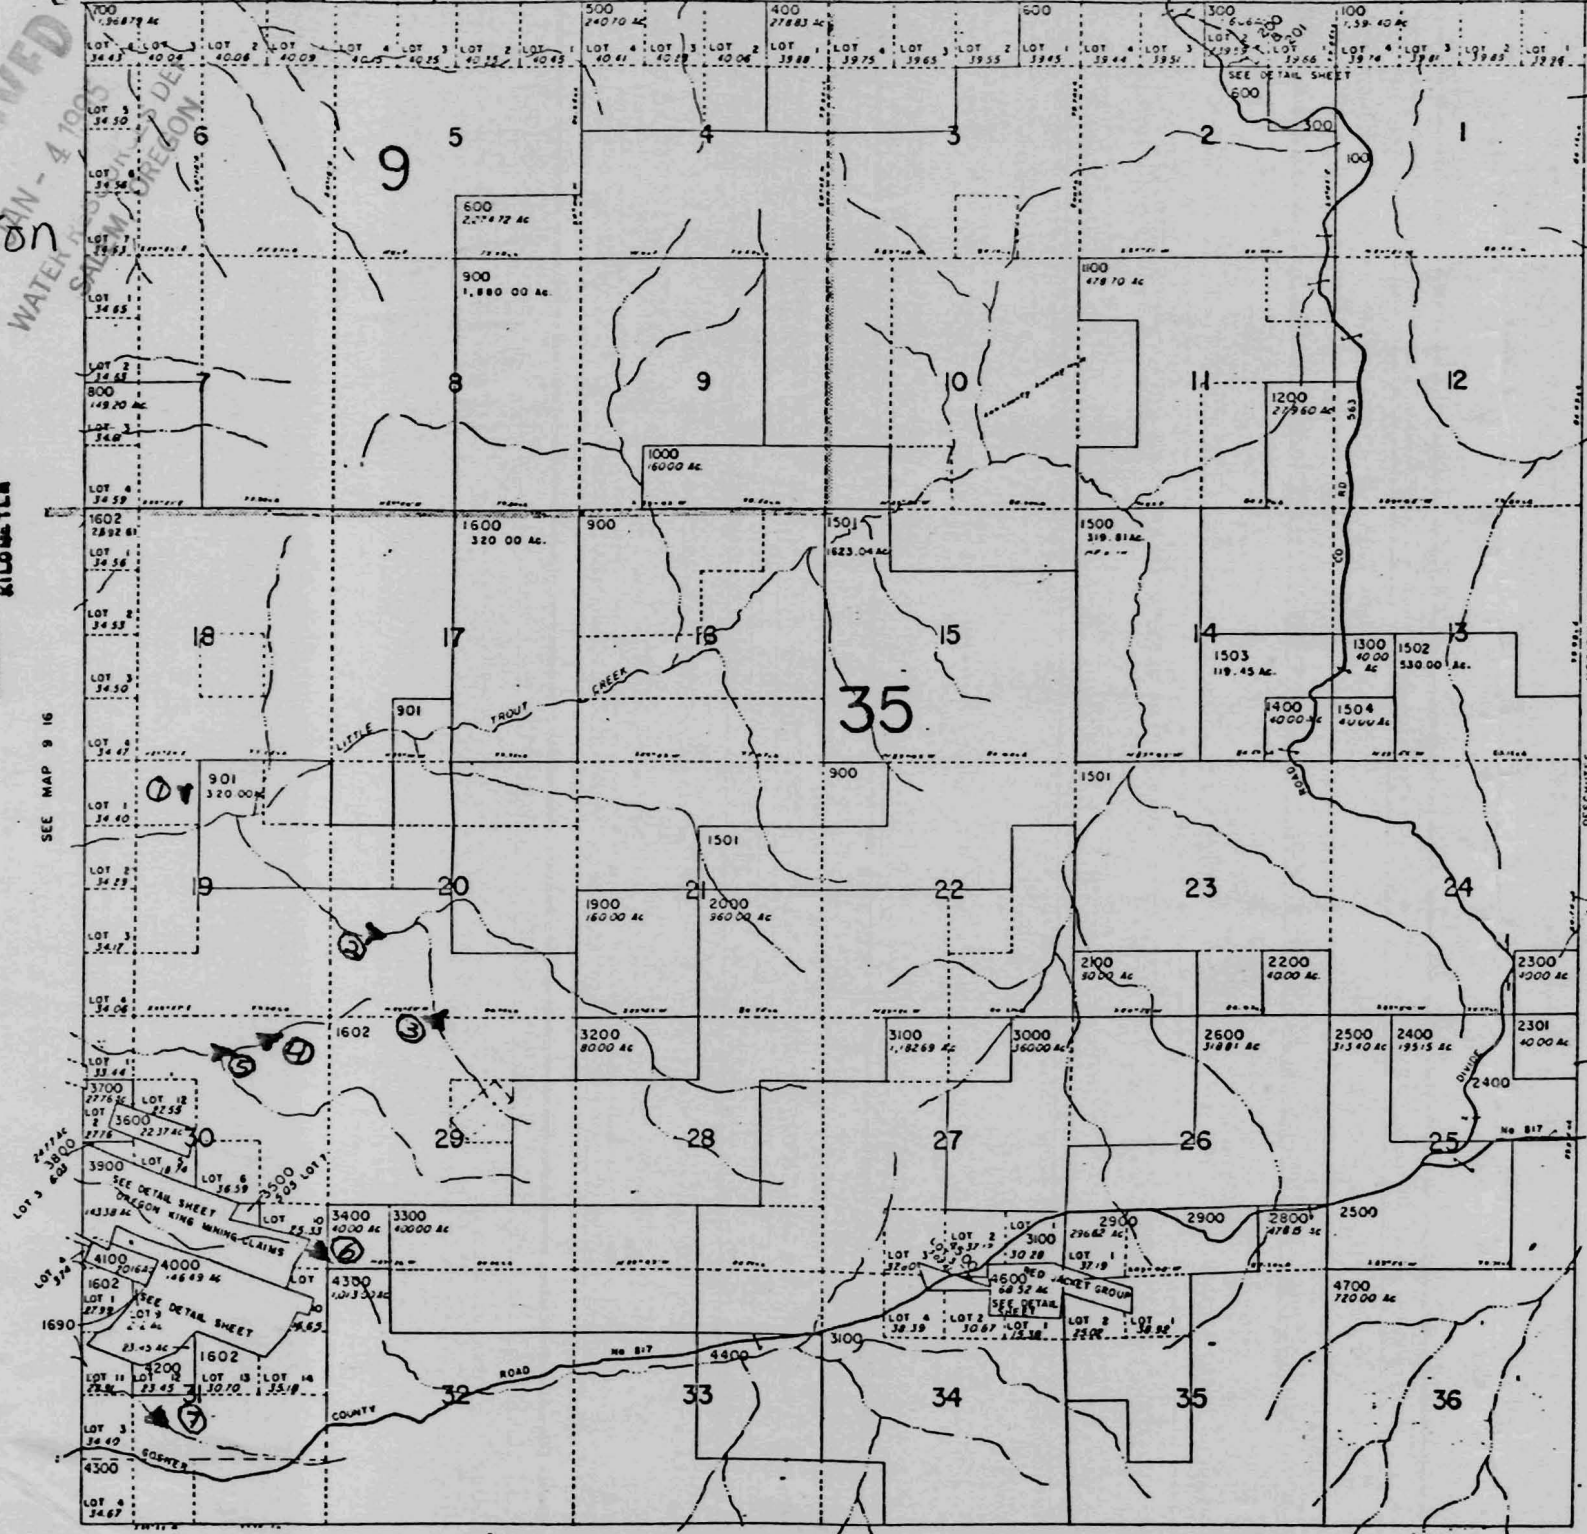

T9SR17E
1"=2000'


DARRELL FRIED
Box 41
ASHWOOD, OR
97711

ALL IN TAX
LOT #1602
Sec 19 1
Sec 20 2,3
Sec 30 45,6
Sec 31 7

T9SR16E
Sec 36
TAX LOT
3001
Pond 8,9

Application No. R-80083
Permit No.

CERTIFICATE NO. 71765

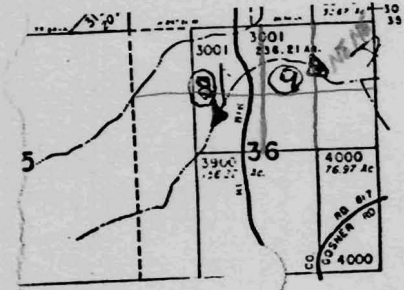

SEE MAP 10 17