T. 8S., R. 44E.-W.M.
4" = 1 MILE

CERTIFICATE NO. 71870
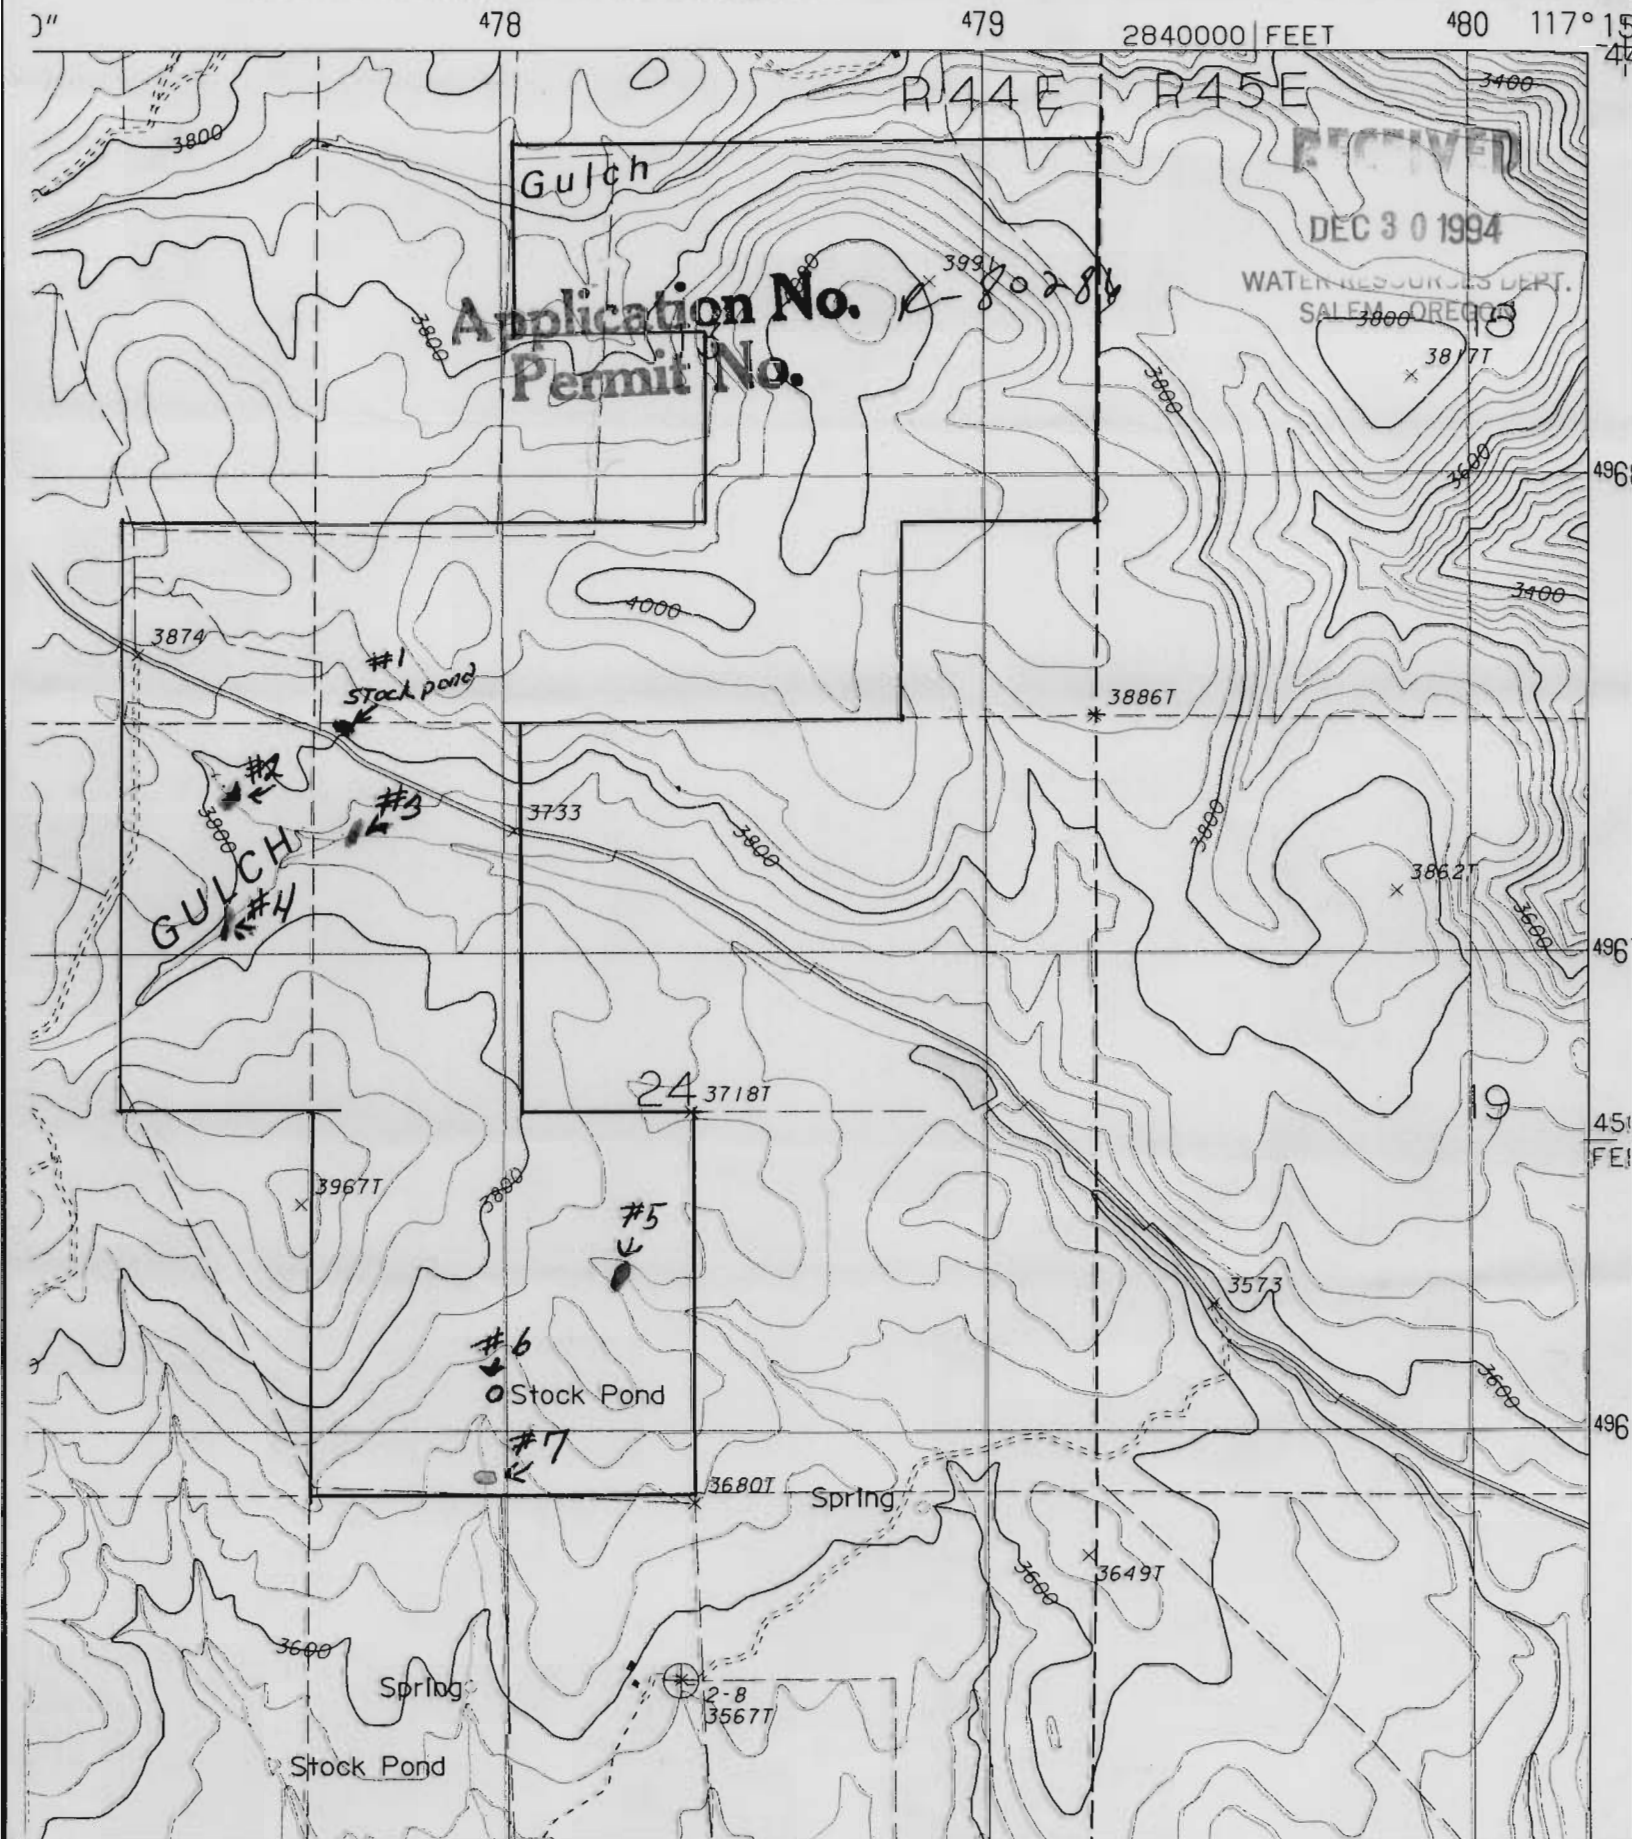
SPARTA QUADRANGLE
OREGON–BAKER CO.
7.5 MINUTE SERIES (TOPOGRAPH