

71978

REC'D

JUN 12 1995


WATER RESOURCES DIVISION
SALEM, OREGON

T.38S., R.11E., W.M.

Application No. R-80426
Permit No.

Pond #1 to be used:
Emergency frost protection
or cooling if we have a
power failure and are
unable to use the well.

Pond #2
Gate is open and
we will not use it,

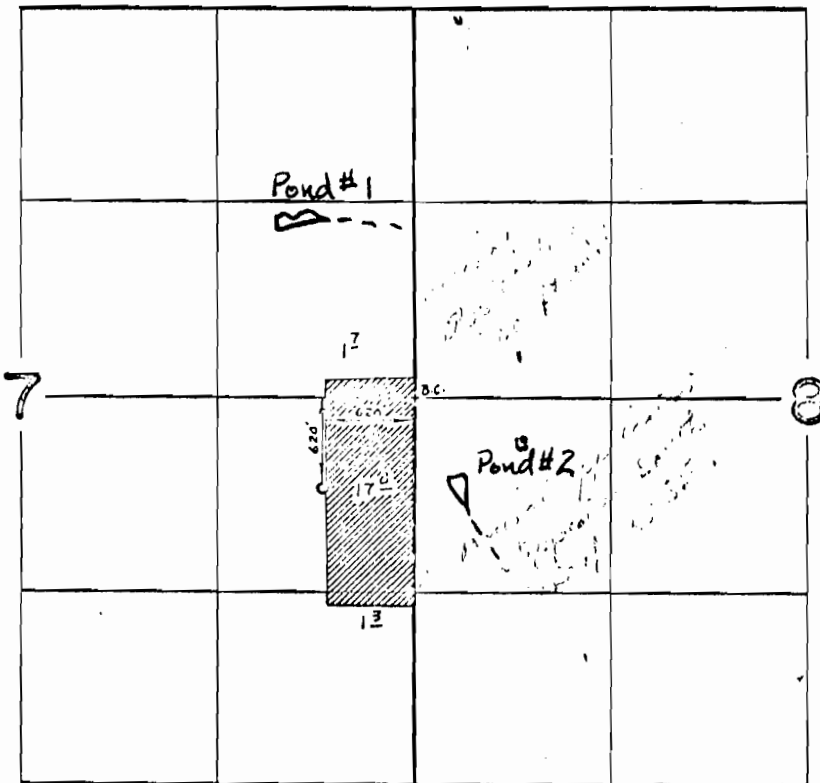

FINAL PROOF SURVEY
UNDER

Application No. G-4728 Permit No. G-4448
IN NAME OF

WEYERHAEUSER COMPANY

Surveyed Oct 13 1972 by D. Norby