

5 4 28


SCALE 1" = 9600'

71983

CERTIFICATE NO.

RECEIVED
FEB 22 1991
DEPT. OF REVENUE STATE OF OREGON
ASSESSMENT & APPRAISAL DIV.

SEE MAP 5 4 29

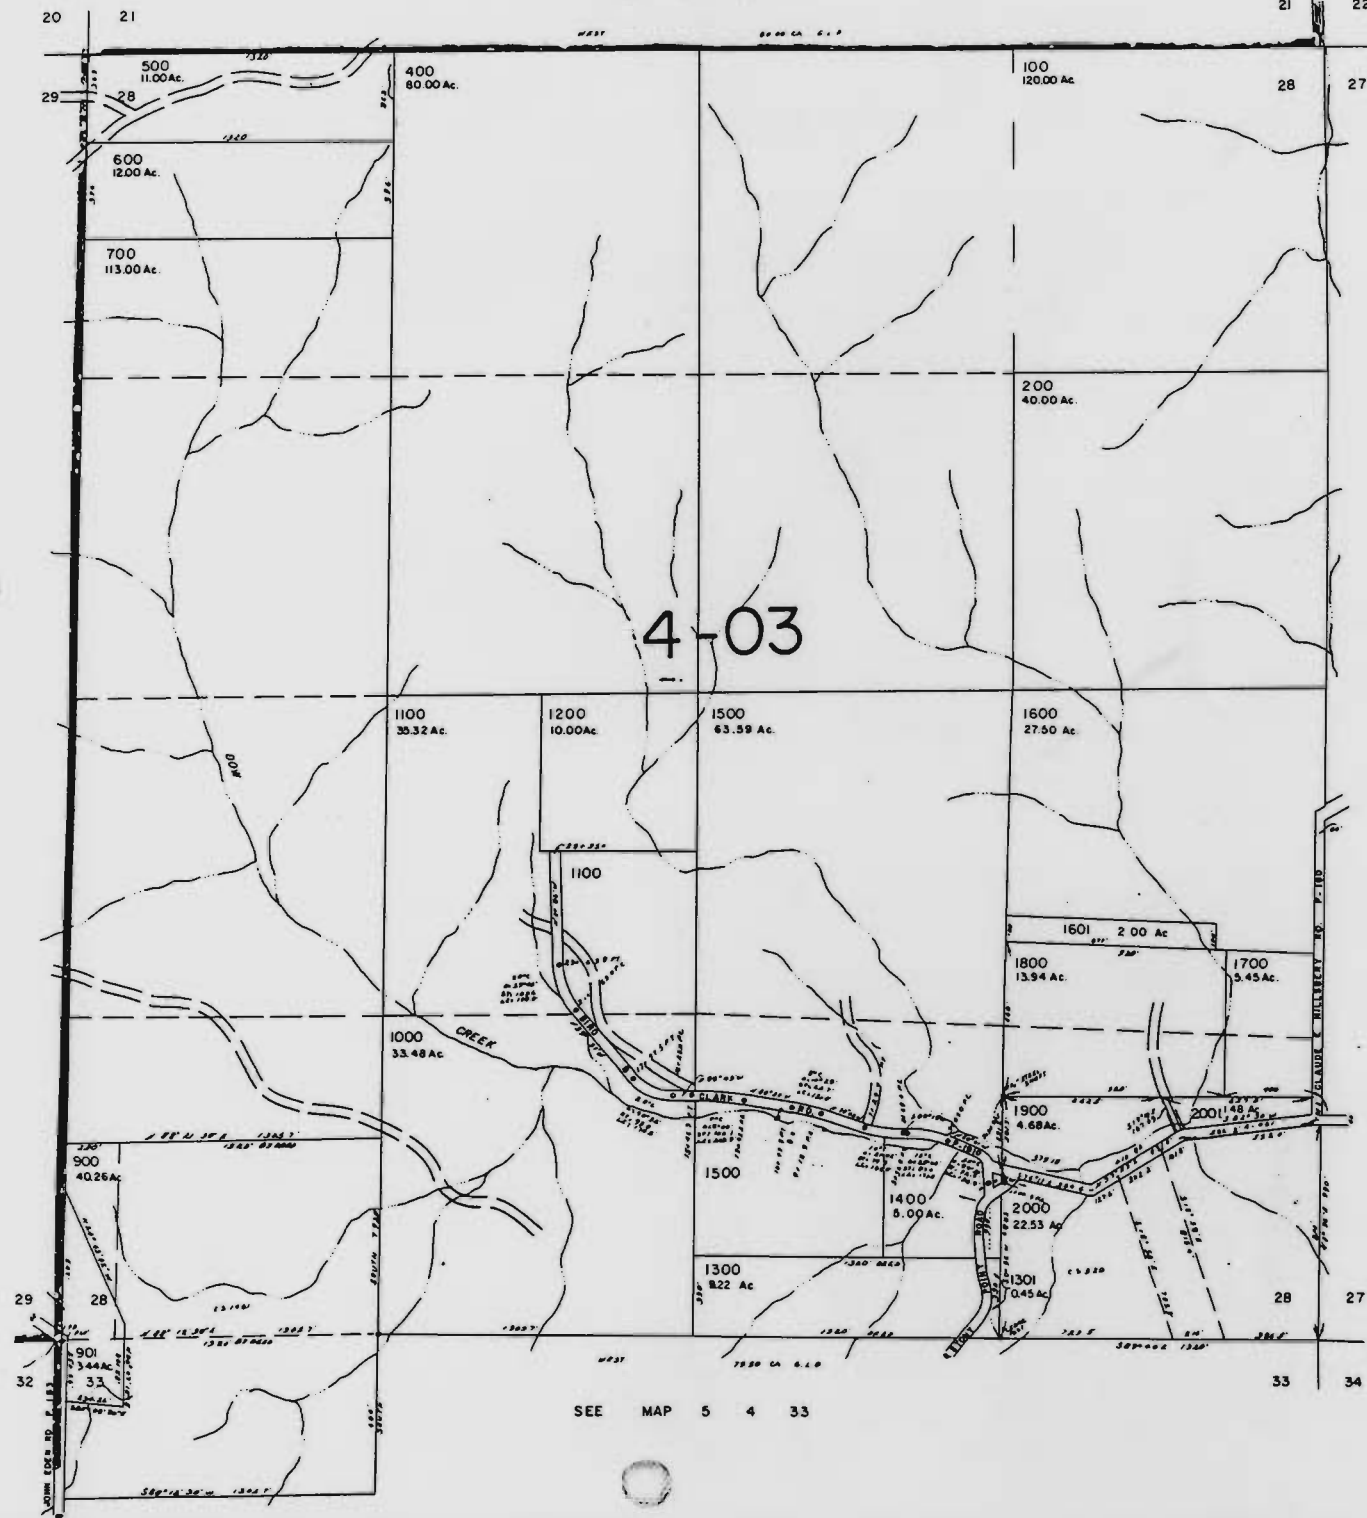

CANCEL TL
1401
800

Application No. 880431
Permit No.

SEE MAP 5 4 27

5 28

ref file # I-240

HB 2153

RECEIVED

JUN - 8 1995

WATER RESOURCES DEPT
SALEM, OREGON



COMPLIMENTS OF
FIRST AMERICAN
TITLE
COMPANY OF
COLUMBIA COUNTY

This sketch is furnished
to assist in property
location and the company
does not guarantee
its accuracy.

CERTIFICATE NO.

71983

4

RECEIVED

DEC 30 1994

WATER RESOURCES DEPT
SALEM, OREGON

1100
35.32 Ac.

1200
10.00 Ac.

1500
3

1000
33.48 Ac.

CREEK

900
40.26 Ac.

Application No. R-80431
Permit No. SEE MAP 5

Reservoir
shown by orange
dot,
Gerry
Clark

SEE MAP 5 4 29

29
32

JOHN EDEN RD. P. 183