

RECEIVED

JUL 27 1995

72077

CERTIFICATE NO.


RECEIVED

DEC 29 1994  
WATER RESOURCES DEPT.  
SALEM, OREGON

THIS MAP IS FURNISHED AS A  
CONVENIENCE BY:  
**STEWART TITLE**  
THIS MAP IS NOT A SURVEY AND DOES NOT  
SHOW THE LOCATION OF ANY IMPROVE-  
MENTS. THE COMPANY ASSUMES NO LI-  
ABILITY FOR ANY ERRORS THEREIN.

R.H. BALDOCK

SEE MAP  
2S 1 25D

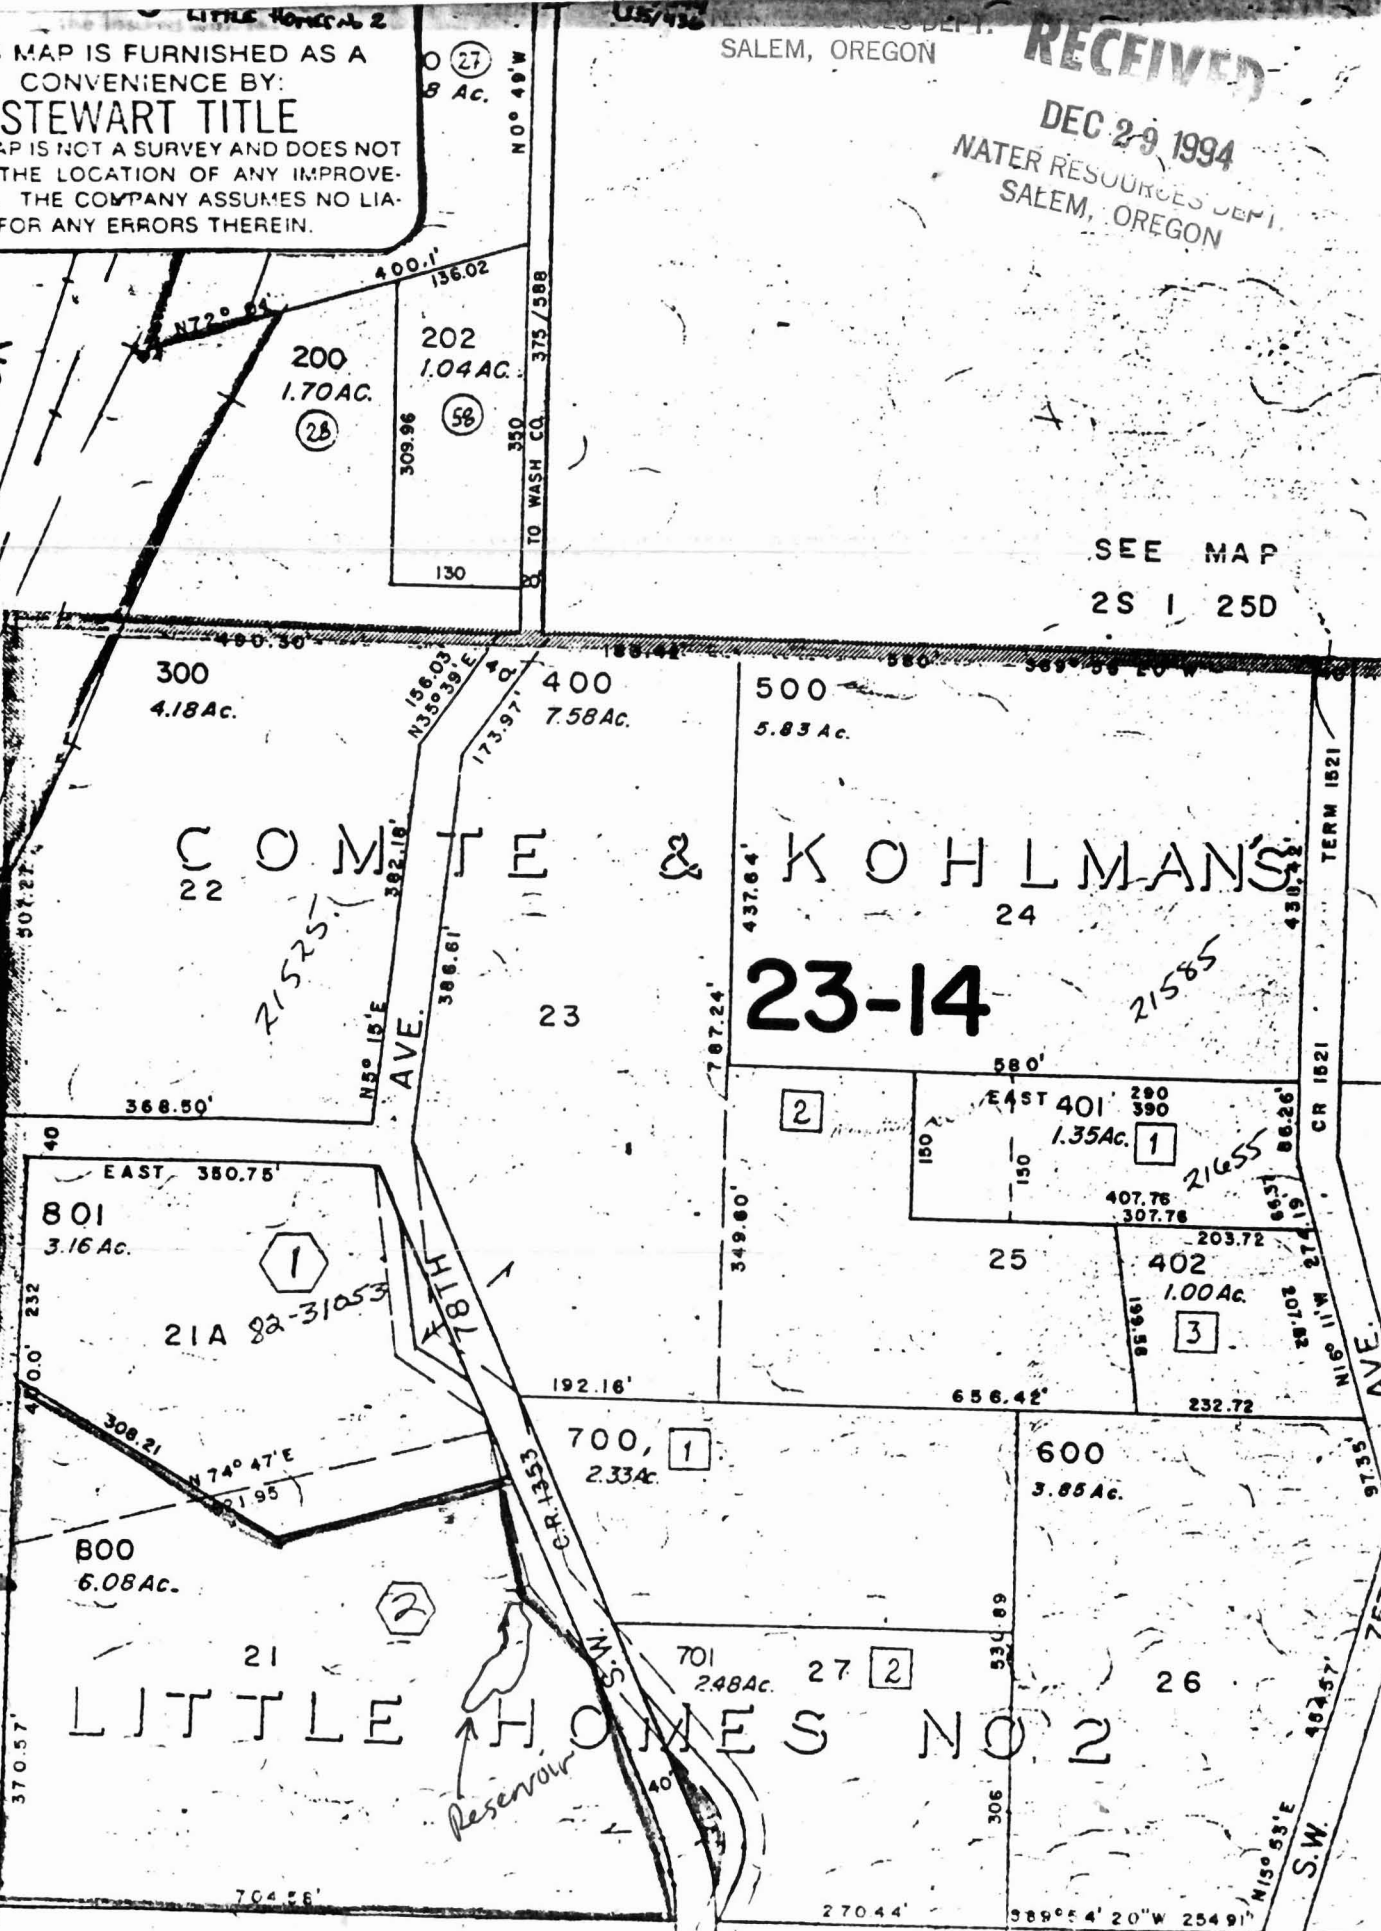

LITTLE HOMES NO 2

COMTE & KOHLMAN'S

23-14

Reservoir