


T. 85.
R. 4-6.

Application No. R80782
Permit No.


WATER RESOURCES DIV
SALEM, OREGON

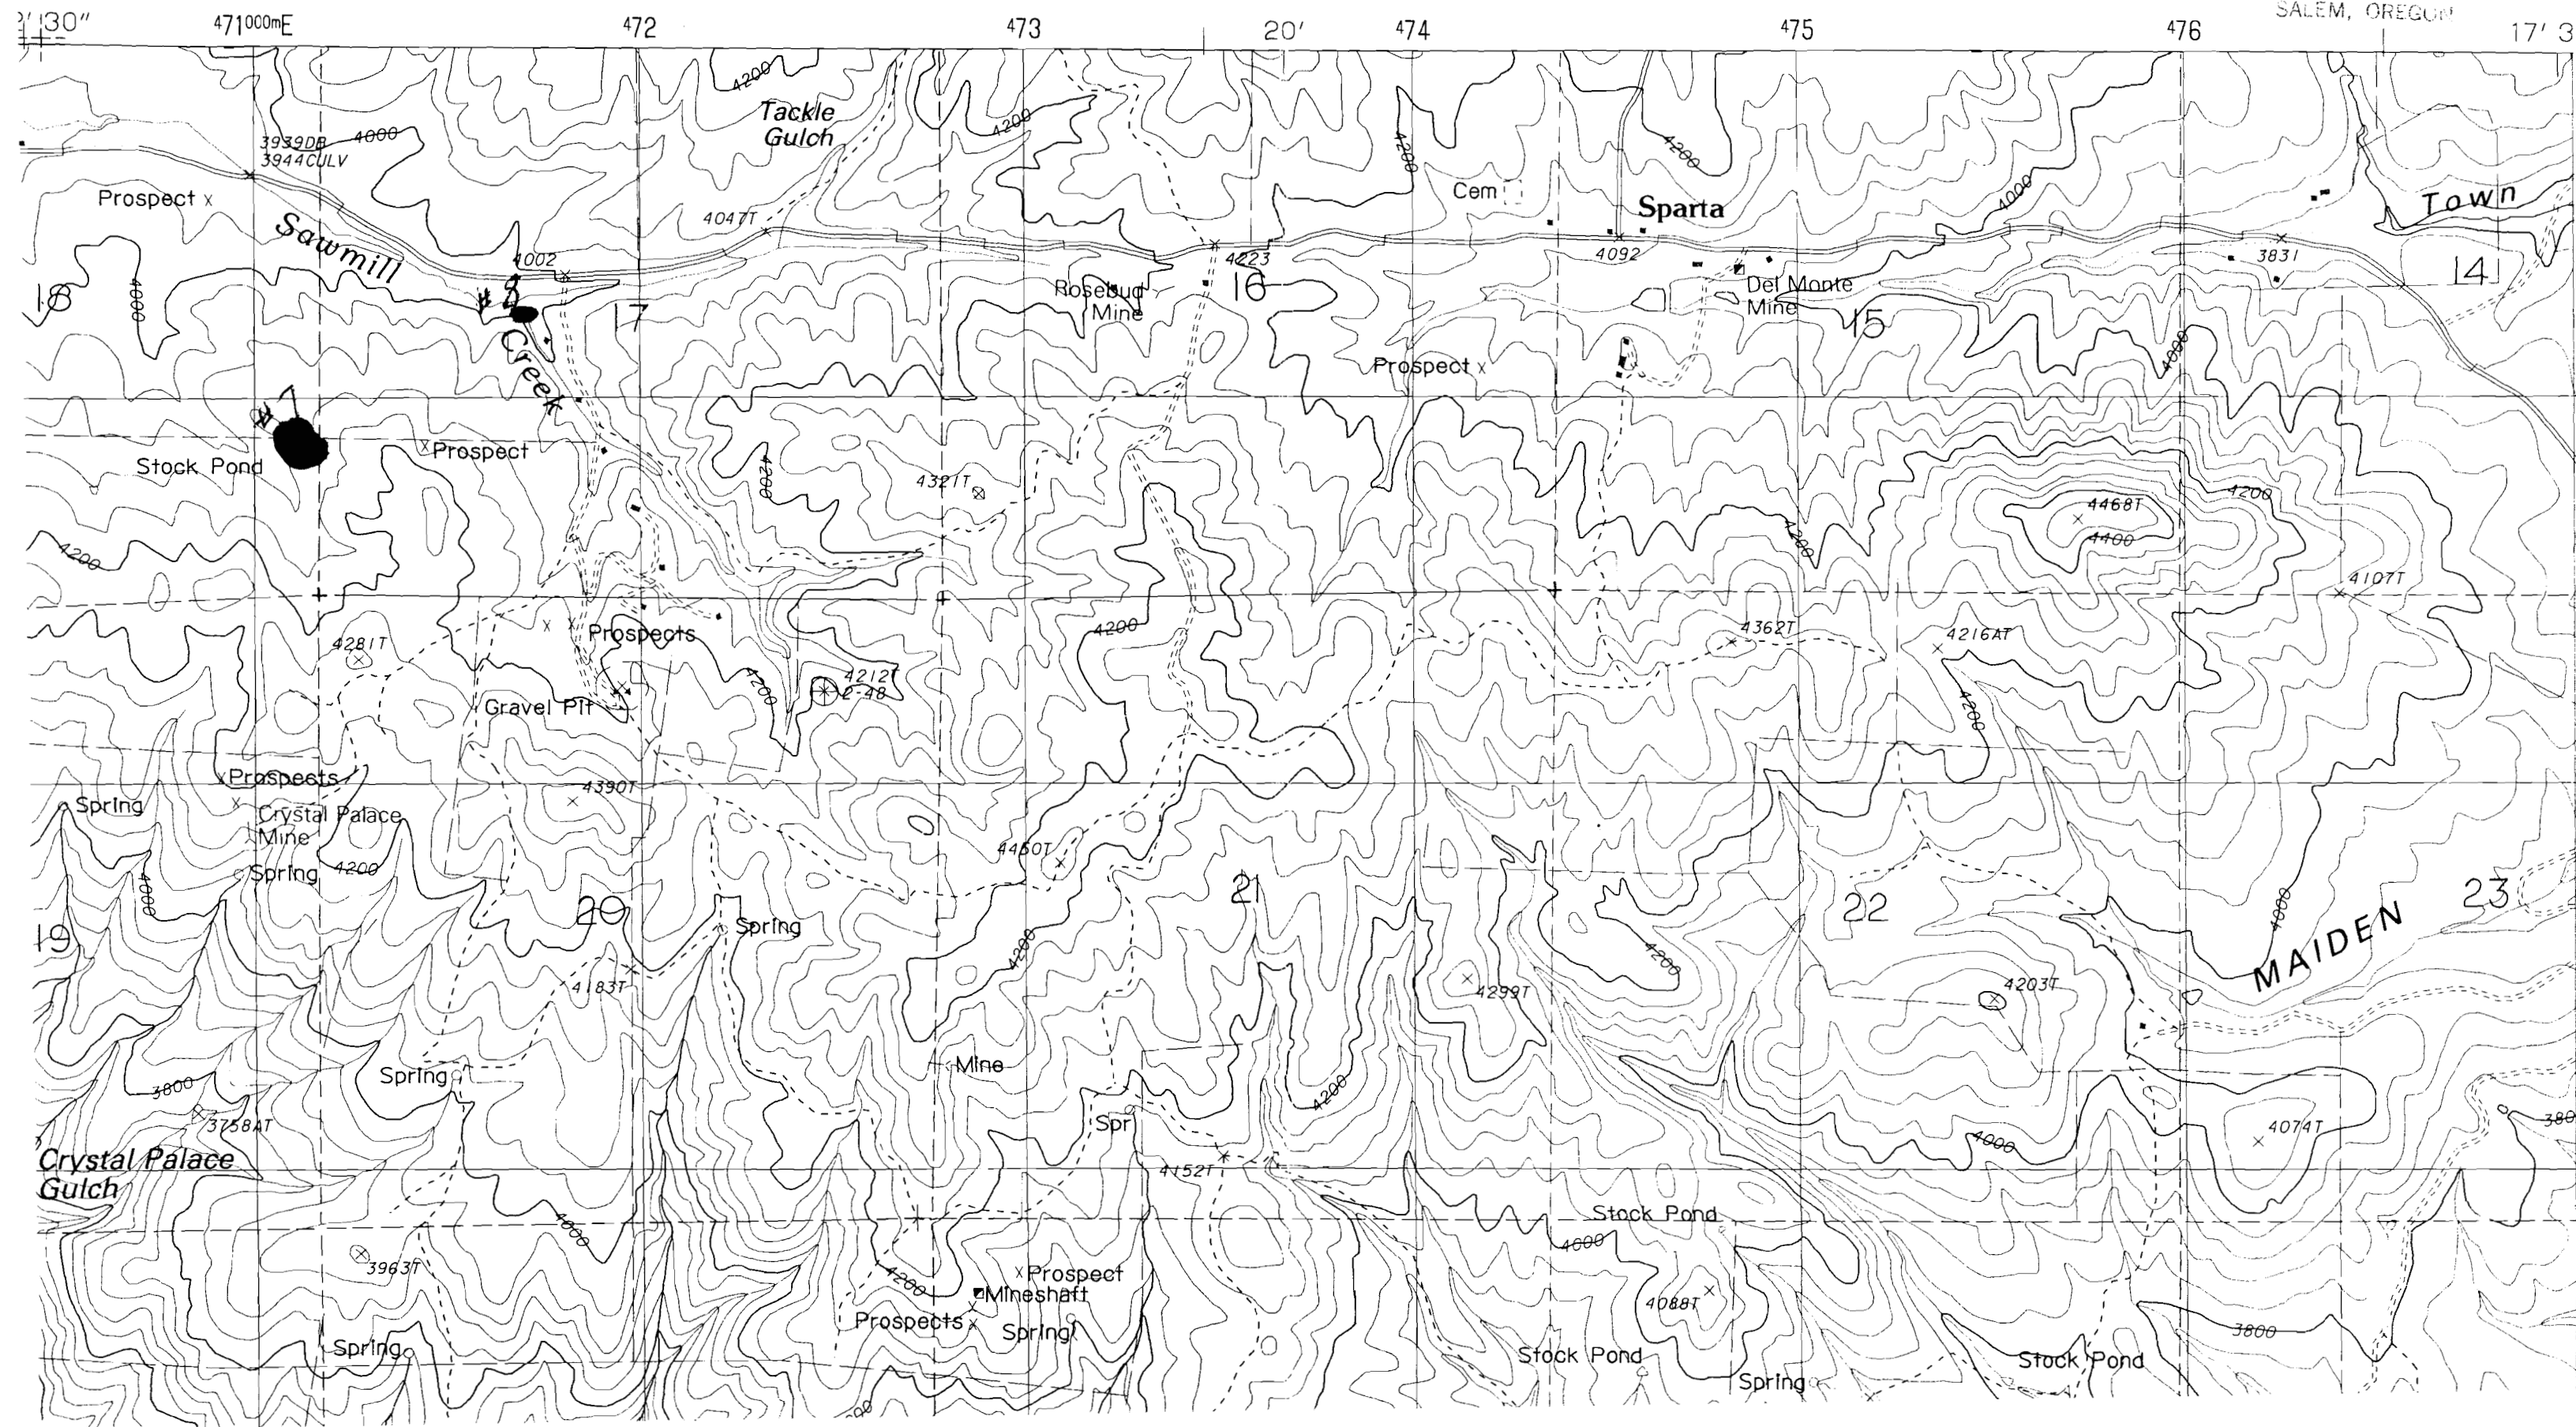

~~_____~~

REFERENCES

WATER RESOURCES DEPT
SALEM, OREGON

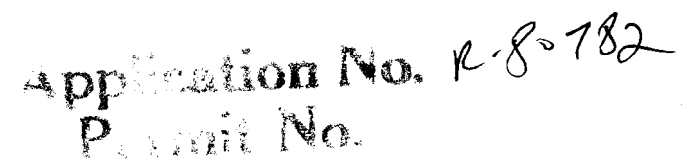

72086

