


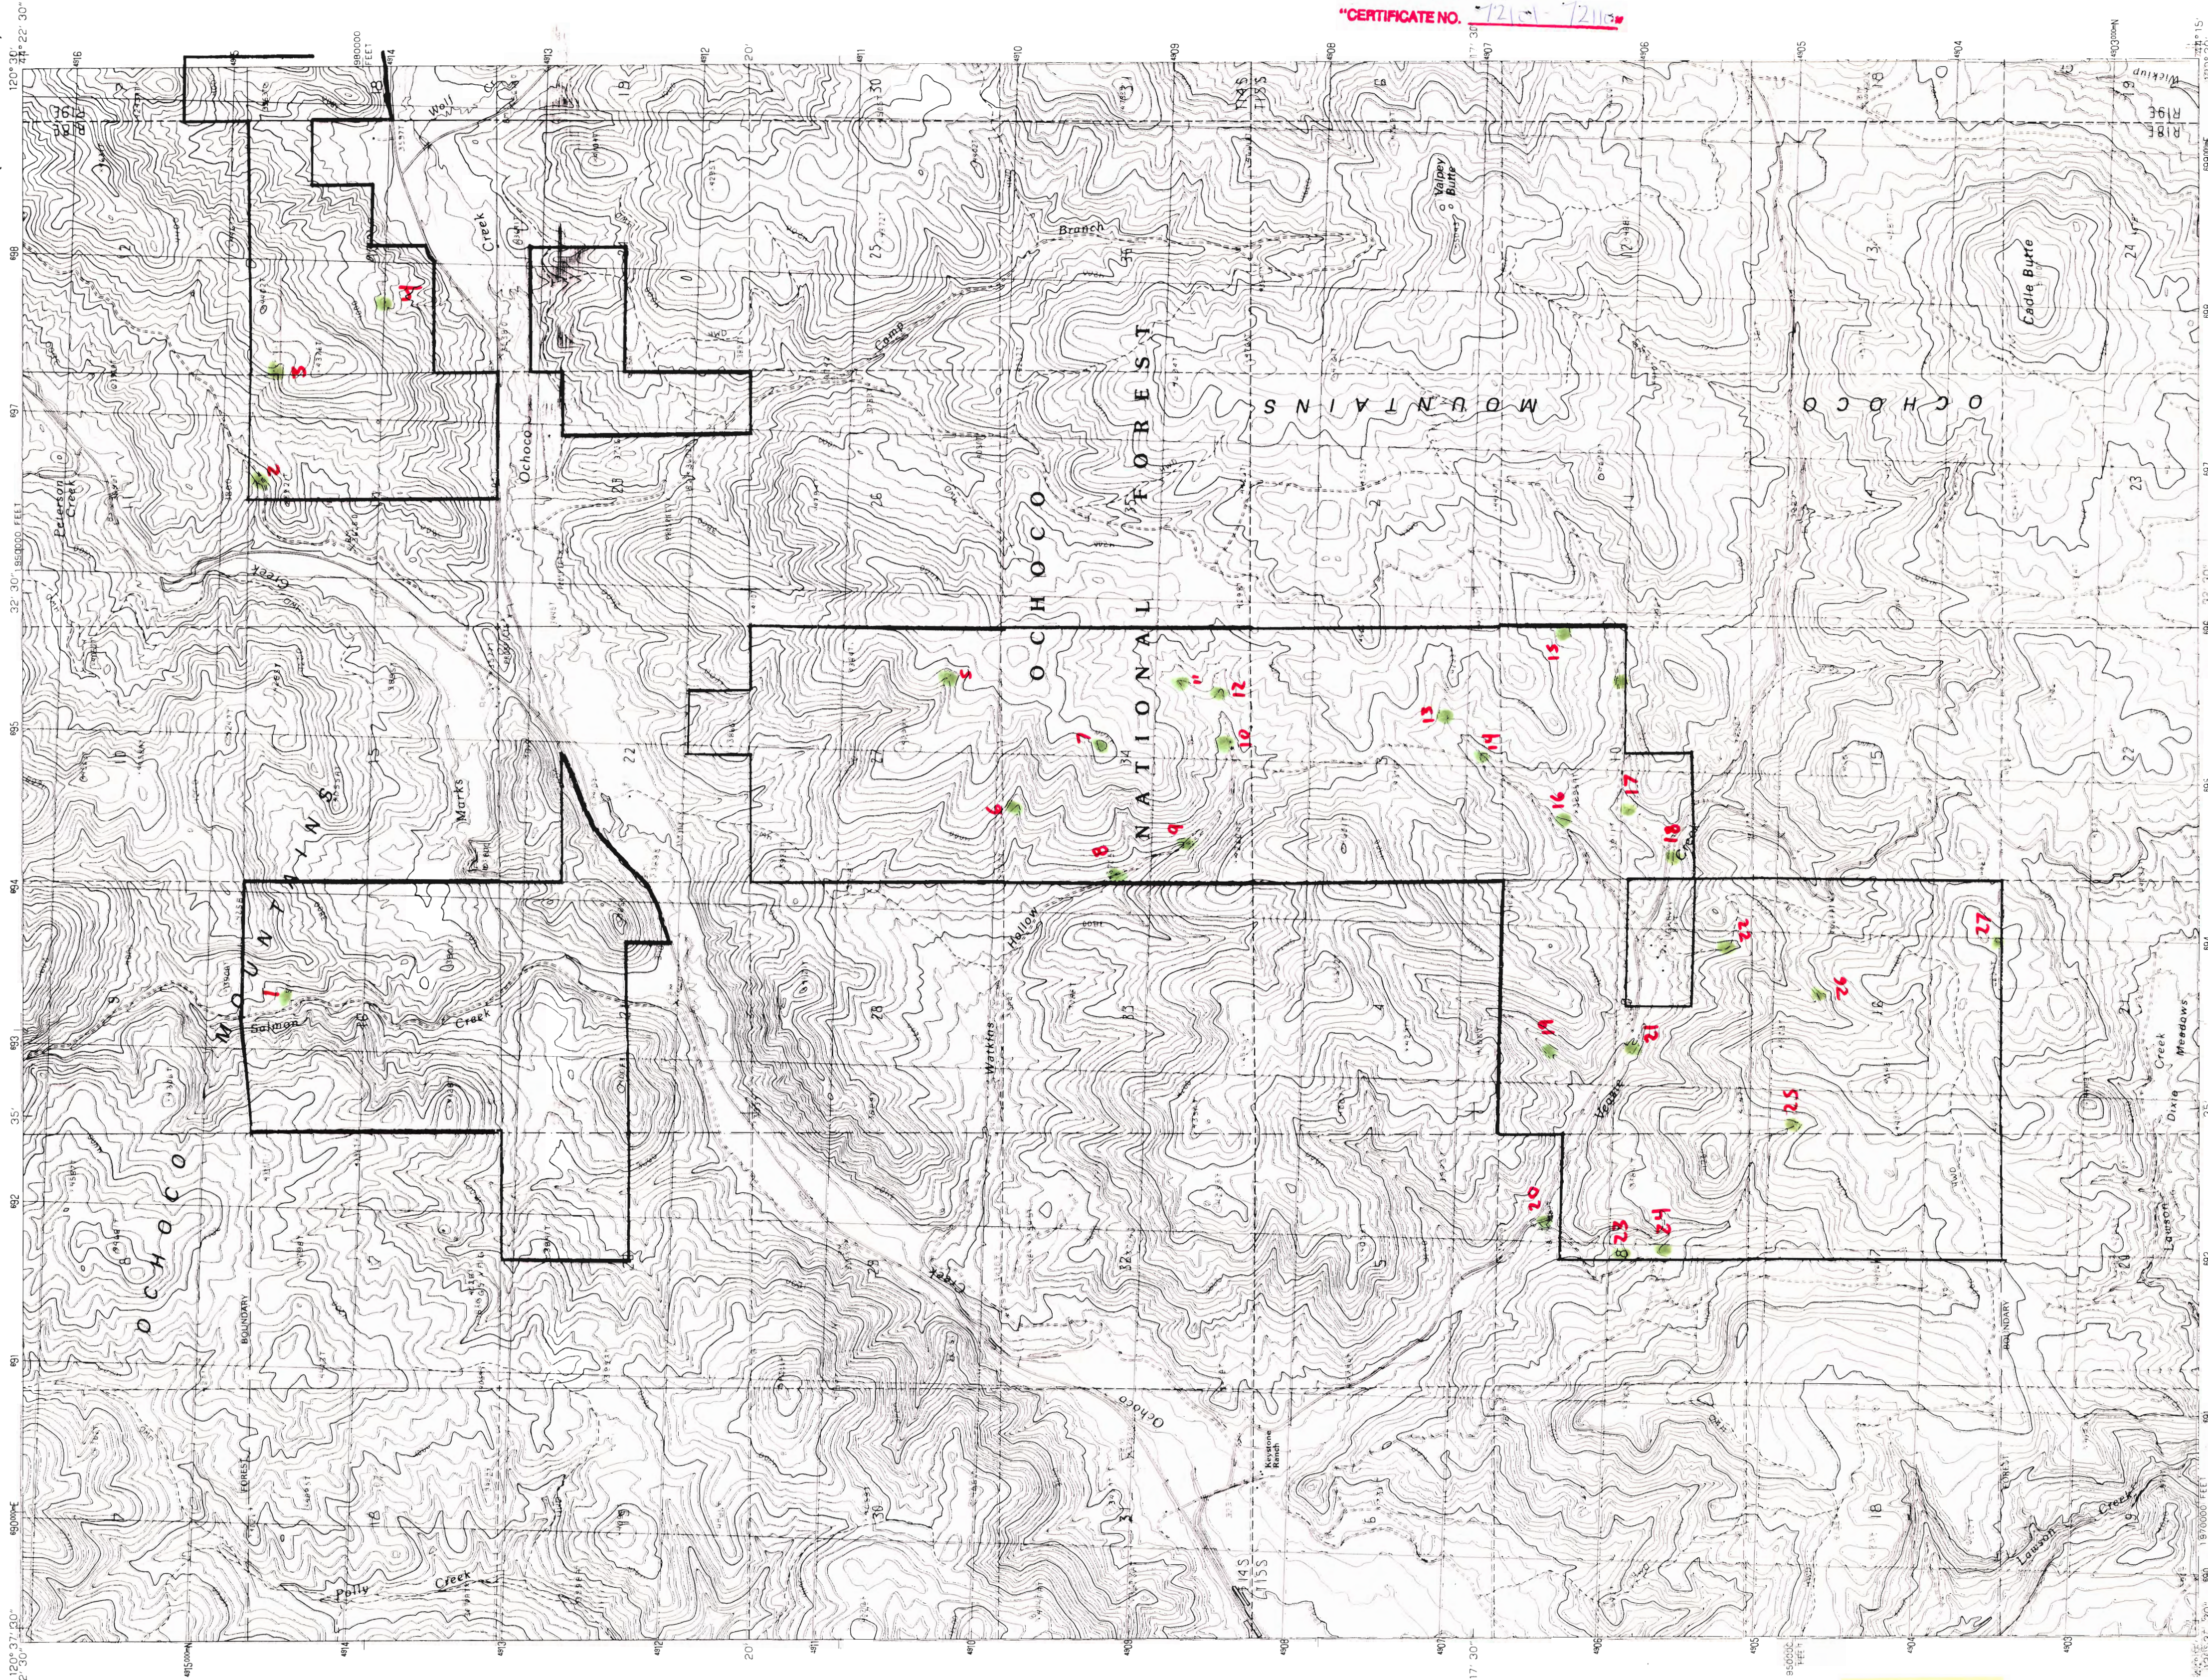

Application No. R-80892 - 80902
Permit No.
"CERTIFICATE NO. 72151-72113"

ROAD LEGEND
Improved Road
Unimproved Road
Trail
Interstate Route
U. S. Route
State Route

QUADRANGLE LOCATION							
1	2	3	4	5	6	7	8

SCALE 1:24 000
KILOMETERS
METERS
MILES
FOOT
CONTOUR INTERVAL 40 FEET
To convert meters to feet multiply by 3.2808
To convert feet to meters multiply by .3048

PROVISIONAL MAP
Produced from
manuscript drawings. Infor-
mation shown as of date of
field check.

PRODUCED BY THE UNITED STATES GEOLOGICAL SURVEY
COMPILED FROM AERIAL PHOTOGRAPHS TAKEN IN 1955 AND 1957
FIELD CHECKED 1986 MAP EDITED 1990
GEOLOGICAL SURVEY OF THE UNITED STATES
GRID 1000-METER UNIVERSAL TRANSVERSE MERCATOR
10 000-FOOT STATE GRID TICS
UTM GRID DECLINATION
VERTICAL DATUM
To place on the predicted North American Datum of 1983,
above the projection lines as shown by dashed corner ticks
(2000 meters easting, 1700 meters northing)
There may be some inclusions within the boundaries of any
Federal or State reservations shown on this map

THIS MAP COMPLETES WITH NATIONAL MAP ACCURACY STANDARDS
FOR SALE BY U. S. GEOLOGICAL SURVEY, DENVER, COLORADO 80225 OR RESTON, VIRGINIA 22092

CADLE BUTTE, OREGON
PROVISIONAL EDITION 1990
44120-C5-TF-024


Ochoco

Apps. R-80892 & R-80902

148

UNITED STATES
DEPARTMENT OF THE INTERIOR
GEOLOGICAL SURVEY

LOOKOUT MOUNTAIN QUADRANGLE
OREGON-CROOK CO.
7.5 MINUTE SERIES (TOPOGRAPHIC)

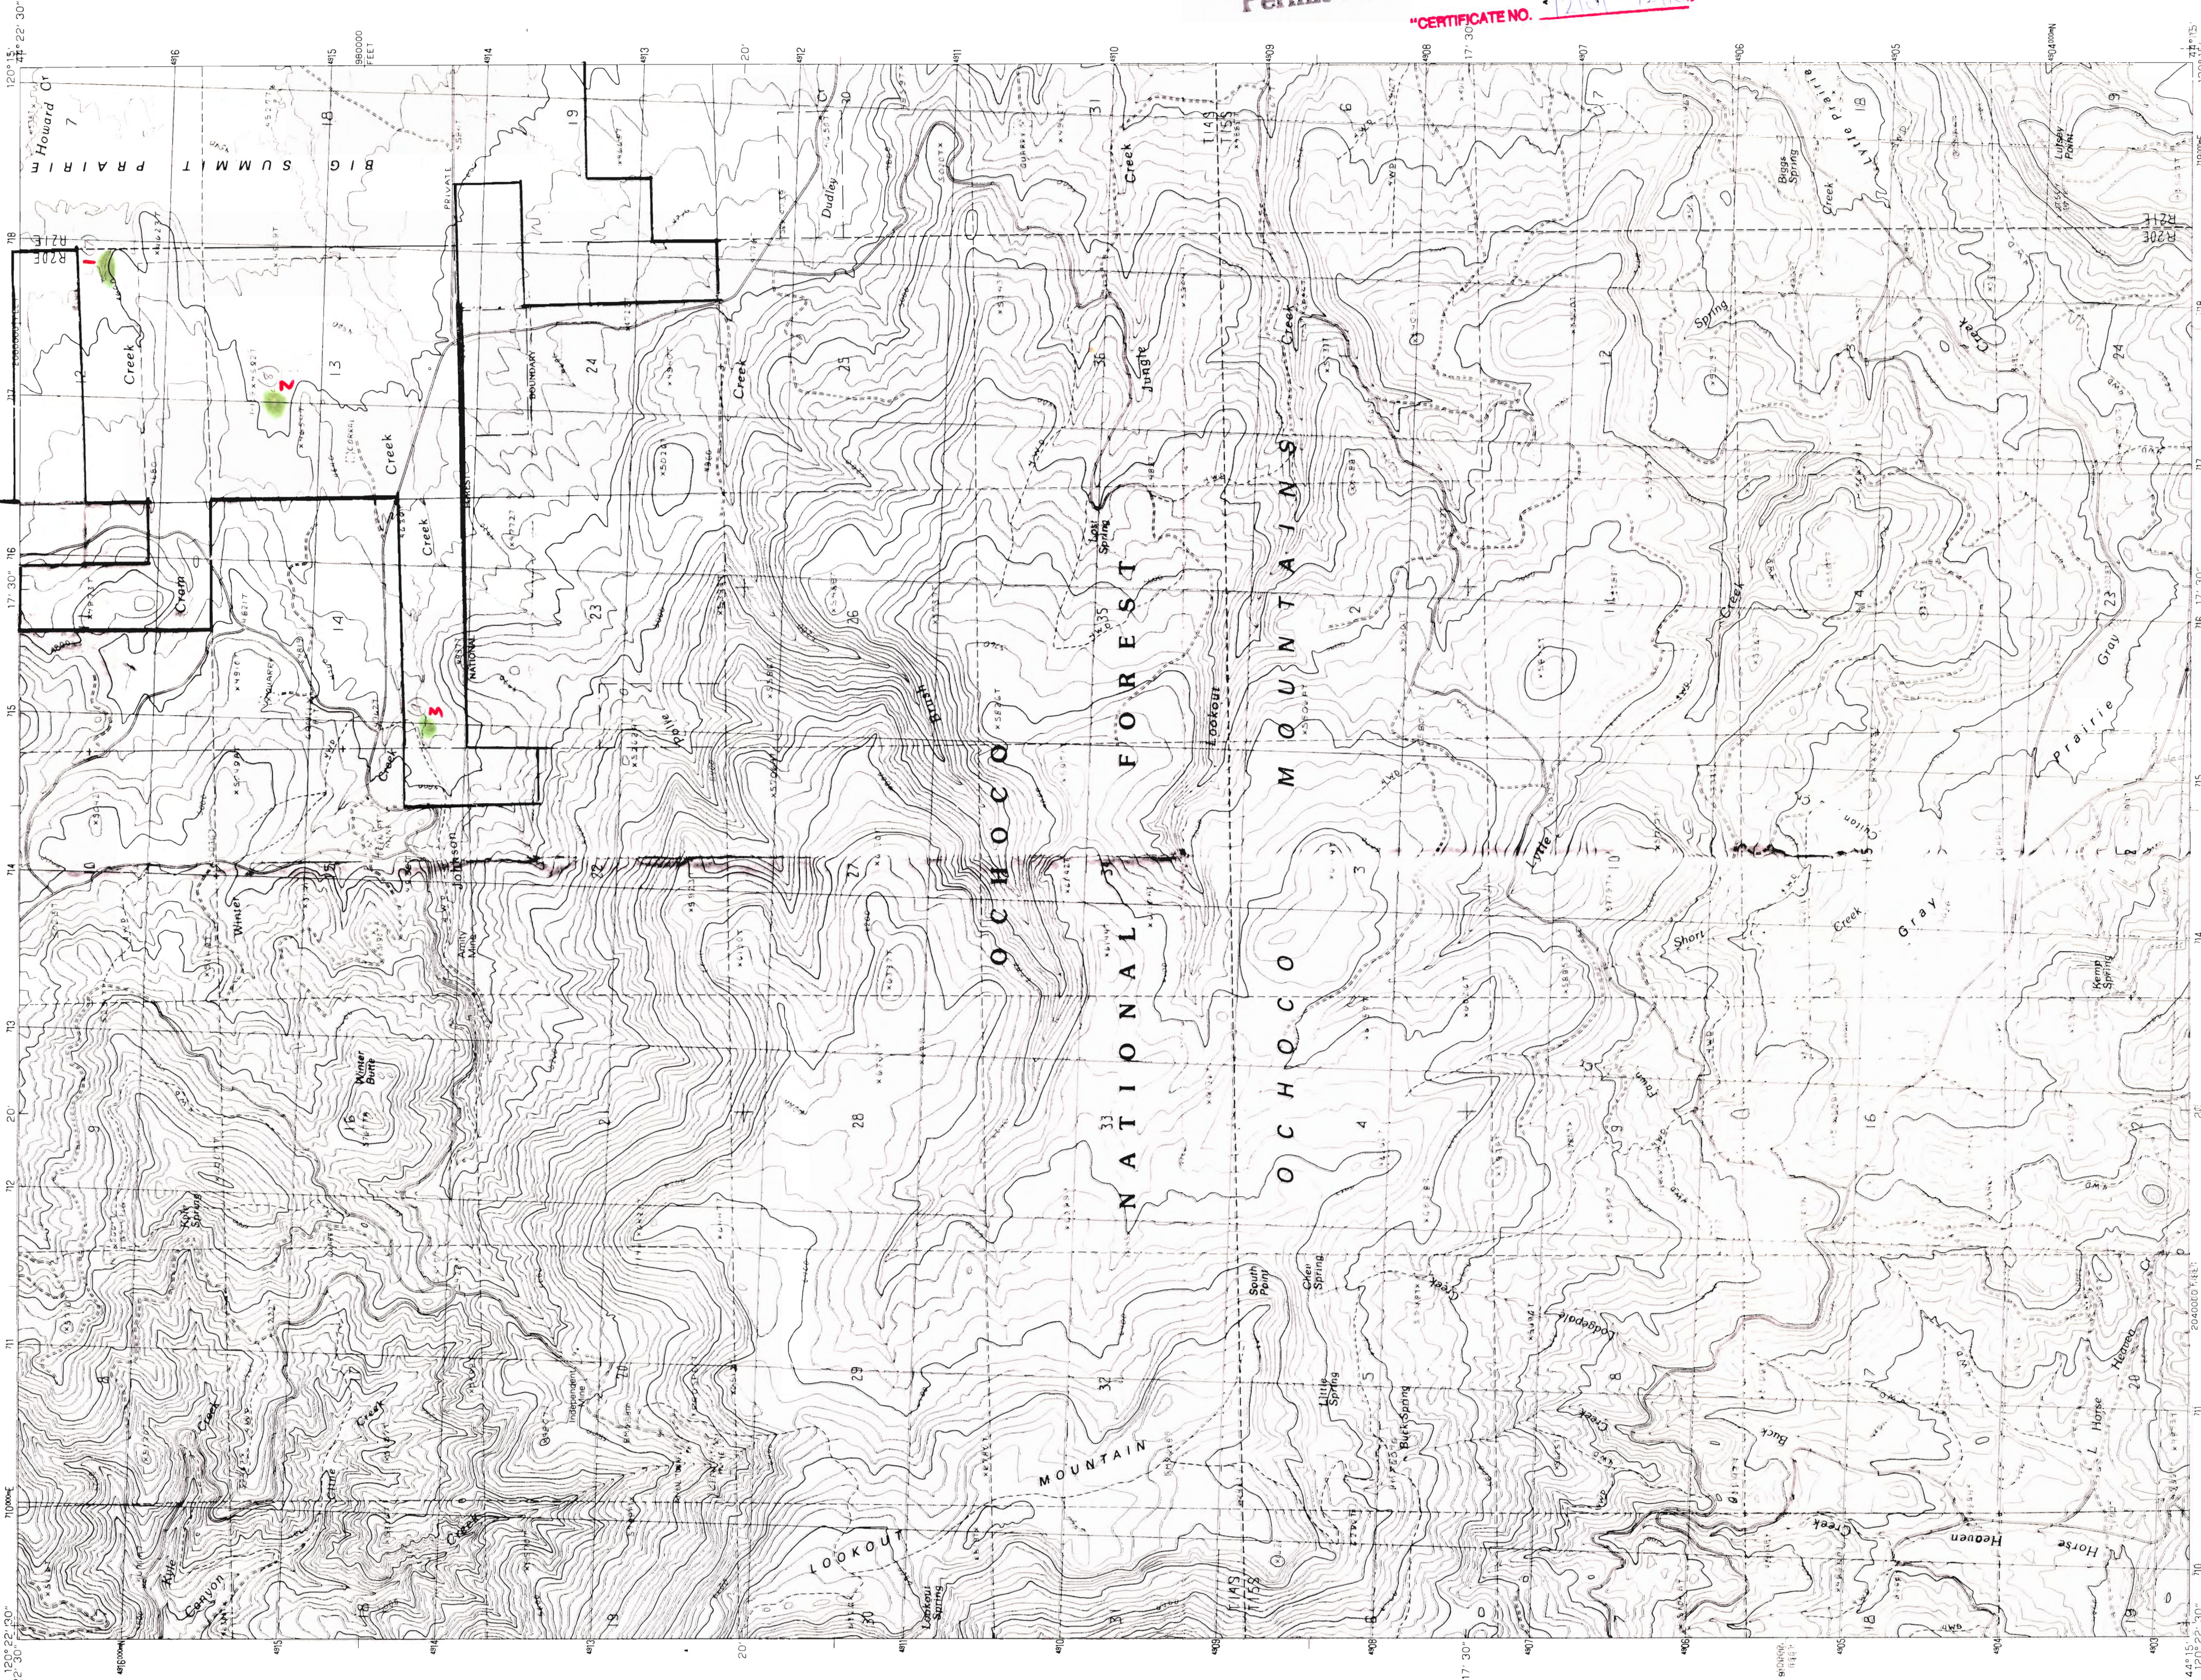

PRODUCED BY THE UNITED STATES GEOLOGICAL SURVEY
FROM AERIAL PHOTOGRAPHS TAKEN IN 1984
COMPILED FROM AERIAL PHOTOGRAPHS TAKEN IN 1984
FIELD CHECKED 1986 MAP EDITED 1986
GRID 1000 METER UNIVERSAL TRANSVERSE MERCATOR ZONE 10
10 000-FOOT STATE GRID TICS OREGON SOUTH ZONE
1983 GRID DECLINATION 18 00 EAST
VERTICAL DATUM 1927 NORTH AMERICAN DATUM
To place on the predicted North American Datum of 1983,
show the projection lines as shown by dashed corner ticks
There may be private inholdings within the boundaries of any
Federal or State reservations shown on this map

PROVISIONAL MAP
Produced from original
manuscript drawings. Infor-
mation shown as of date of
field check.

SCALE 1:24 000



CONTOUR INTERVAL 40 FEET
SUPPLEMENTARY CONTOUR INTERVAL 20 FEET
To convert meters to feet multiply by 3.2808
To convert feet to meters multiply by .3048

QUADRANGLE LOCATION	1	2	3	4	5	6	7	8	

ROAD LEGEND

Improved Road
Unimproved Road
Trail

Interstate Route
U.S. Route
State Route

LOOKOUT MOUNTAIN, OREGON
PROVISIONAL EDITION 1990

FOR SALE BY U.S. GEOLOGICAL SURVEY, DENVER, COLORADO 80225, OR RESTON, VIRGINIA 22092

Application No. R-80892 + R-80902
Permit No.
"CERTIFICATE NO. 12101 12110"


RECEIVED
DEC 30 1994
U.S. GEOLOGICAL SURVEY
SALEM, OREGON

Apps. R-80892 & R-80902

148


UNITED STATES
DEPARTMENT OF THE INTERIOR
GEOLOGICAL SURVEY

GRAYLOCK BUTTE QUADRANGLE
OREGON-GRANT CO.
7.5 MINUTE SERIES (TOPOGRAPHIC)

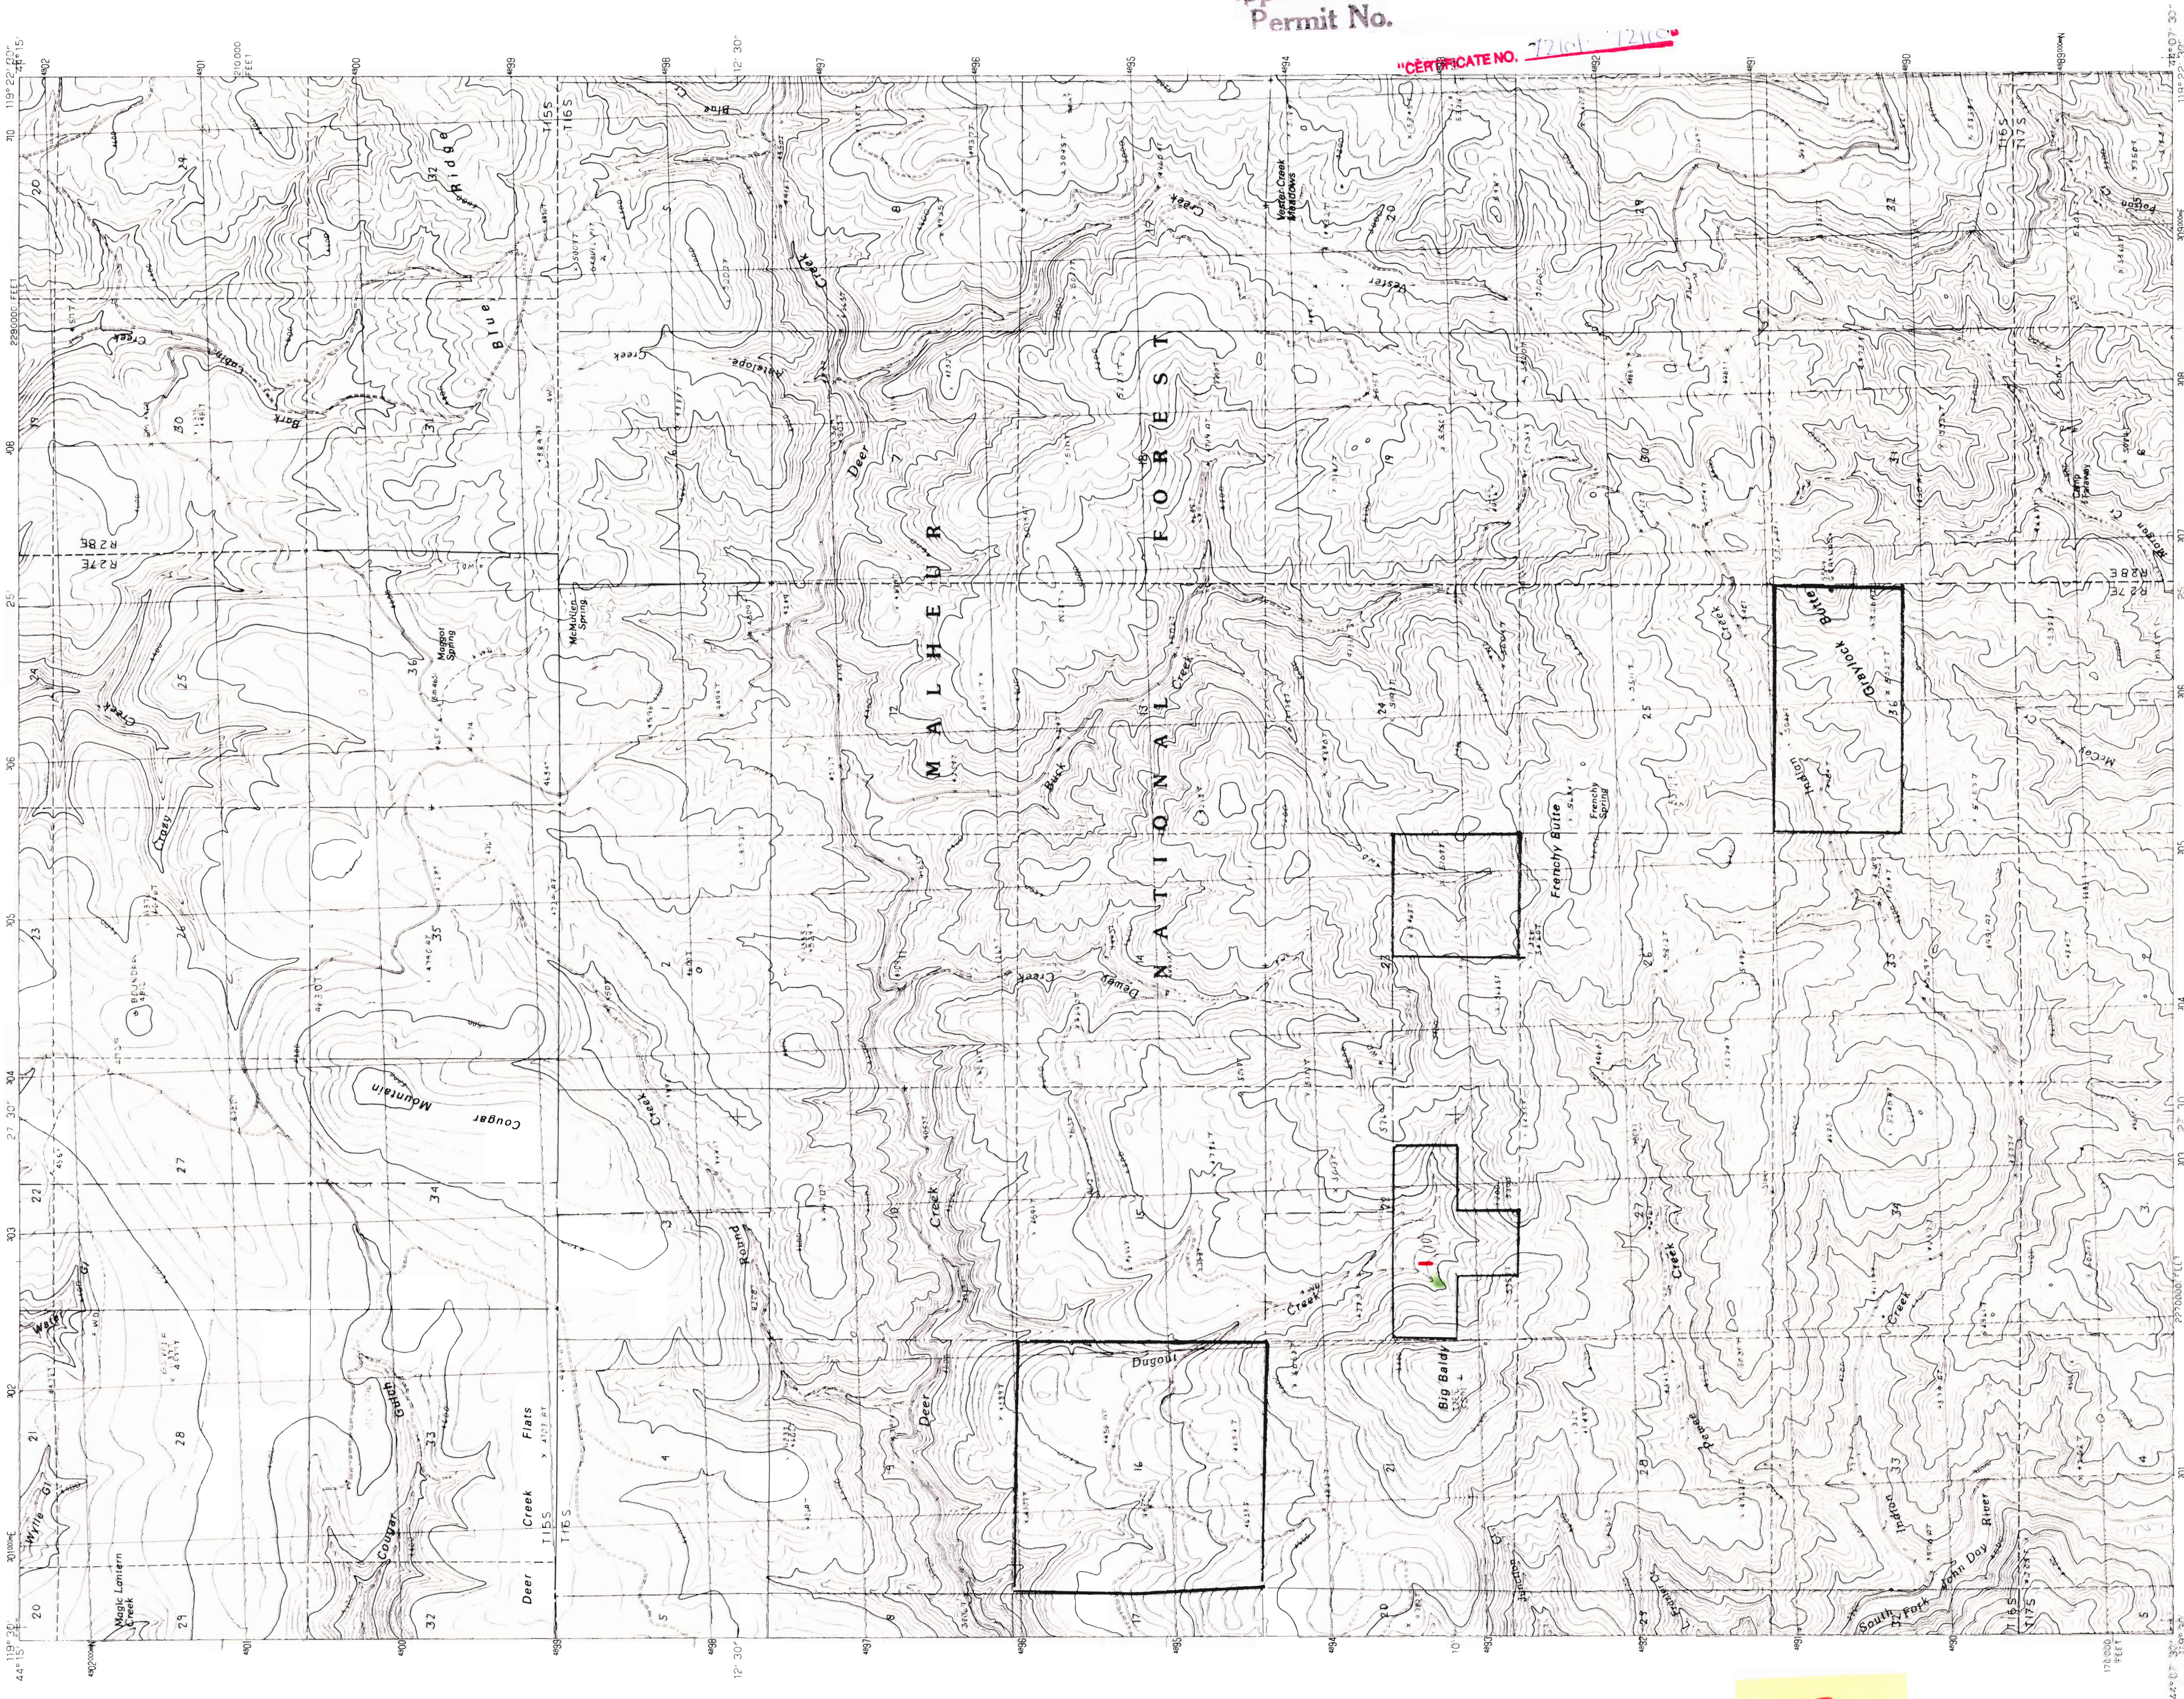

PRODUCED BY THE UNITED STATES GEOLOGICAL SURVEY
CONTROL BY: USGS AND NOS-NOAA
DERIVED FROM: AERIAL PHOTOGRAPHS TAKEN 1984
PROJECTION: UTM 12N, NAD 83, LAMBERT CONFORMAL CONIC
GRID: 1000-METER UNIVERSAL TRANSVERSE MERCATOR, ZONE 11
UTM GRID DECLINATION: OREGON, 1983, 17 30 EAST
1990 MAGNETIC NORTH DECLINATION: OREGON, 1983, 17 30 EAST
HORIZONTAL DATUM: NATIONAL GEODESIC SURVEY, 1983 NORTH AMERICAN DATUM
To place on the predicted North American Datum of 1983,
move the projection lines as shown by dashed corner ticks
(19 meters north and 86 meters east)
There may be private inholdings within the boundaries of any
Federal or State reservations shown on this map.

PROVISIONAL MAP
Produced from original
manuscript drawings. Infor-
mation shown as of date of
photography.

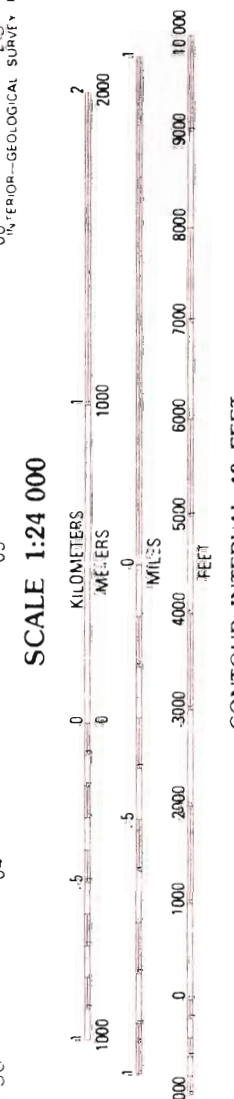

ROAD LEGEND

Improved Road	Interstate Route	U S Route	State Route
Unimproved Road			
Trail			

QUADRANGLE LOCATION

1	2	3	4	5	6	7	8
Aldrich Gulch	Big Weasel Springs	Supple Butte	Flaming Butte	Izee	Levee Creek		

ADJOINING 7.5 QUADRANGLE NAMES


GRAYLOCK BUTTE, OREGON
PROVISIONAL EDITION 1990
44119-B4-TF-024

Application No. R-80892 - R-80902
Permit No.

CERTIFICATE NO. 72161-72162

148


UNITED STATES
DEPARTMENT OF THE INTERIOR
GEOLOGICAL SURVEY

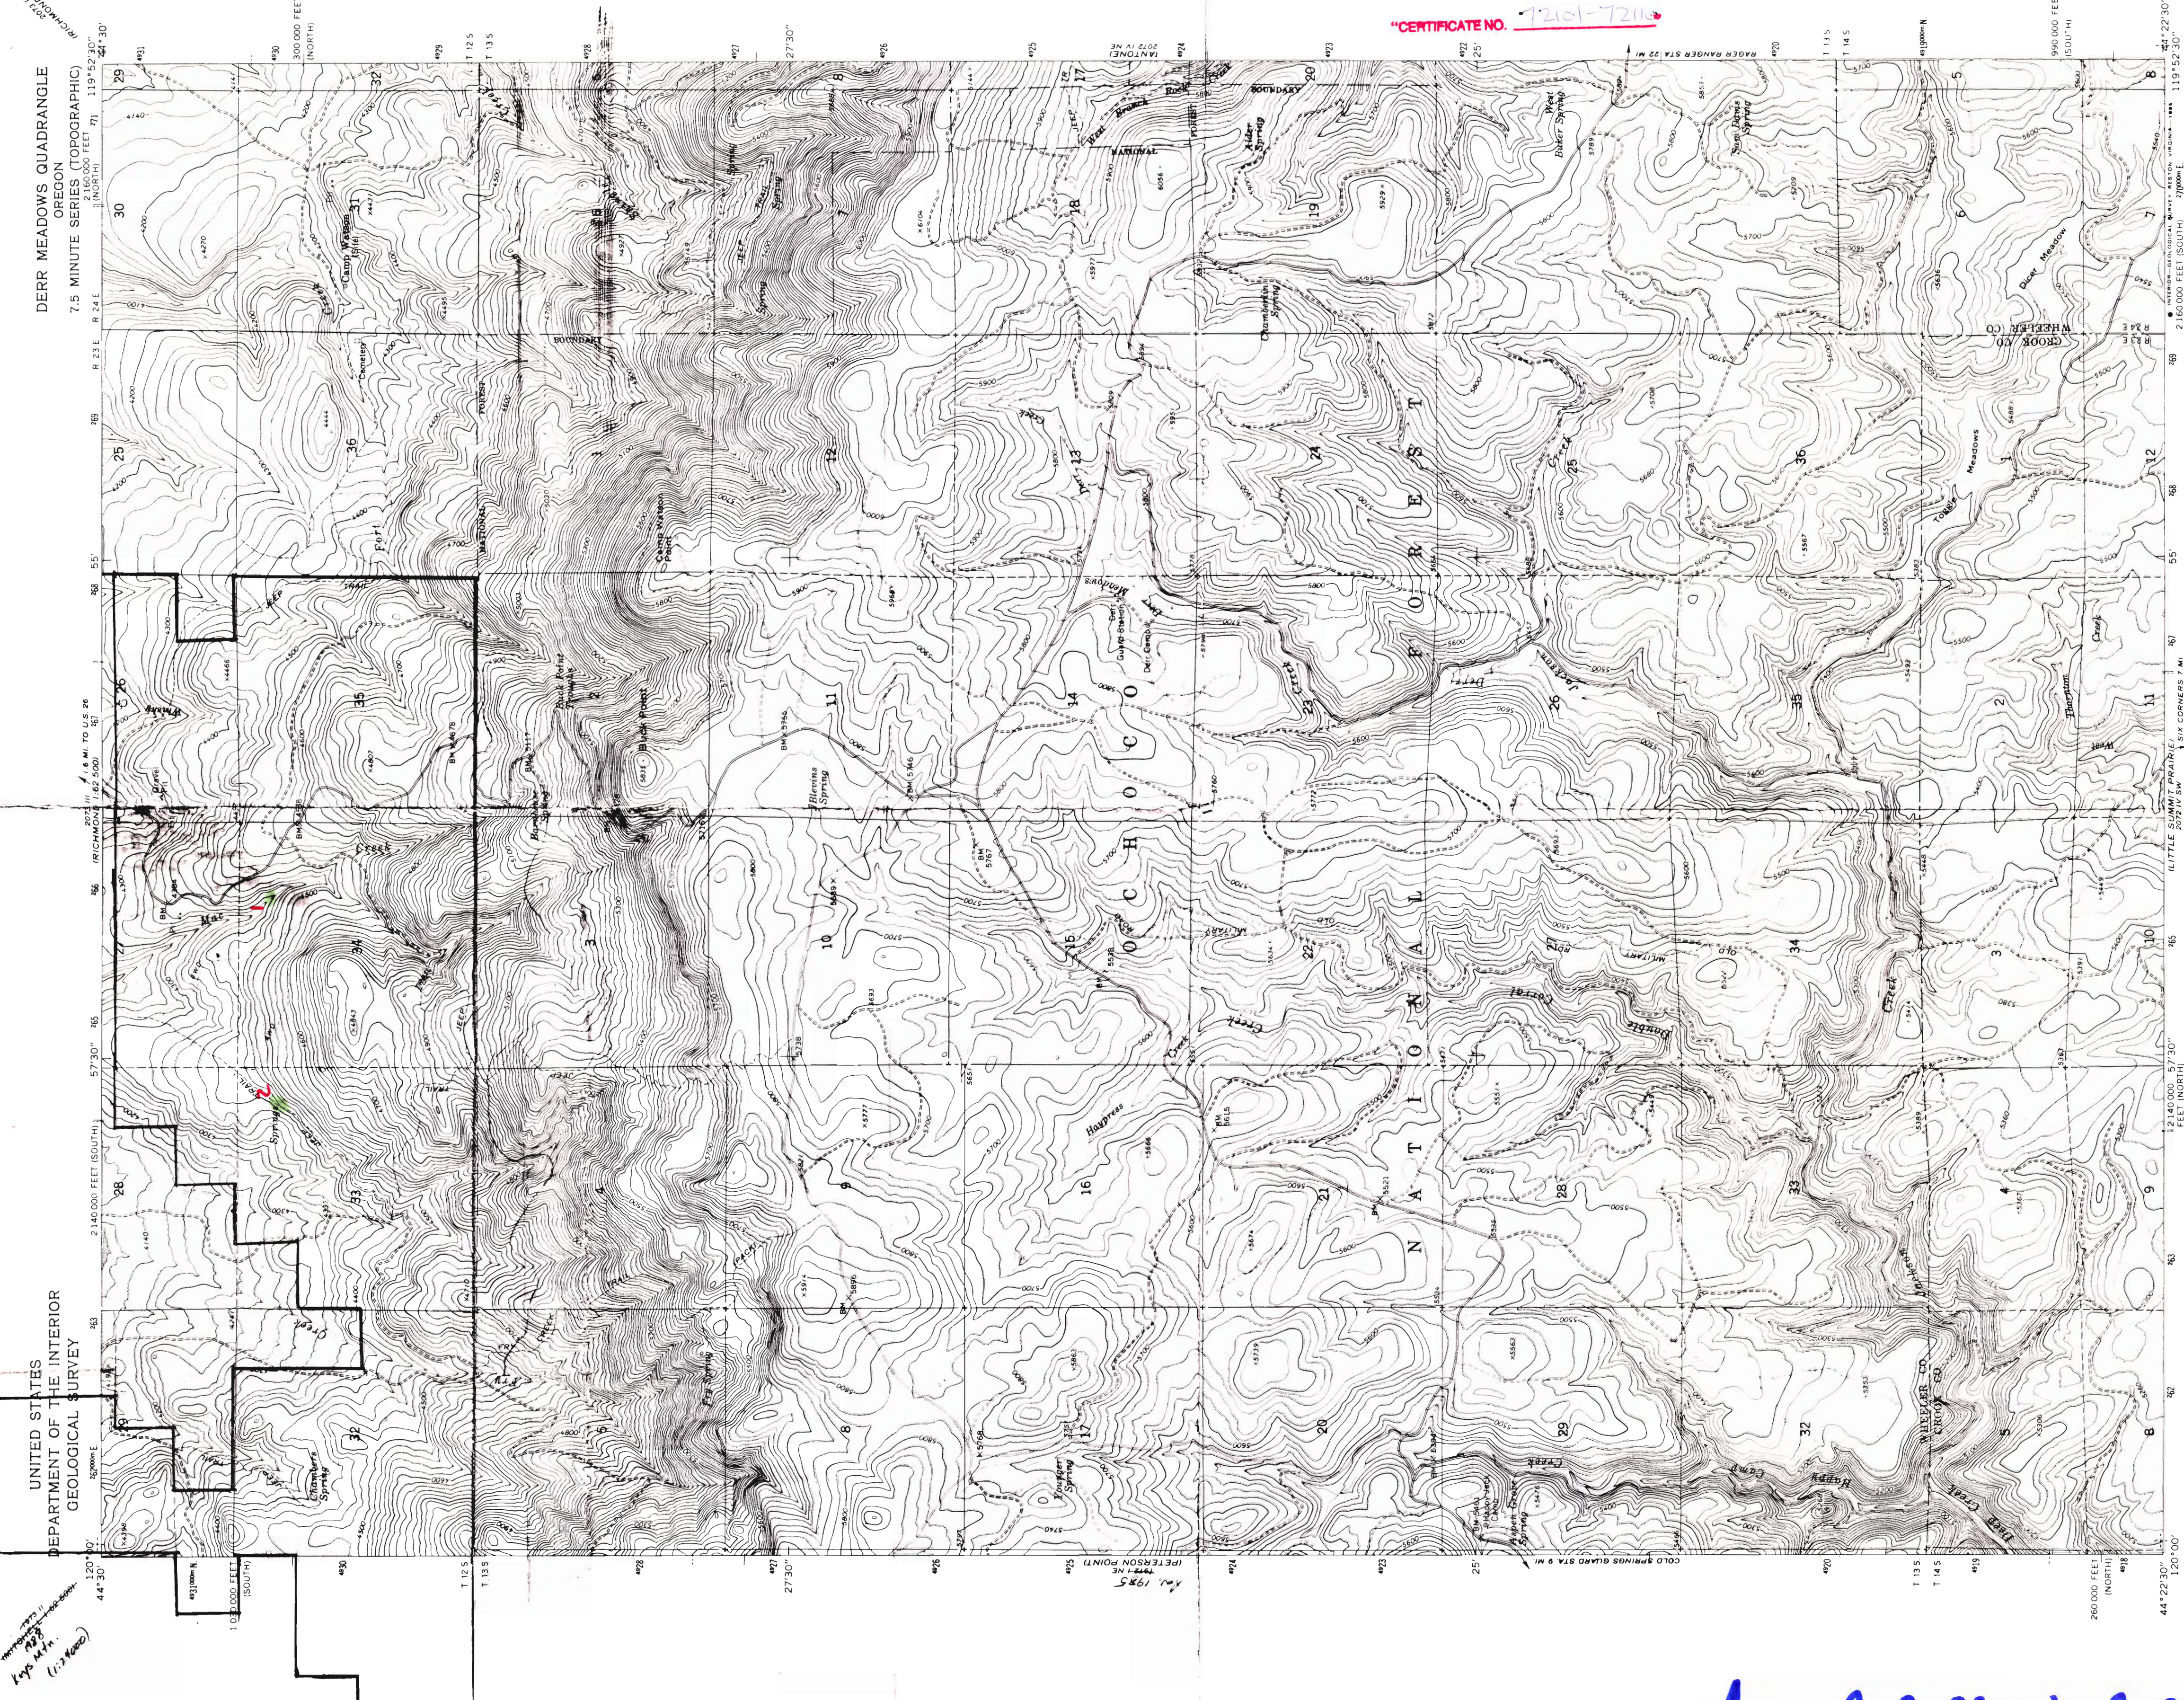

2021 11 16 10:00

Application R-80892 & R-80902
Permit No.

"CERTIFICATE NO. 72101-72110"

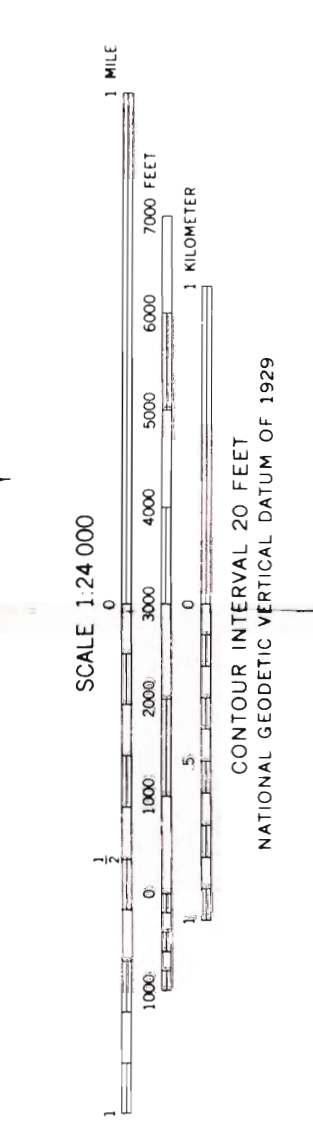

ROAD CLASSIFICATION
Light duty
Unimproved dirt



DERR MEADOWS, OREG.
44119 D9-1E 024
1966
PHOTOREVISED 1985
DMA 2072 IV NW-SERIES 1982

THIS MAP COMPLEIES WITH NATIONAL MAP ACCURACY STANDARDS
FOR SALE BY U.S. GEOLOGICAL SURVEY, RESTON, VIRGINIA 22092
A FOLDER DESCRIBING TOPOGRAPHIC MAPS AND SYMBOLS IS AVAILABLE ON REQUEST

Maped, edited, and published by the Geological Survey
Control by USGS and NOS/NOAA
Topography by photogrammetric methods from aerial
photographs taken 1959. Field checked 1965
Polyconic projection. 1927 North American datum
10,000 foot zones based on Oregon coordinate system,
north and south zones
1000-meter Universal Transverse Mercator grid ticks,
zone 11, shown in blue
To place on the predicted North American Datum 1983
move the projection lines 19 meters north and
87 meters east as shown by dashed corner ticks
Fine red dashed lines indicate selected fence lines
Where omitted, land lines have not been established
There may be private inholdings within the boundaries of
the National or State reservations shown on this map


DEC 3 0 1954
WATER RESOURCES
SALEM, OREGON

Apps. R-80892 & R-80902

148

UNITED STATES
DEPARTMENT OF THE INTERIOR
GEOLOGICAL SURVEY

COMMITTEE CREEK QUADRANGLE
OREGON-CROOK CO.
7.5 MINUTE SERIES (TOPOGRAPHIC)



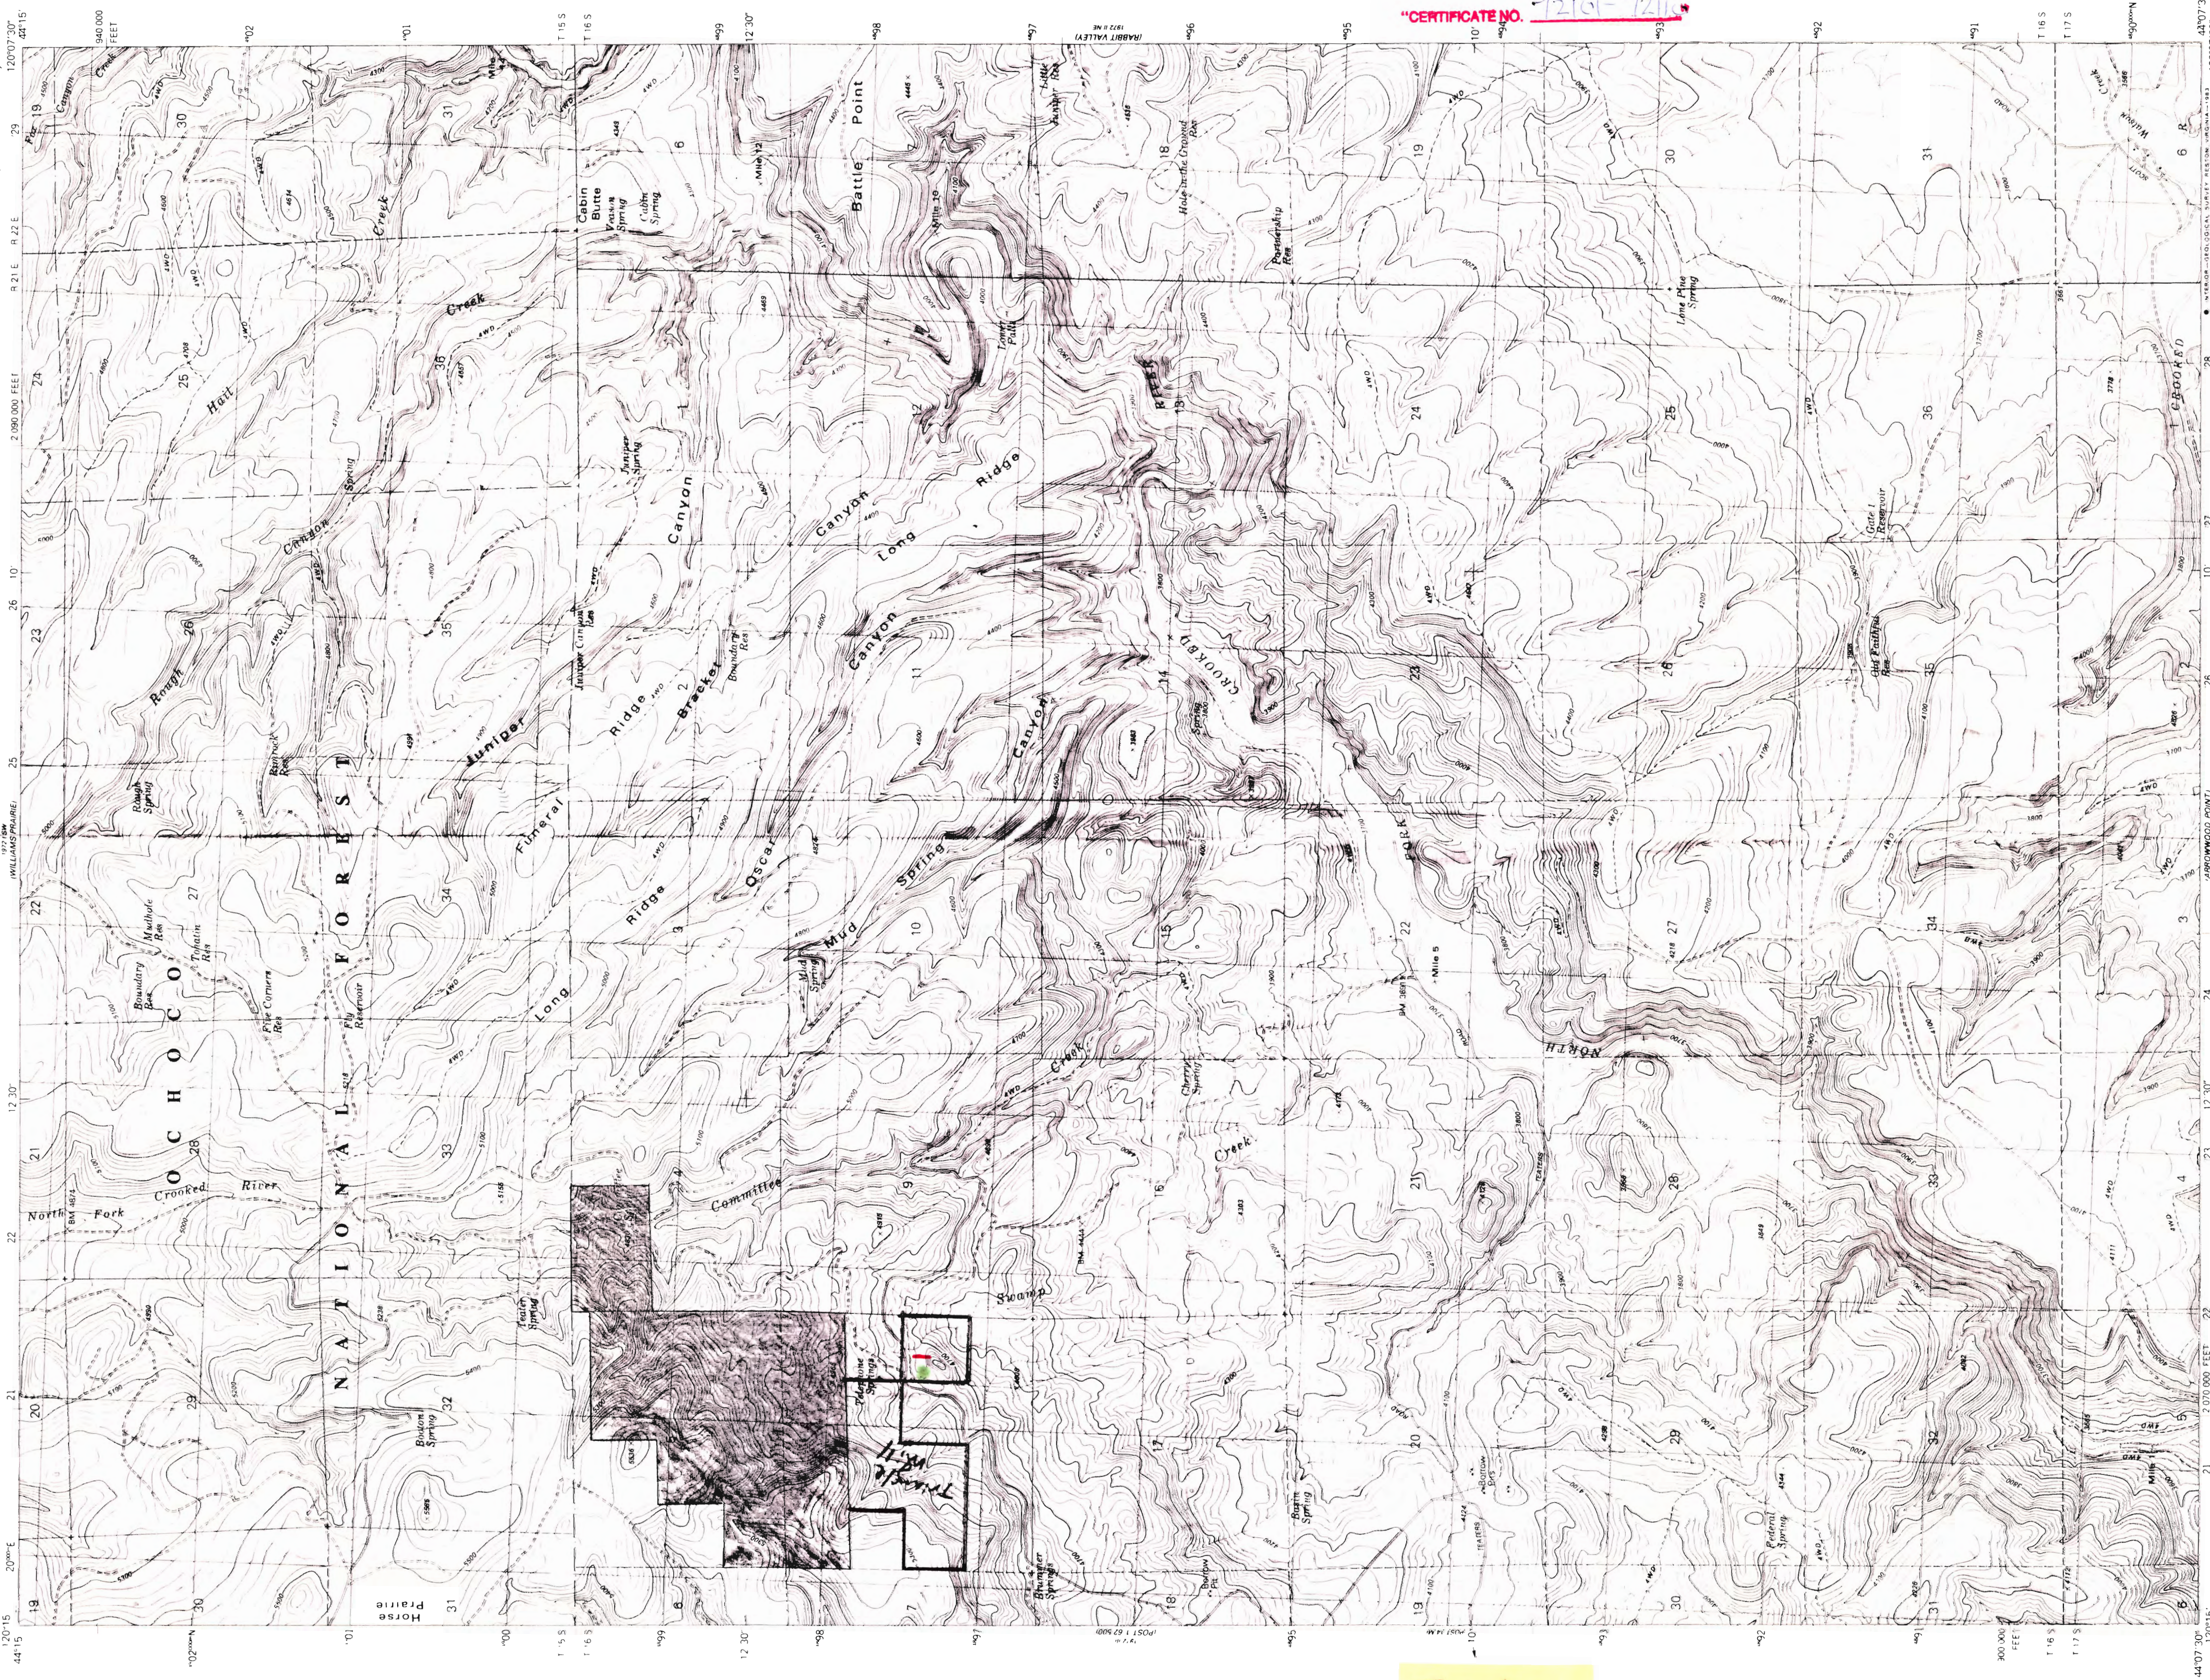


Application No. R-80892 thru R-80902
Permit No.
"CERTIFICATE NO. 72101-72111"

S. Ochoco
Triangle
mill

Apps. R-80892 & R-80902

Mapped, edited, and published by the Geological Survey
Control by USGS and NOS/NOAA
Topography by photogrammetric methods from aerial photographs
taken 1974. Field checked 1977. Map edited 1983.
Projection and 10,000-foot grid ticks. Oregon coordinate
system, south zone (Lambert conformal conic)
1000-meter Universal Transverse Mercator grid, zone 10
1927 North American Datum
To place on the predicted North American Datum 1983
move the projection lines 19 meters north and
88 meters east as shown by dashed corner ticks
Fine red dashed lines indicate selected fence and field lines
where generally visible on aerial photographs
This information is unclassified
There may be private inholdings within the boundaries of
the National or State reservations shown on this map

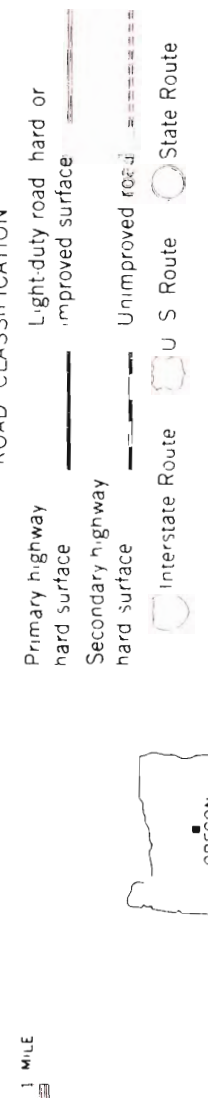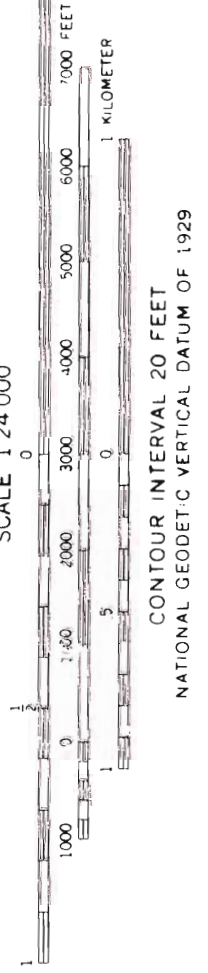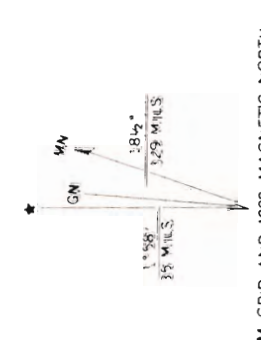

THIS MAP COMPLETES WITH NATIONAL MAP ACCURACY STANDARDS
FOR SALE BY U.S. GEOLOGICAL SURVEY, DENVER, COLORADO 80225, OR RESTON, VIRGINIA 22092
A FOLDER DESCRIBING TOPOGRAPHIC MAPS AND SYMBOLS IS AVAILABLE ON REQUEST

COMMITTEE CREEK, OREG.
1983
DMA 1972 11 NW-SERIES V992




DEC 30 1984
WATER RESOURCES
SALEM, OREGON

148

UNITED STATES
DEPARTMENT OF THE INTERIOR
GEOLOGICAL SURVEY

PRAIRIE HILL QUADRANGLE
OREGON-CROOK CO.
7.5 MINUTE SERIES (TOPOGRAPHIC)

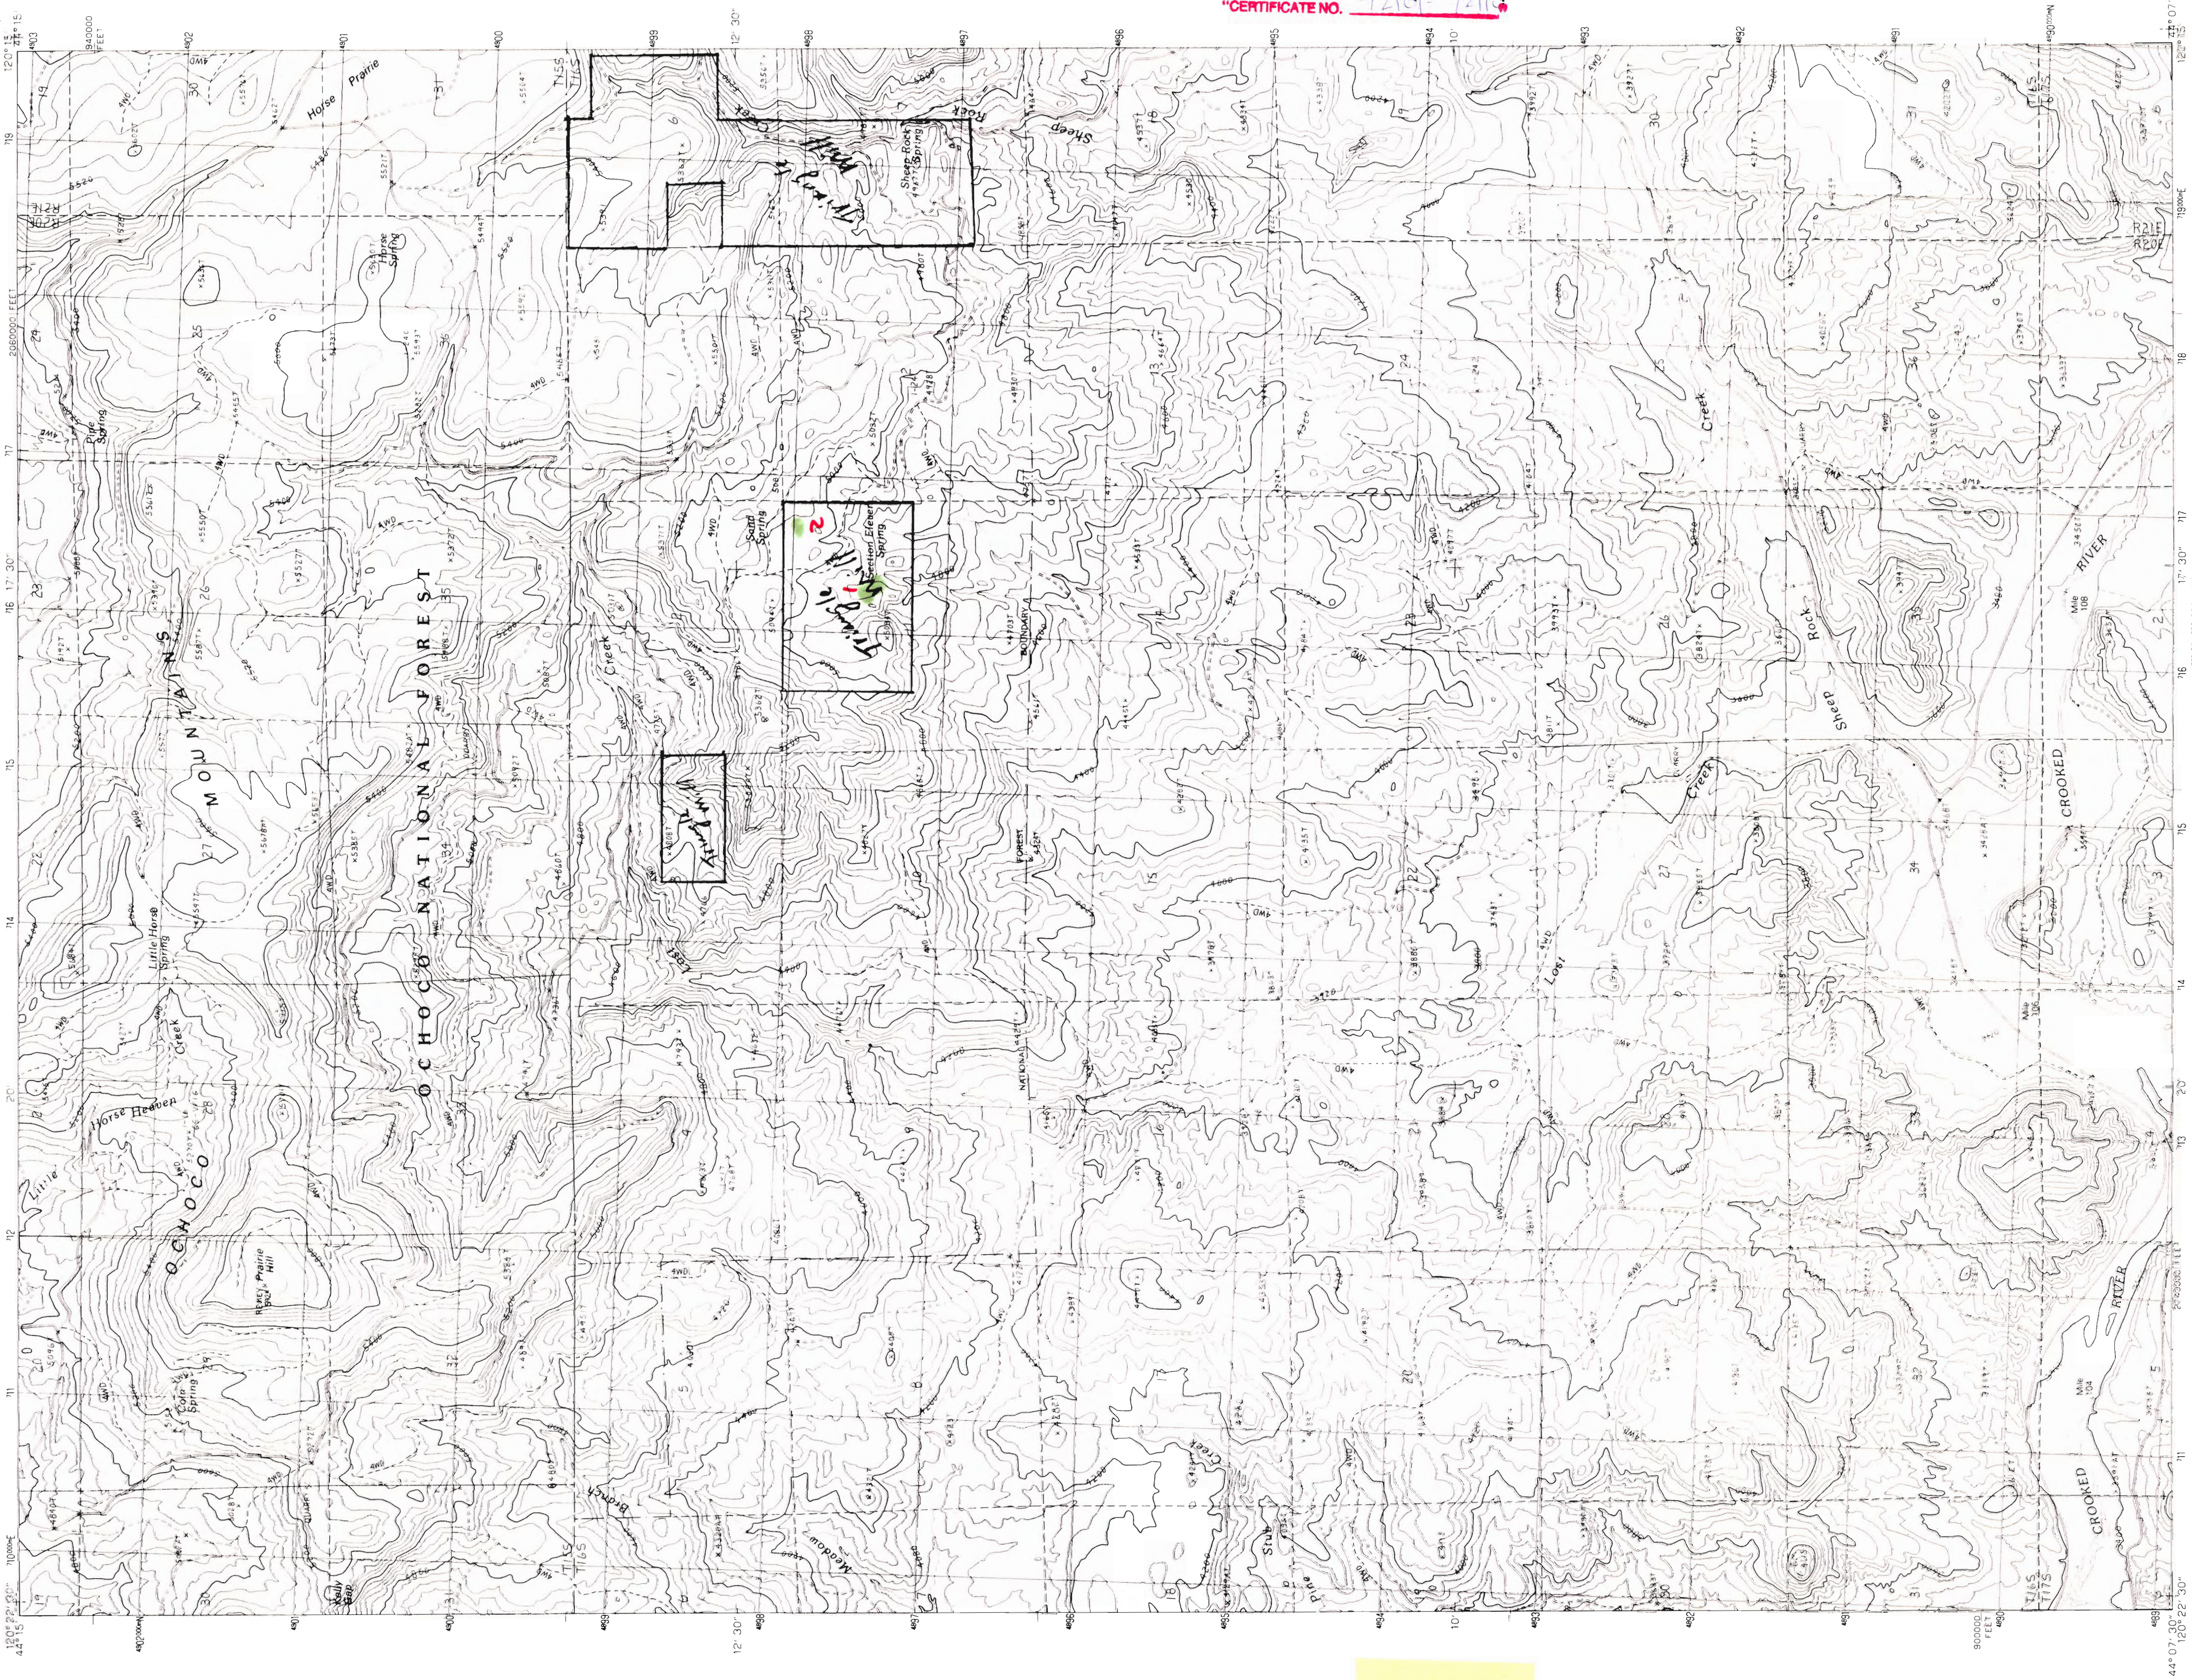

PRODUCED BY THE UNITED STATES GEOLOGICAL SURVEY
CONTROL FROM AERIAL PHOTOGRAPHS TAKEN BY THE U.S. ARMY
FIELD CHECKED: 1986 MAP EDITED: 1990
PROJECTION: UTM UNIVERSAL TRANSVERSE MERCATOR CONIC
GRID: 10,000 FOOT STATE GRID TICS SOUTH ZONE
UTM GRID DECLINATION: 1 52 EAST
1990 MAGNETIC NORTH DECLINATION: 1 52 EAST
HORIZONTAL DATUM: 1927 NORTH AMERICAN DATUM
To place on the predicted North American Datum of 1983,
move the projection lines as shown by dashed corner tie
(20 meters north and 89 meters east)
There may be private inholdings within the boundaries of the
Federal or State reservations shown on this map

PROVISIONAL MAP
Produced from original
manuscript drawings. Infor-
mation shown as of date of
field check.

SCALE 1:24 000
CONTOUR INTERVAL 40 FEET
SUPPLEMENTARY CONTOUR INTERVAL 20 FEET
To convert meters to feet multiply by 3.2808
To convert feet to meters multiply by .3048


FOR SALE BY U.S. GEOLOGICAL SURVEY, D.N.R., COLORADO 80225, G.S. RESTON, VIRGINIA 22092

ALSO SEE 7.5 QUADRANGLE NAMES

ROAD LEGEND
Improved Road
Unimproved Road
Trail



44120-B3-TF-024

Application No. R-80892-K-80892
Permit No.

"CERTIFICATE NO. 72161-72162"

RECEIVED
DEC 30 1984
WATER RESOURCES DEPT.
SALEM, OREGON

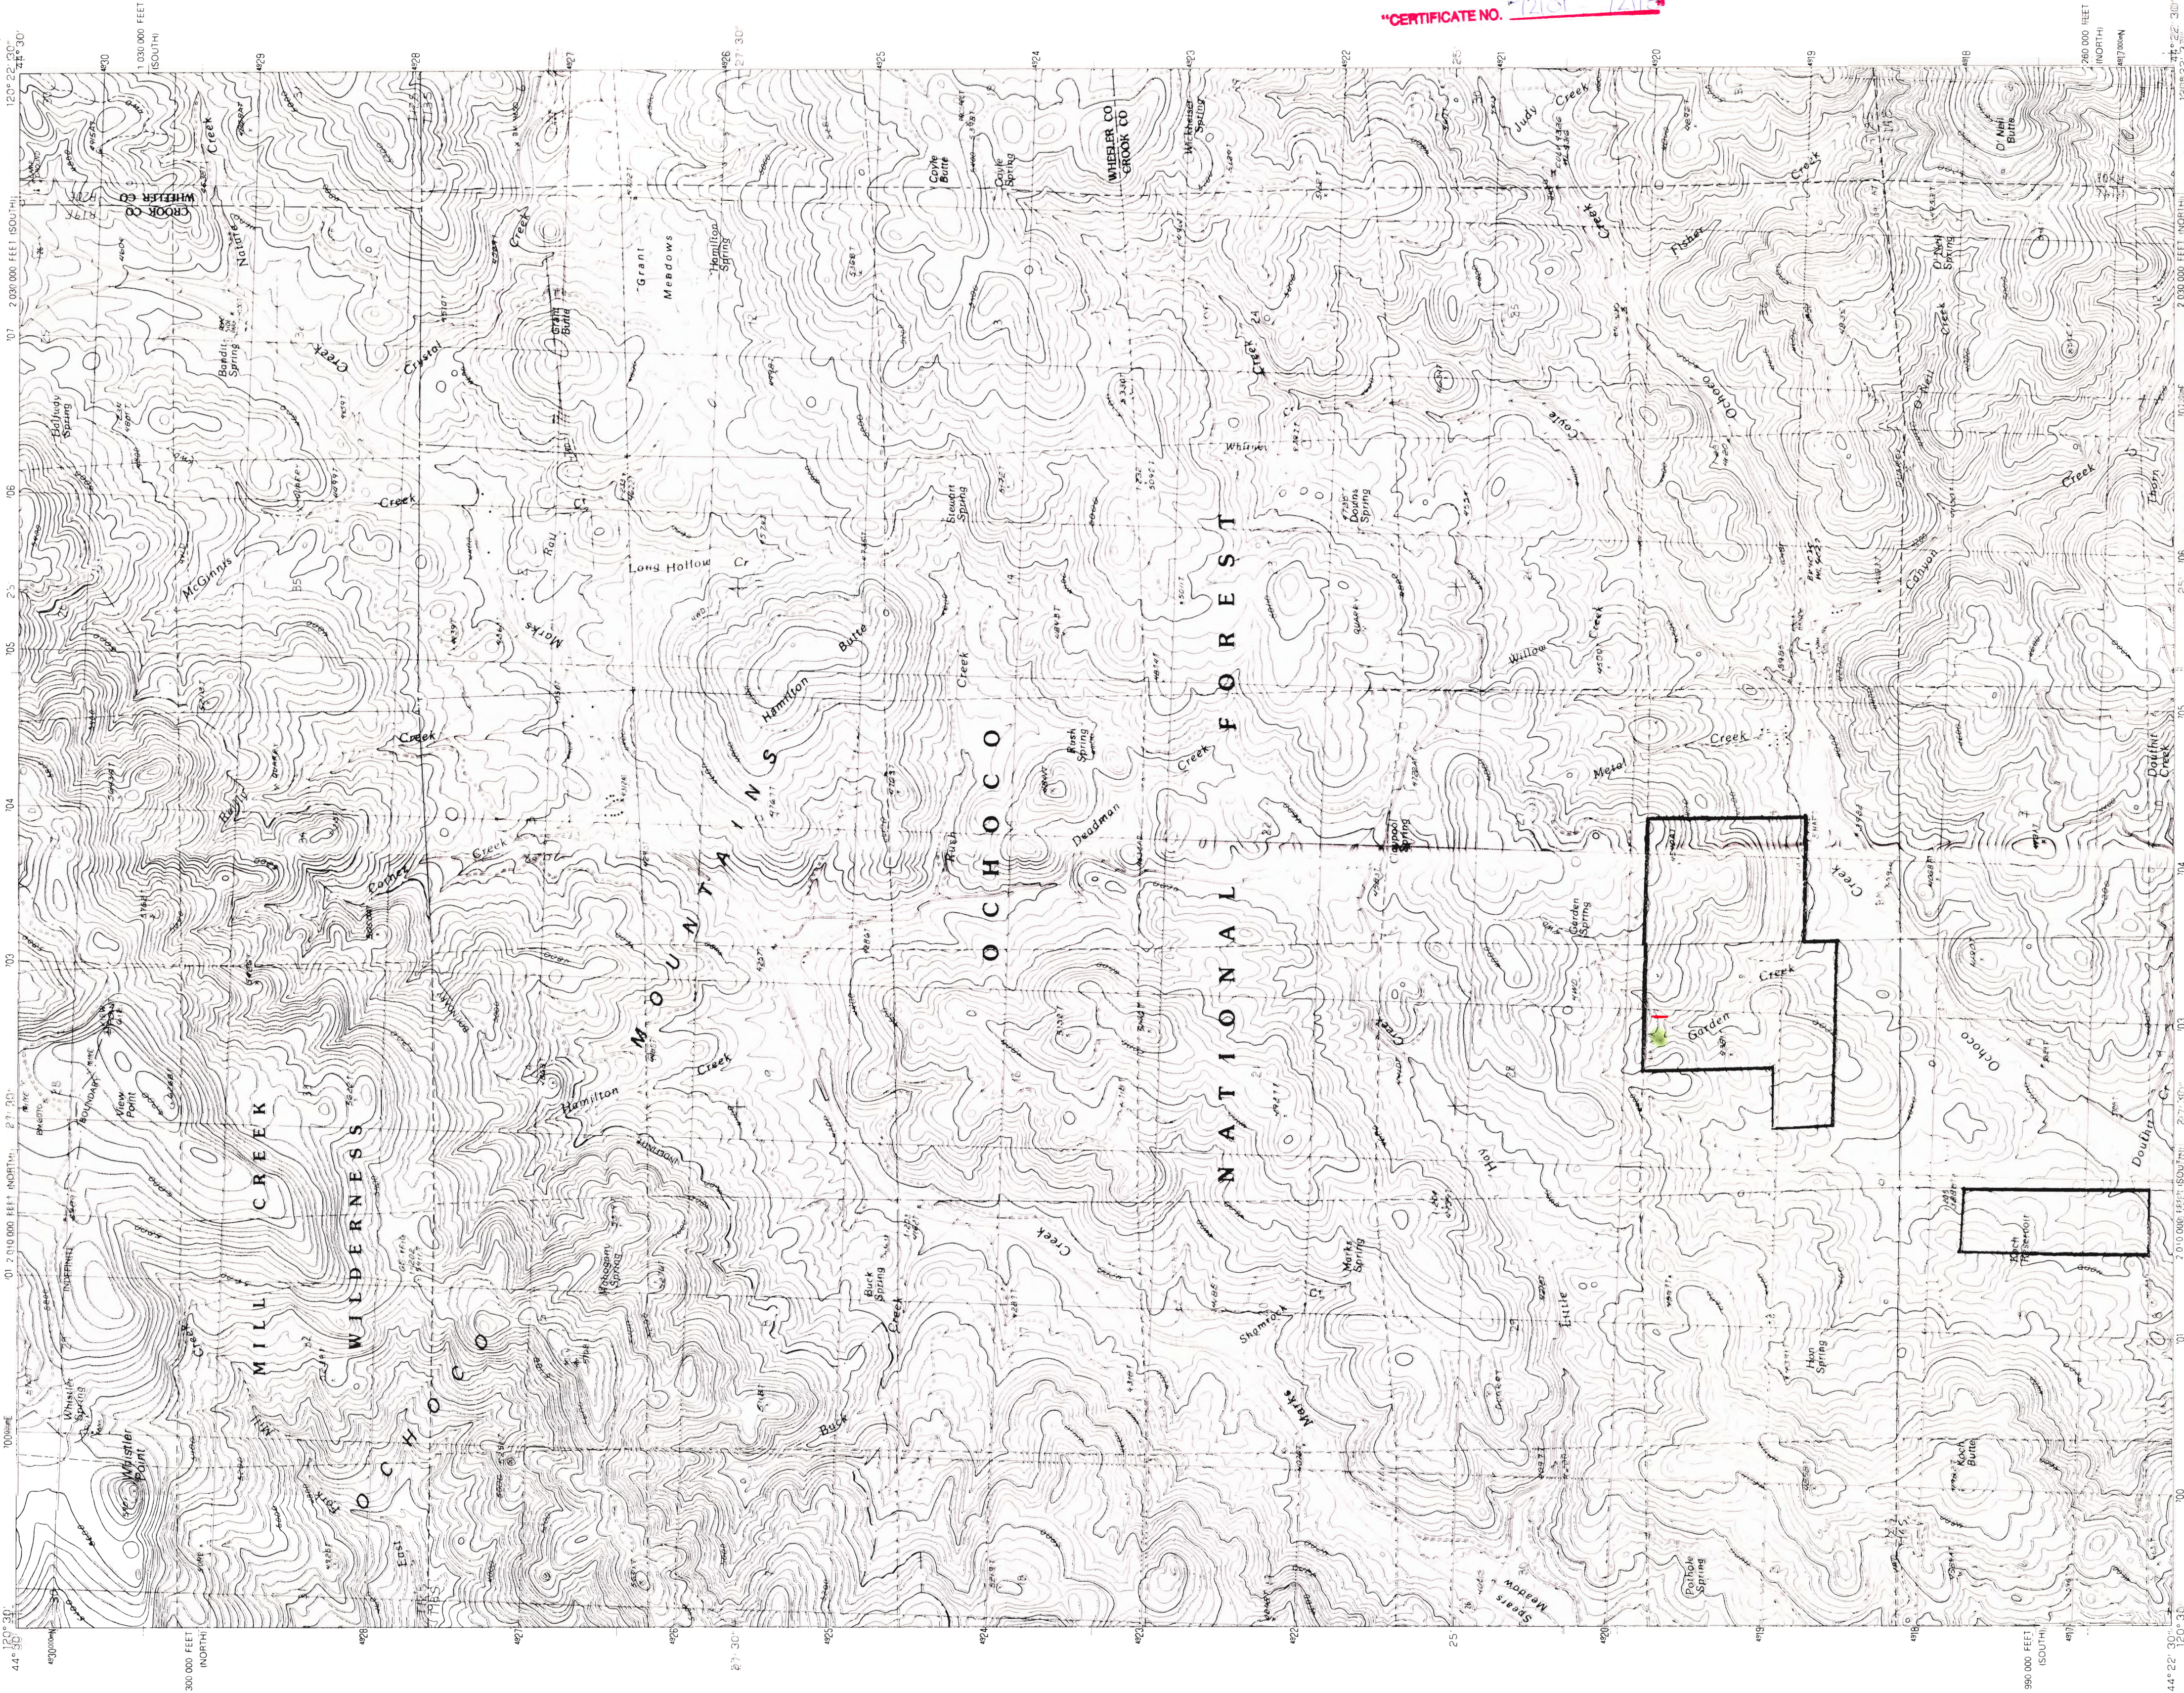

PRODUCED BY THE UNITED STATES GEOLOGICAL SURVEY
FROM AERIAL PHOTOGRAPHS TAKEN IN 1966 AND 1967
FIELD CHECKED 1986. MAP EDITED 1990
GRID 1000-METER UNIVERSAL TRANSVERSE MERCATOR, ZONE 10
10 000-FOOT STATE GRID TICS
UTM GRID DECLINATION AND NORTH ZONES
1990 MAGNETIC NORTH DECLINATION 18°00' EAST
VERTICAL DATUM, NATIONAL GEODETIC VERTICAL DATUM OF 1929
To place the projection lines as shown by dashed corner ticks
(20 meters north and 89 meters east)
There may be private inholdings within the boundaries of any
Federal or State reservations shown on this map

PROVISIONAL MAP
Produced from original
manuscript drawings. Infor-
mation shown as of date of
field check.

SCALE 1:24 000




CONTOUR INTERVAL 40 FEET

To convert meters to feet multiply by 3.2808
To convert feet to meters multiply by .3048

THIS MAP COMPLIES WITH NATIONAL MAP ACCURACY STANDARDS
FOR SALE BY U.S. GEOLOGICAL SURVEY
DENVER, COLORADO 80225 OR RESTON, VIRGINIA 22092

1	2	3	4	5	6	7	8

ROAD LEGEND

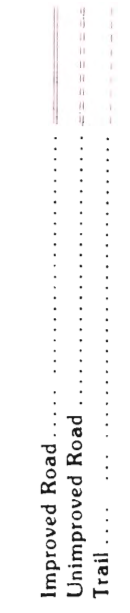

Interstate Route U.S. Route State Route

WHISTLER POINT, OREGON
PROVISIONAL EDITION 1990
44120-D4-TF-024


Application No. R-80892 - R-80902
Permit No. 12101 - 12102

*CERTIFICATE NO. 12101 - 12102

DEC 30 1994
JAMES DEHL
OREGON

Apps. R-80892 & R-80902

148

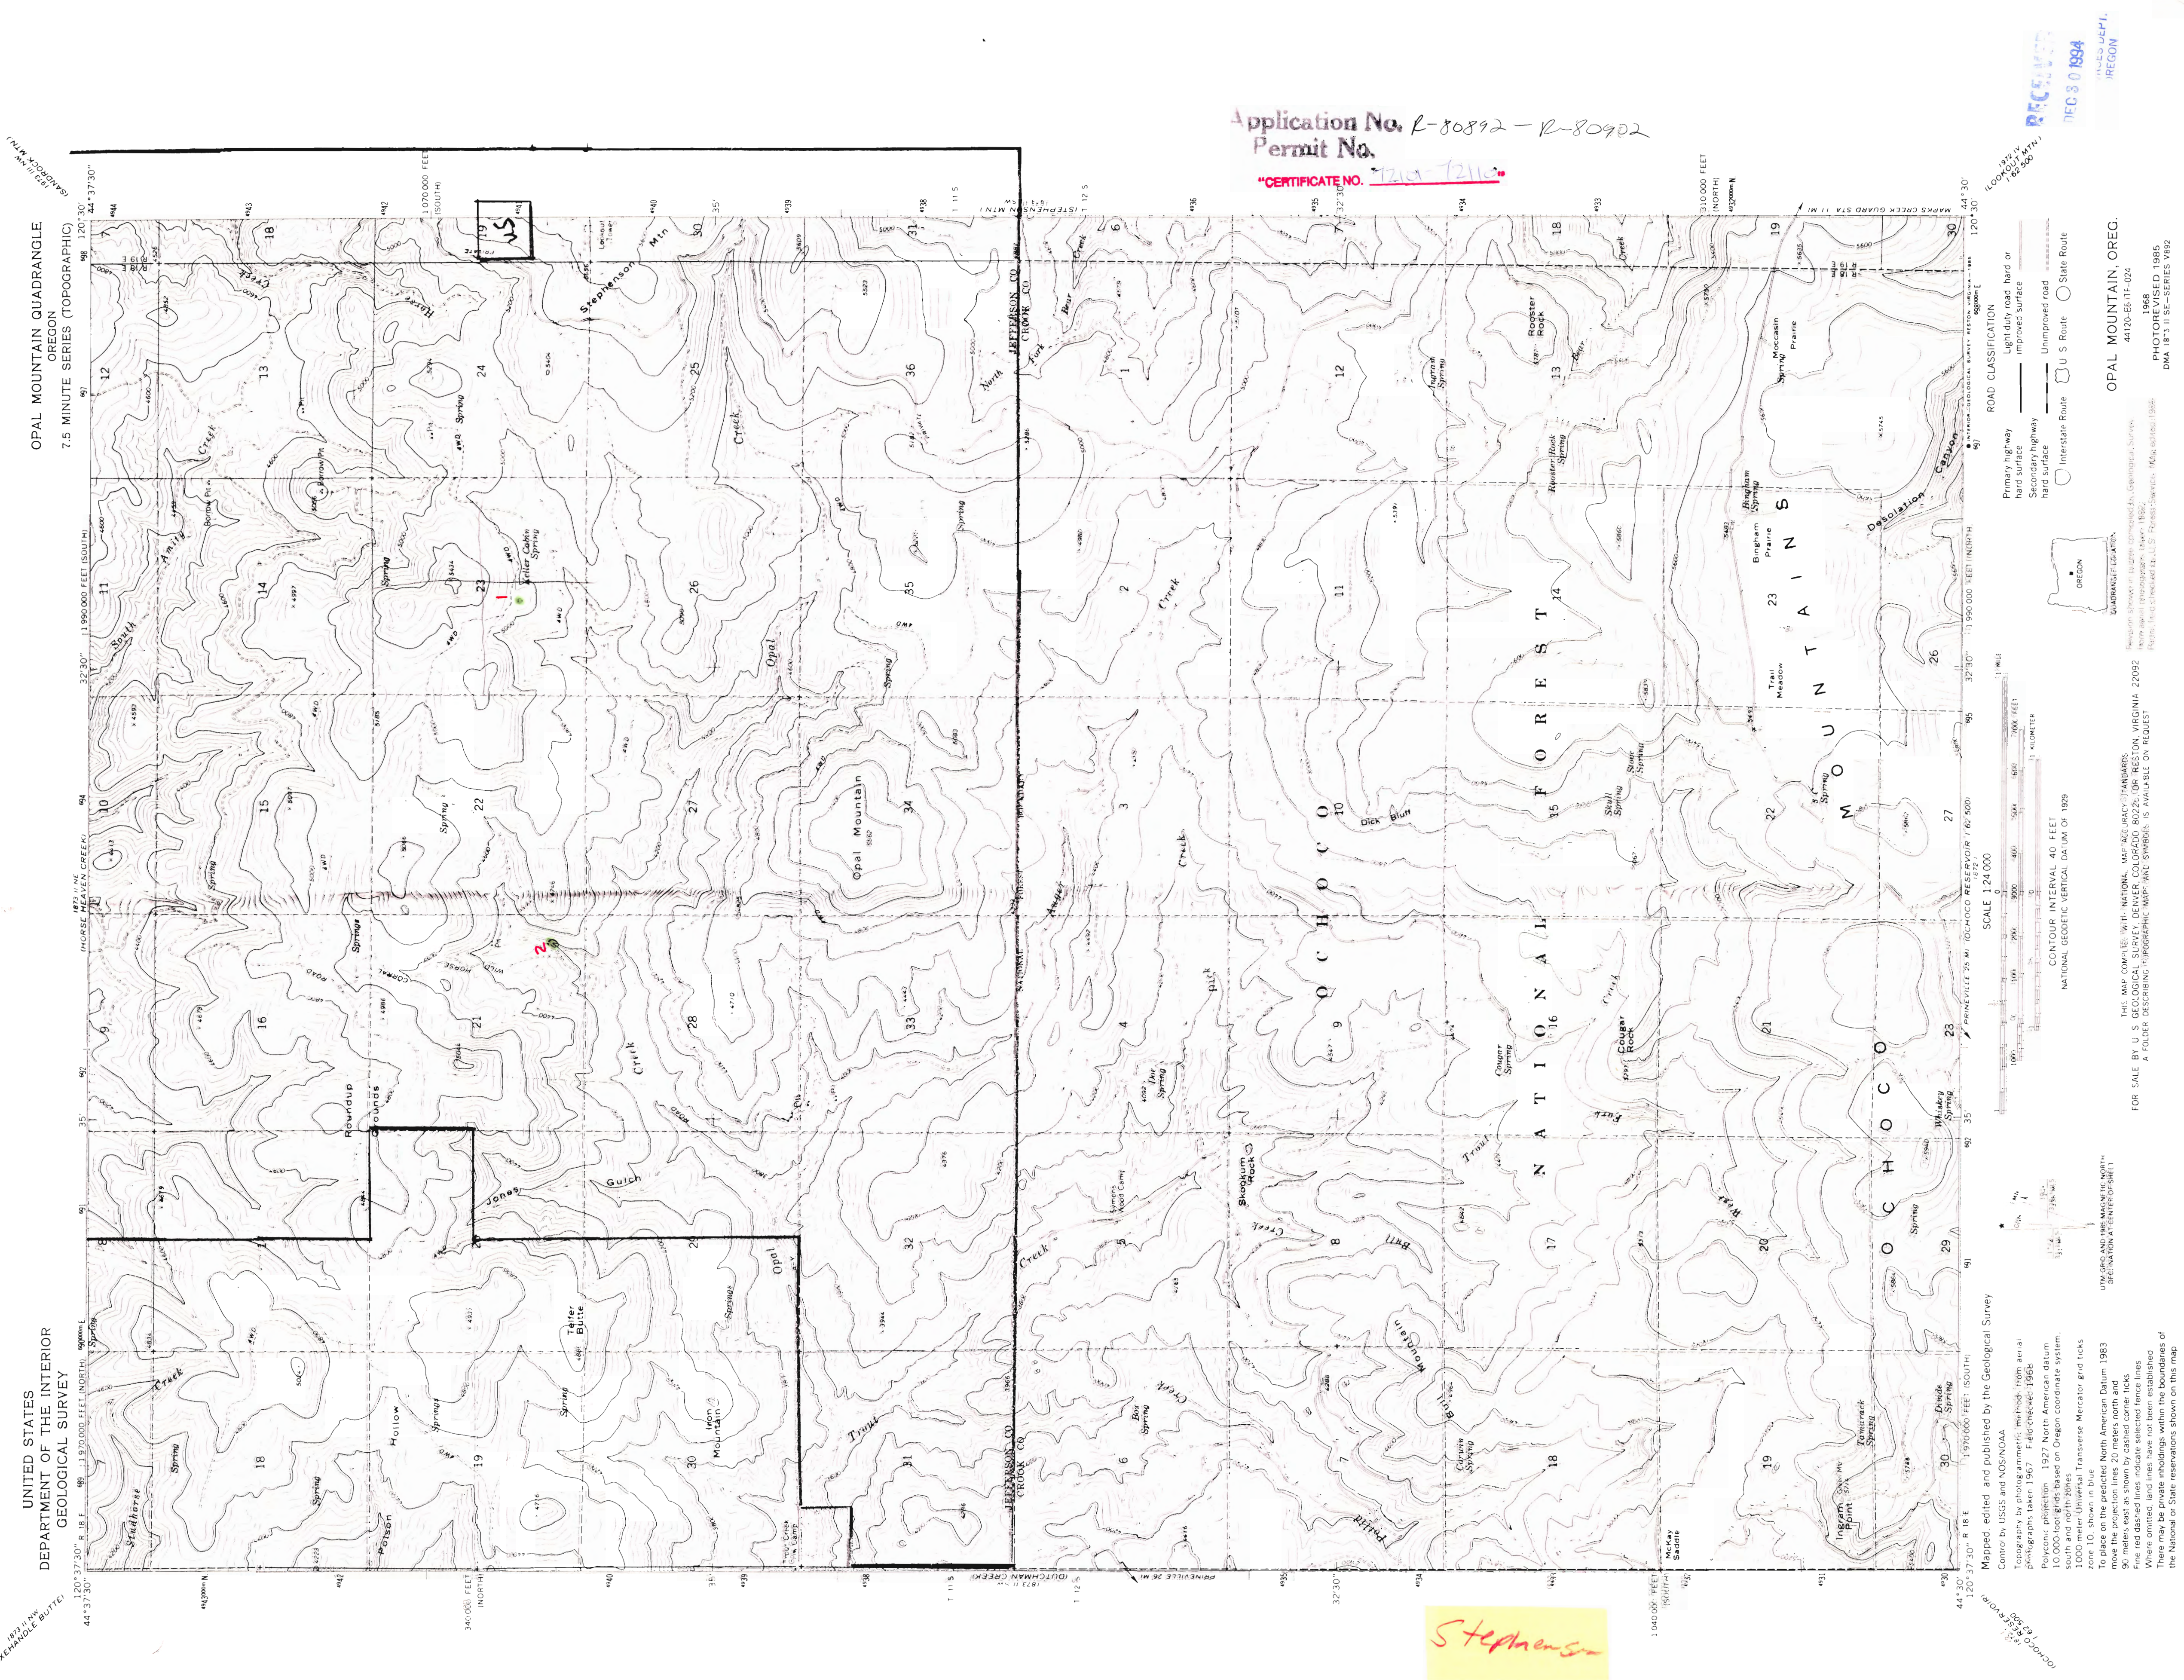


Apps. R-80892 & R-80902



DEC 9 1994

WATER RESOURCES LIBRARY
SALEM, OREGON

SERVICE CREEK, OREG.
PROVISIONAL EDITION 1987
44120-G1-TF-024

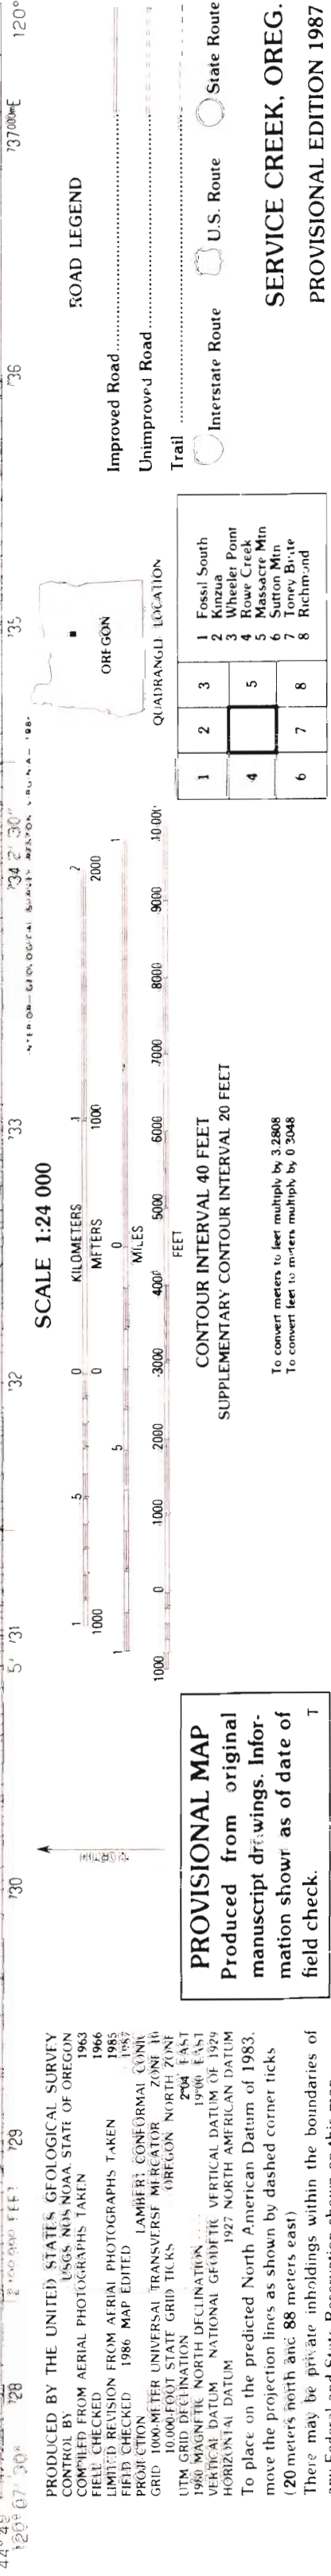

PRODUCED BY THE UNITED STATES GEOLOGICAL SURVEY
2

THIS MAP COMPLIES WITH NATIONAL MAP ACCURACY STANDARDS
FOR SALE BY U. S. GEOLOGICAL SURVEY, DENVER, COLORADO 80225, OR RESTON, VIRGINIA 22092

Public Land Survey System is shown as published in 1966 and verified or supplemented in 1986

148

Apps. R-80892 & R-80902