


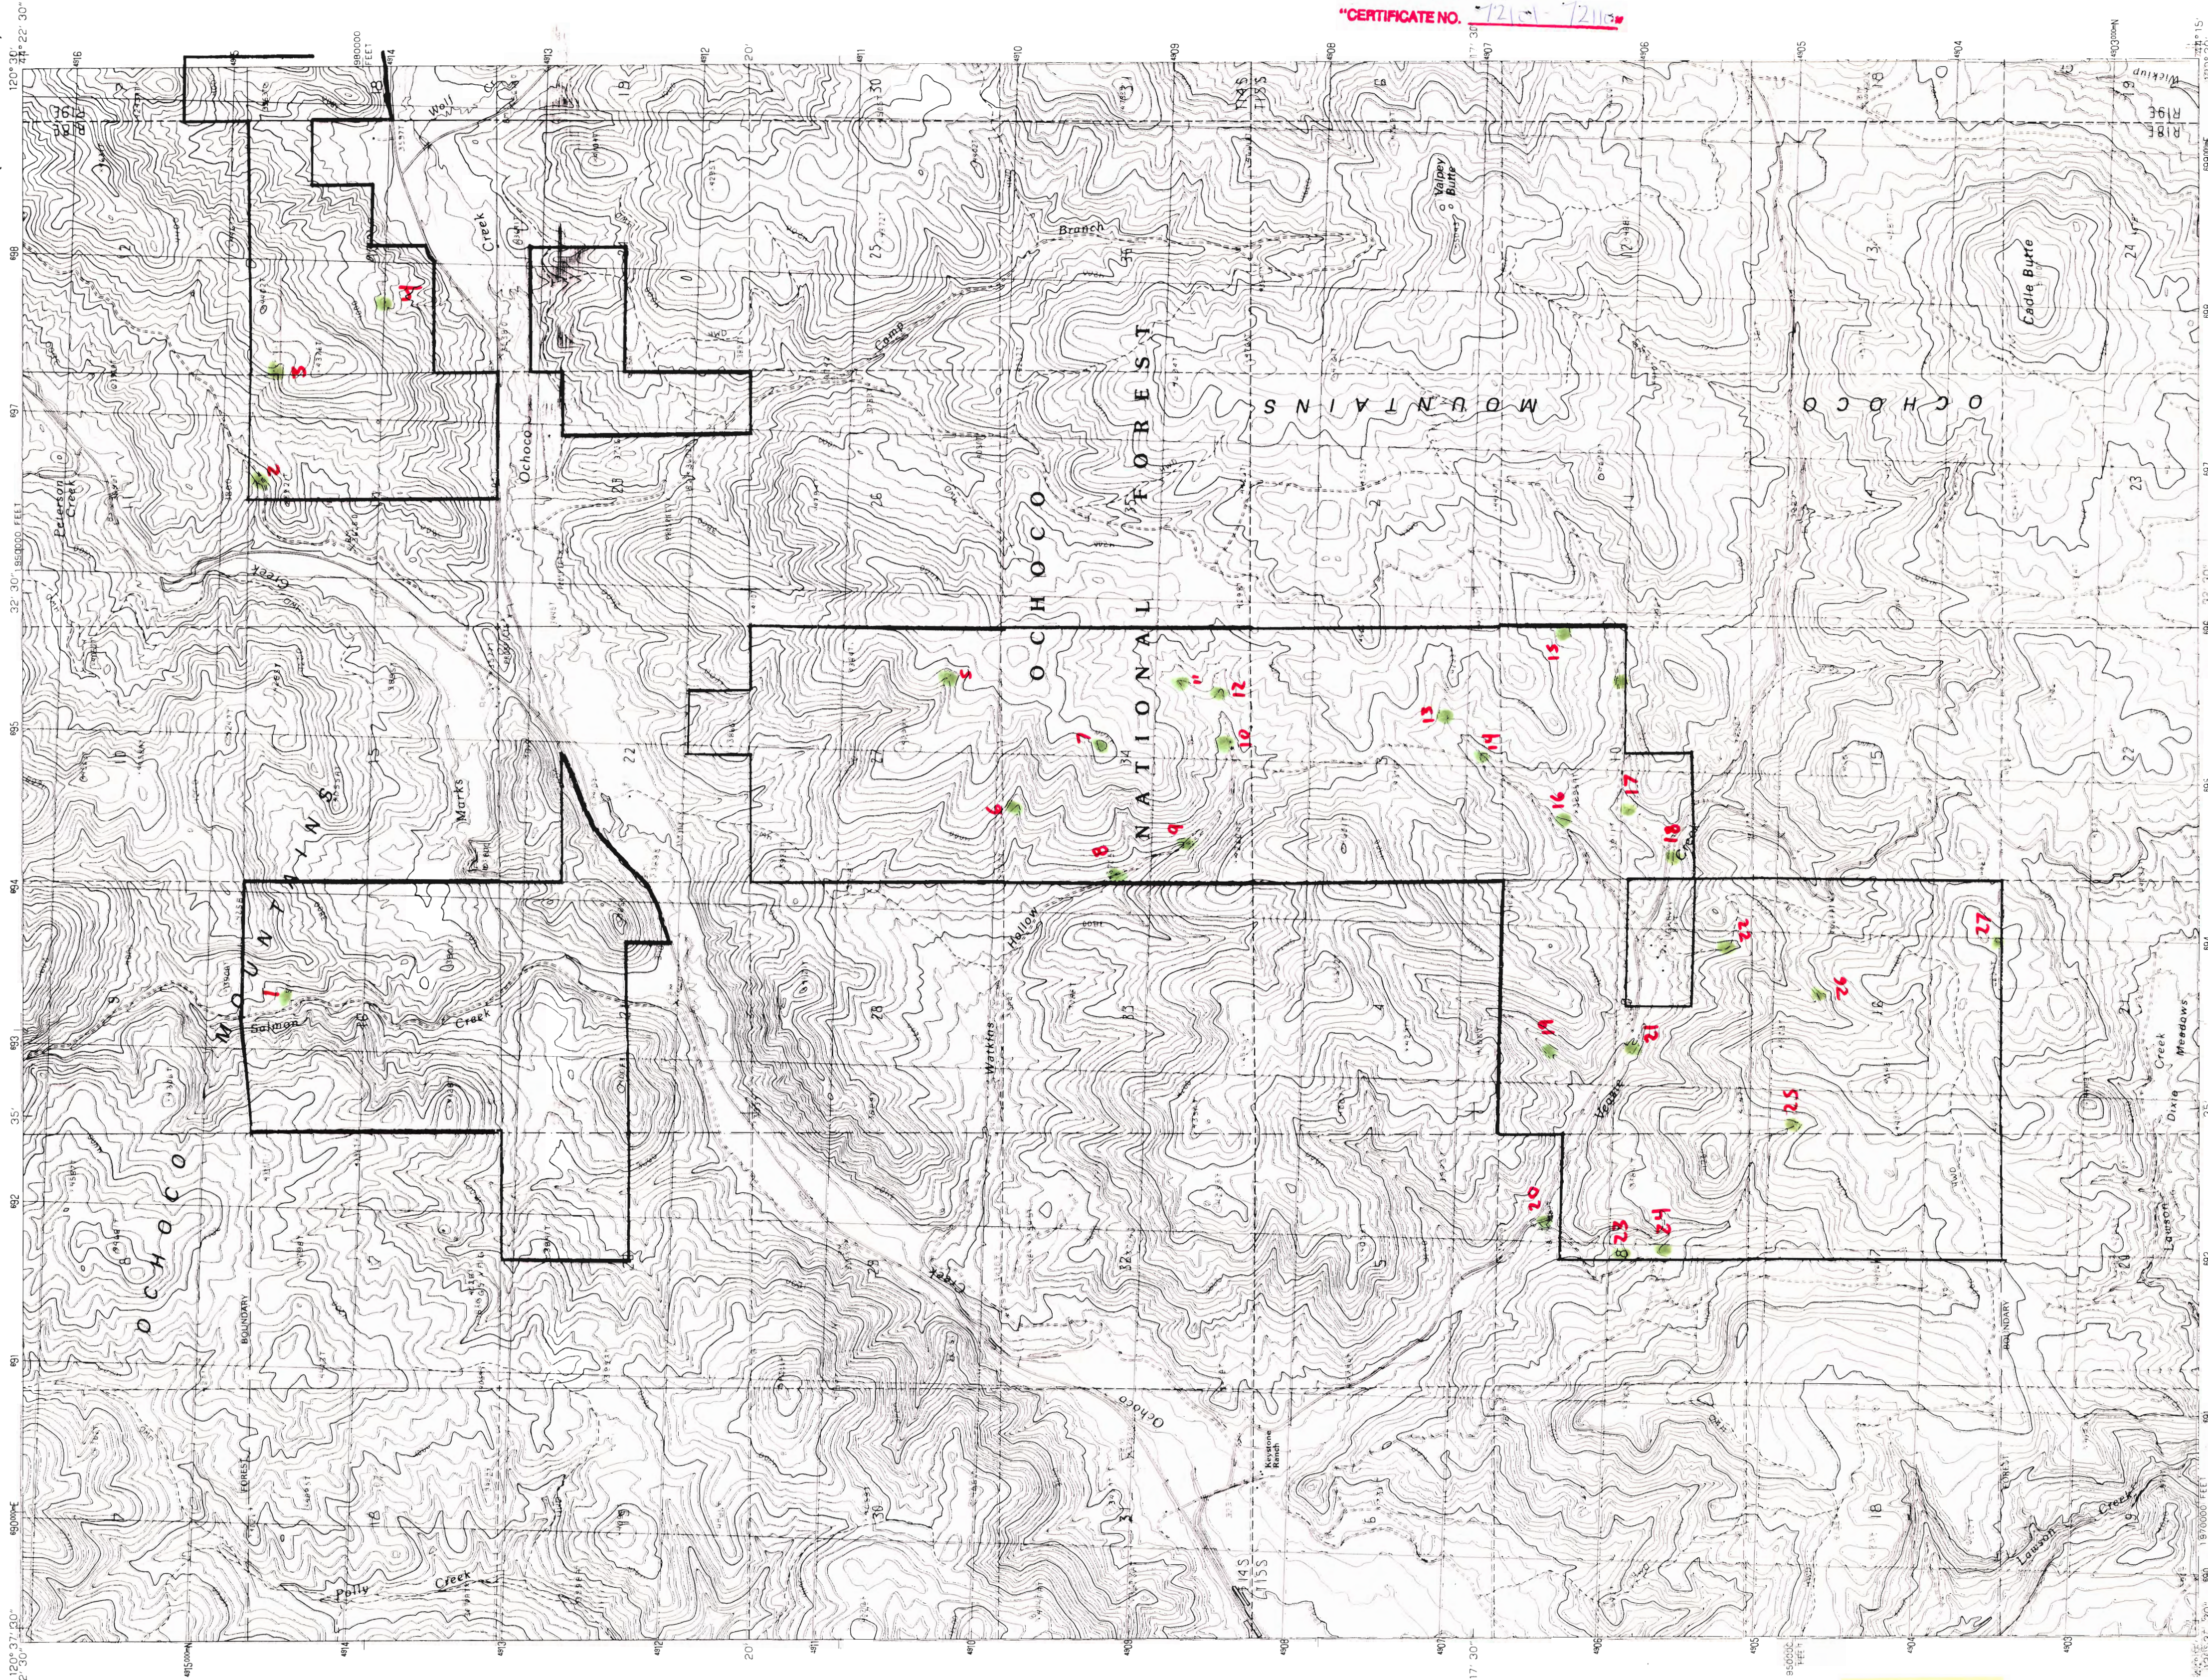

Ochoco


Apps. R-80892 & R-80902

Application No. R-80892 - 80902
Permit No.
"CERTIFICATE NO. 72151-72113"

PRODUCED BY THE UNITED STATES GEOLOGICAL SURVEY
COMPILED FROM AERIAL PHOTOGRAPHS TAKEN IN 1955 AND 1957
FIELD CHECKED: 1986 MAP EDITED: 1990
GEOLOGICAL SURVEY OF THE UNITED STATES
GRID: 1000-METER UNIVERSAL TRANSVERSE MERCATOR
10 000-FOOT STATE GRID TICS: OREGON, SOUTH ZONE
UTM GRID DECLINATION: 1983
VERTICAL DATUM: 1929
HORIZONTAL DATUM: 1927 NORTH AMERICAN DATUM
To place on the predicted North American Datum of 1983,
above the projection lines as shown by dashed corner ticks
(2000 meters easting, 1700 meters northing).
There may be some inaccuracy in the boundaries of any
Federal or State reservations shown on this map.

PROVISIONAL MAP
Produced from
manuscript drawings. Infor-
mation shown as of date of
field check.

SCALE 1:24 000

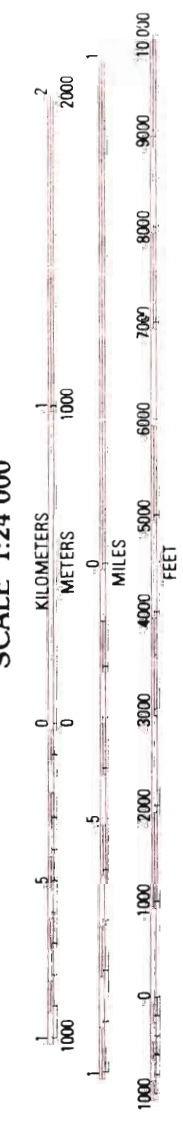

CONTOUR INTERVAL 40 FEET

To convert meters to feet multiply by 3.2808
To convert feet to meters multiply by .3048

ROAD LEGEND

Improved Road
Unimproved Road
Trail

QUADRANGLE LOCATION




Interstate Route
U. S. Route
State Route

CADLE BUTTE, OREGON
PROVISIONAL EDITION 1990
44120-C5-TF-024

THIS MAP COMPLETES WITH NATIONAL MAP ACCURACY STANDARDS
FOR SALE BY U. S. GEOLOGICAL SURVEY, DENVER, COLORADO 80225, OR RESTON, VIRGINIA 22072

REC
DEC 31 1994
WATER RESOURCES
SALEM, OREGON

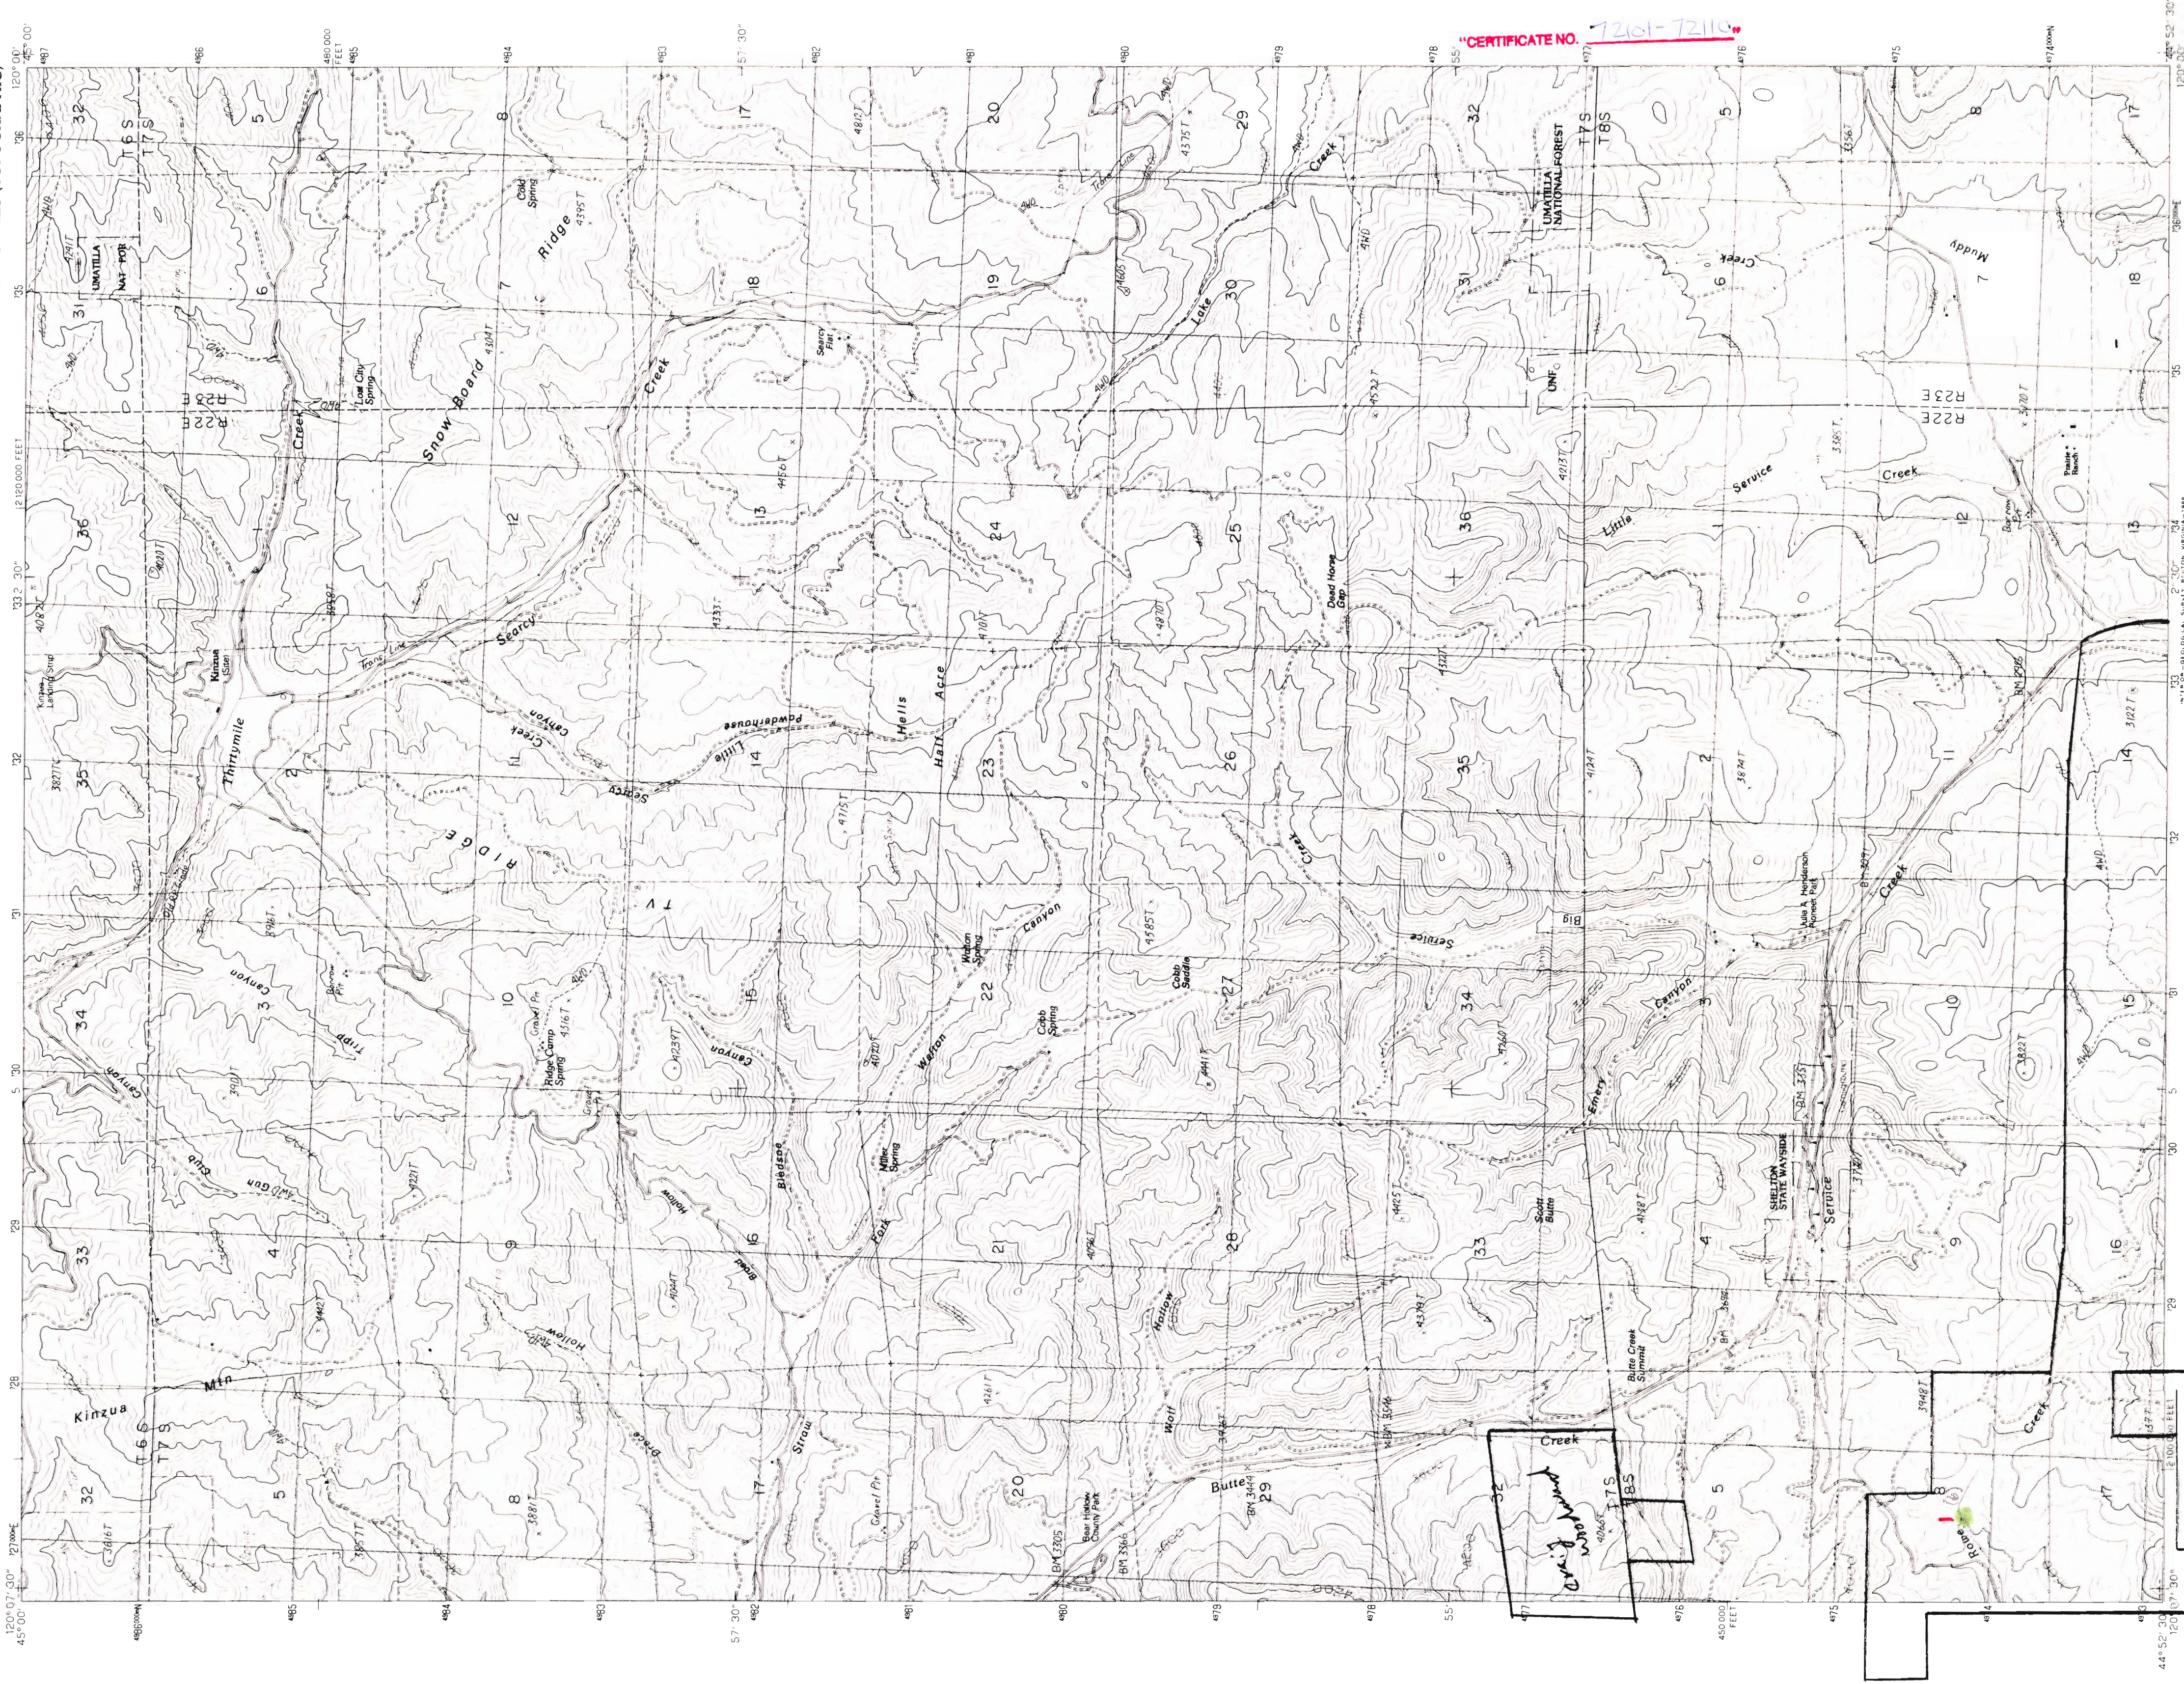

Application No. R-80892 - R-80902
Permit No.

CERTIFICATE NO. 72161-72110

RECEIVED
DEC 30 1994
WATER RESOURCES DIV.
SALEM, OREGON

ROAD LEGEND
Improved Road
Unimproved Road
Trail
Interstate Route
U.S. Route
State Route
KINZUA, OREG.
PROVISIONAL EDITION 1987
44120-H1-TF-024

QUADRANGLE LOCATION

1	2	3
4	5	6
7	8	9

ADJOINING 7.5 QUADRANGLE NAMES

1	2	3
4	5	6
7	8	9

SCALE 1:24 000
KILOMETERS
MILES
CONTOUR INTERVAL 40 FEET
To convert meters to feet, multiply by 3.2808
To convert feet to meters, multiply by 0.3048

PRODUCED BY THE UNITED STATES GEOLOGICAL SURVEY
COMPILED FROM AERIAL PHOTOGRAPHS TAKEN
1966
1967
PROVISIONAL MAP
Produced from original
manuscript drawings. Infor-
mation shown as of date of
field check.

THIS MAP COMPLETES WITH NATIONAL MAP A CUBACY STANDARDS
FOR SALE BY U. S. GEOLOGICAL SURVEY, DENVER, COLORADO 80225, OR RESTON, VIRGINIA 22092

No distinction made between houses, barns, and other buildings


Apps. R-80892 & R-80902

148

148


UNITED STATES
DEPARTMENT OF THE INTERIOR
GEOLOGICAL SURVEY

GRAYLOCK BUTTE QUADRANGLE
OREGON-GRANT CO.
7.5 MINUTE SERIES (TOPOGRAPHIC)

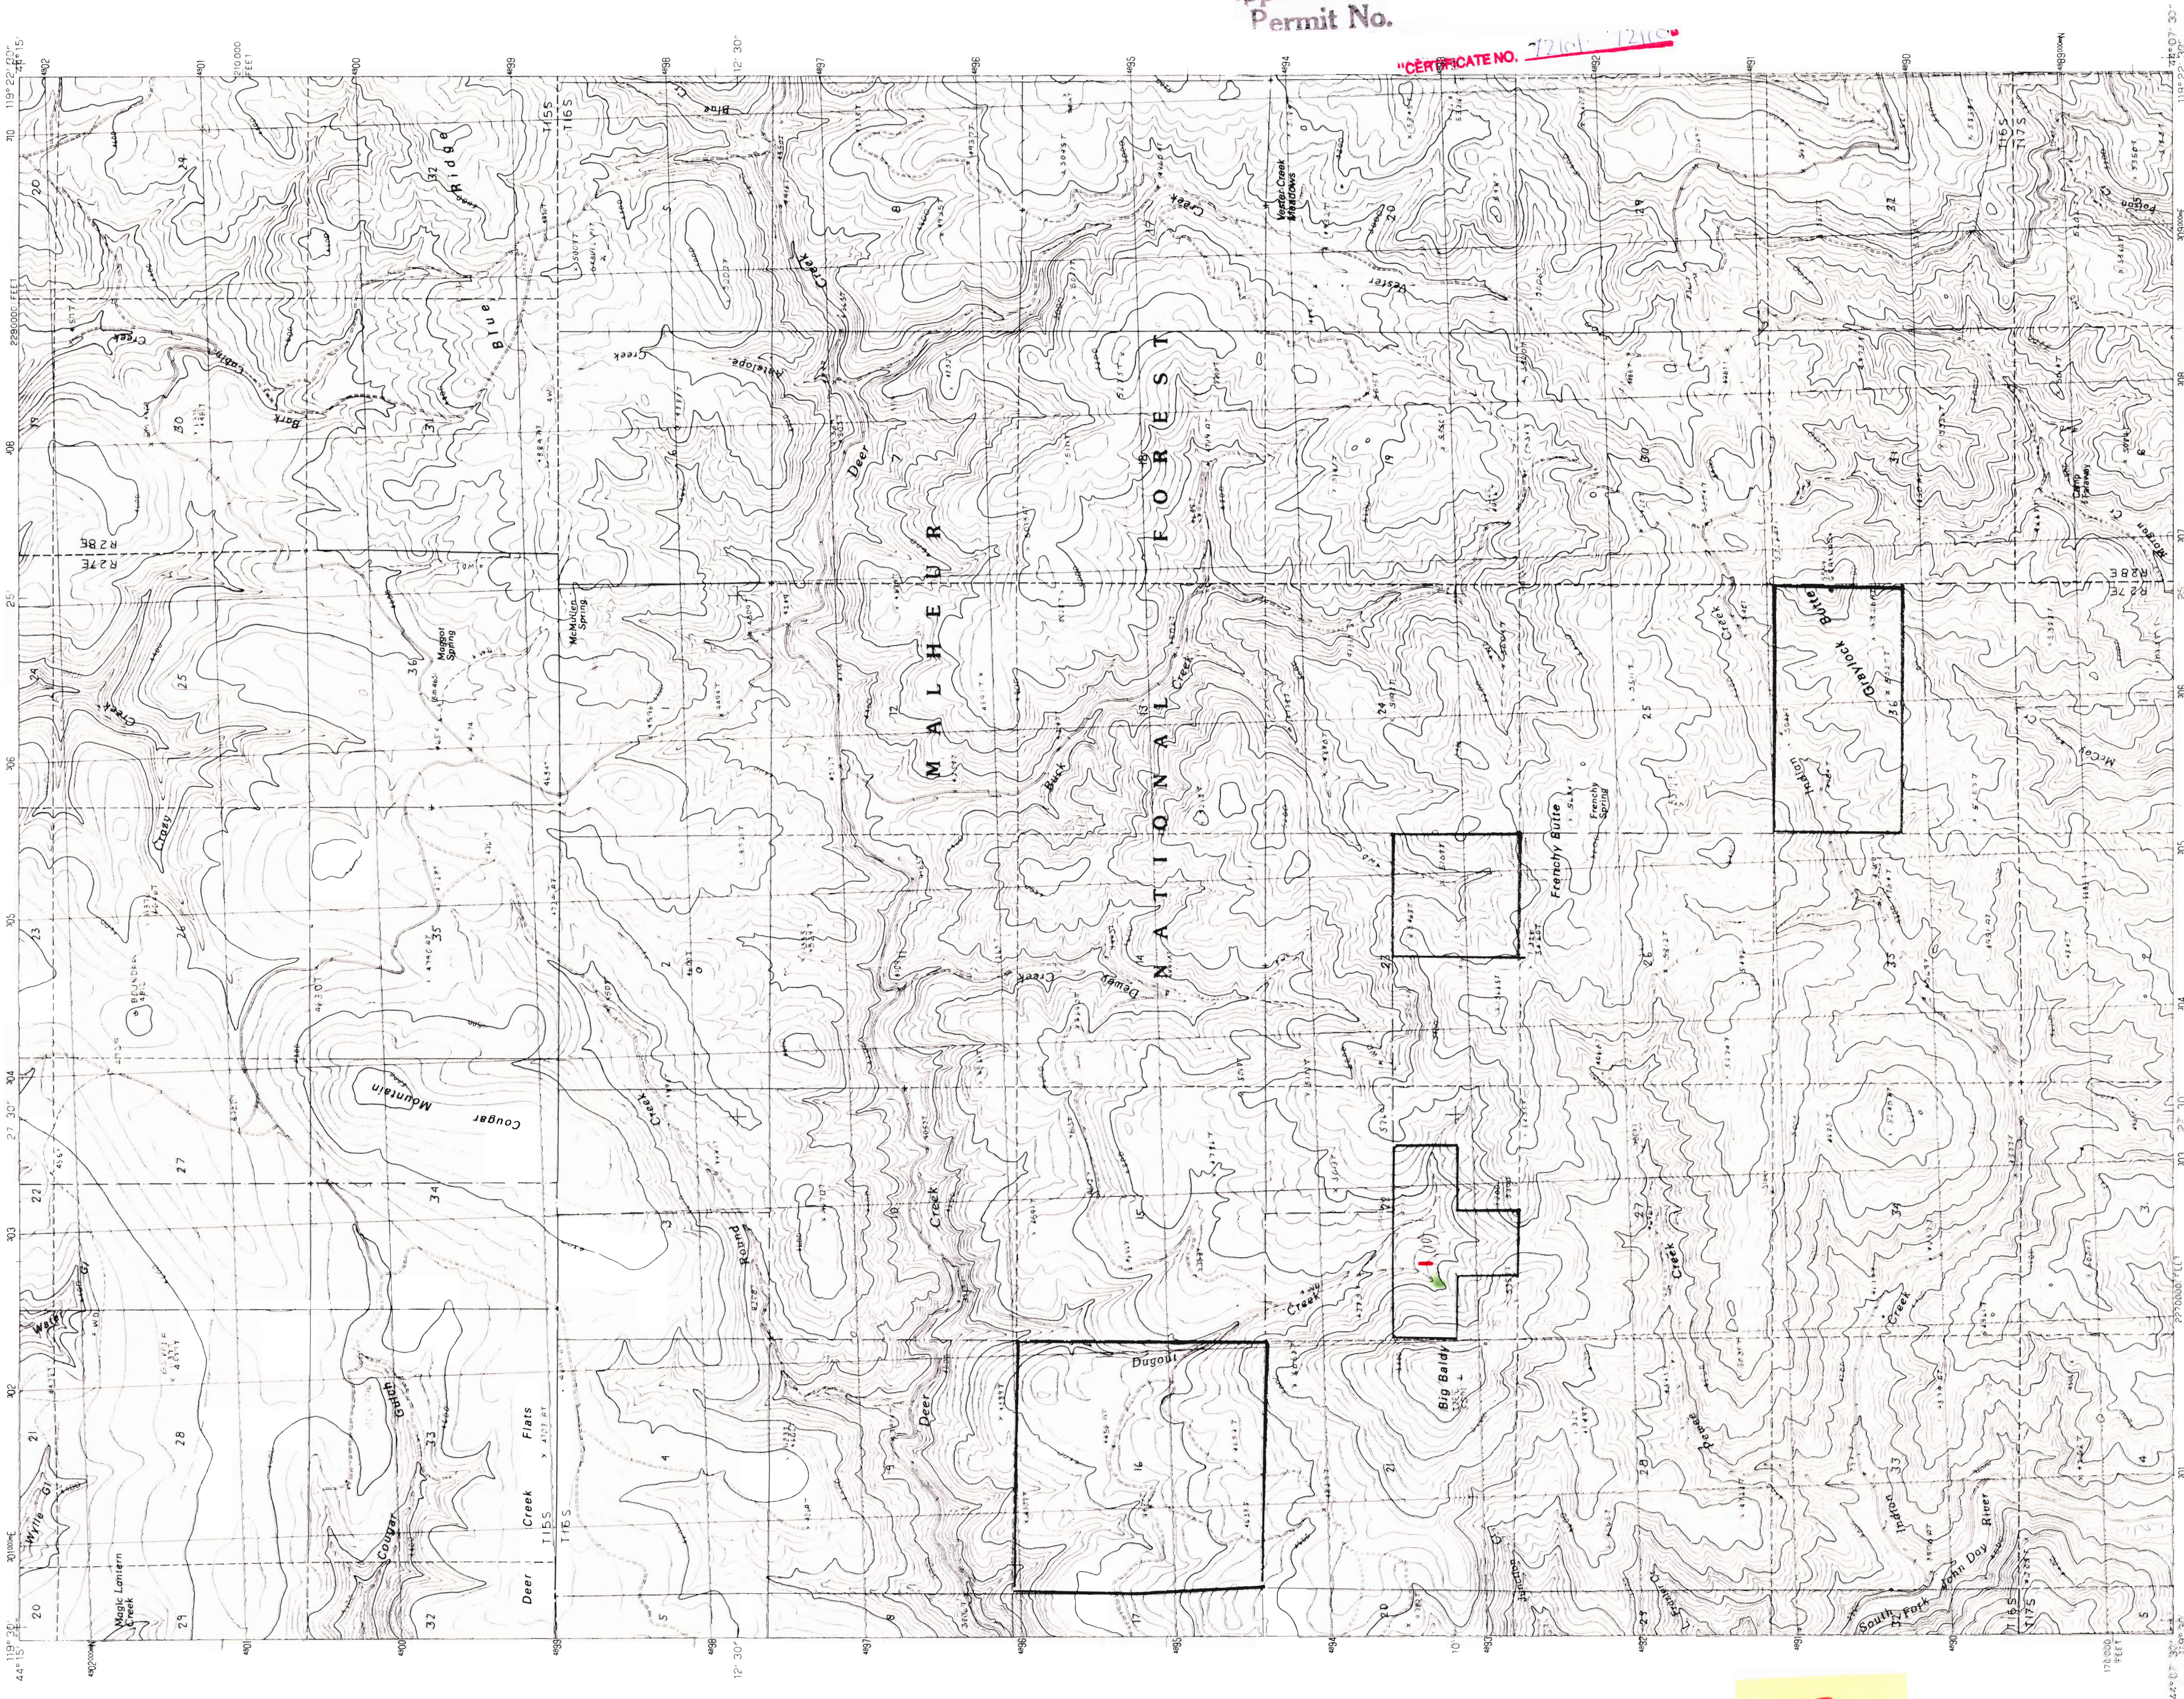

PRODUCED BY THE UNITED STATES GEOLOGICAL SURVEY
CONTROL BY: USGS AND NOS-NOAA
DERIVED FROM: AERIAL PHOTOGRAPHS TAKEN 1984
PROJECTION: UTM 12N, NAD 83, LAMBERT CONFORMAL CONIC
GRID: 1000-METER UNIVERSAL TRANSVERSE MERCATOR, ZONE 11
UTM GRID DECLINATION: OREGON, 17 30 EAST
1990 MAGNETIC NORTH DECLINATION: OREGON, 17 42 WEST
HORIZONTAL DATUM: NATIONAL GEODESIC SURVEY 1983 NORTH AMERICAN DATUM
To place on the predicted North American Datum of 1983,
move the projection lines as shown by dashed corner ticks
(19 meters north and 86 meters east)
There may be private inholdings within the boundaries of any
Federal or State reservations shown on this map.

PROVISIONAL MAP
Produced from original
manuscript drawings. Infor-
mation shown as of date of
photography.

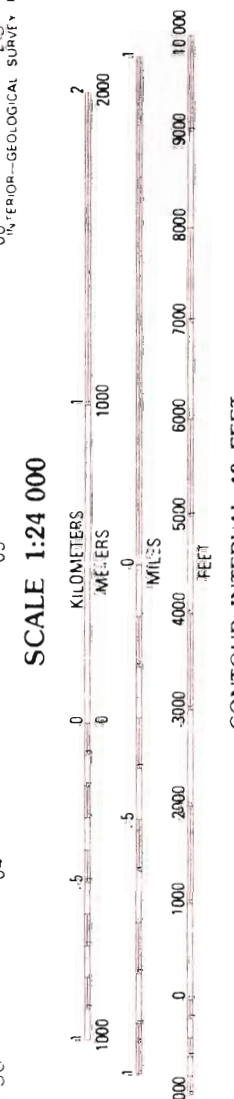

ROAD LEGEND

Improved Road	Interstate Route	U S Route	State Route
Unimproved Road			
Trail			

QUADRANGLE LOCATION

1	2	3	4	5	6	7	8
Aldrich Gulch				Big Weasel Springs			
Camp Springs				French Spring			
Graylock Butte				Lewie Creek			

ADJOINING 7.5 QUADRANGLE NAMES


GRAYLOCK BUTTE, OREGON
PROVISIONAL EDITION 1990
44119-B4-TF-024

Application No. R-80892 - R-80902
Permit No.

Apps. R-80892 & R-80902

148

UNITED STATES
DEPARTMENT OF THE INTERIOR
GEOLOGICAL SURVEY

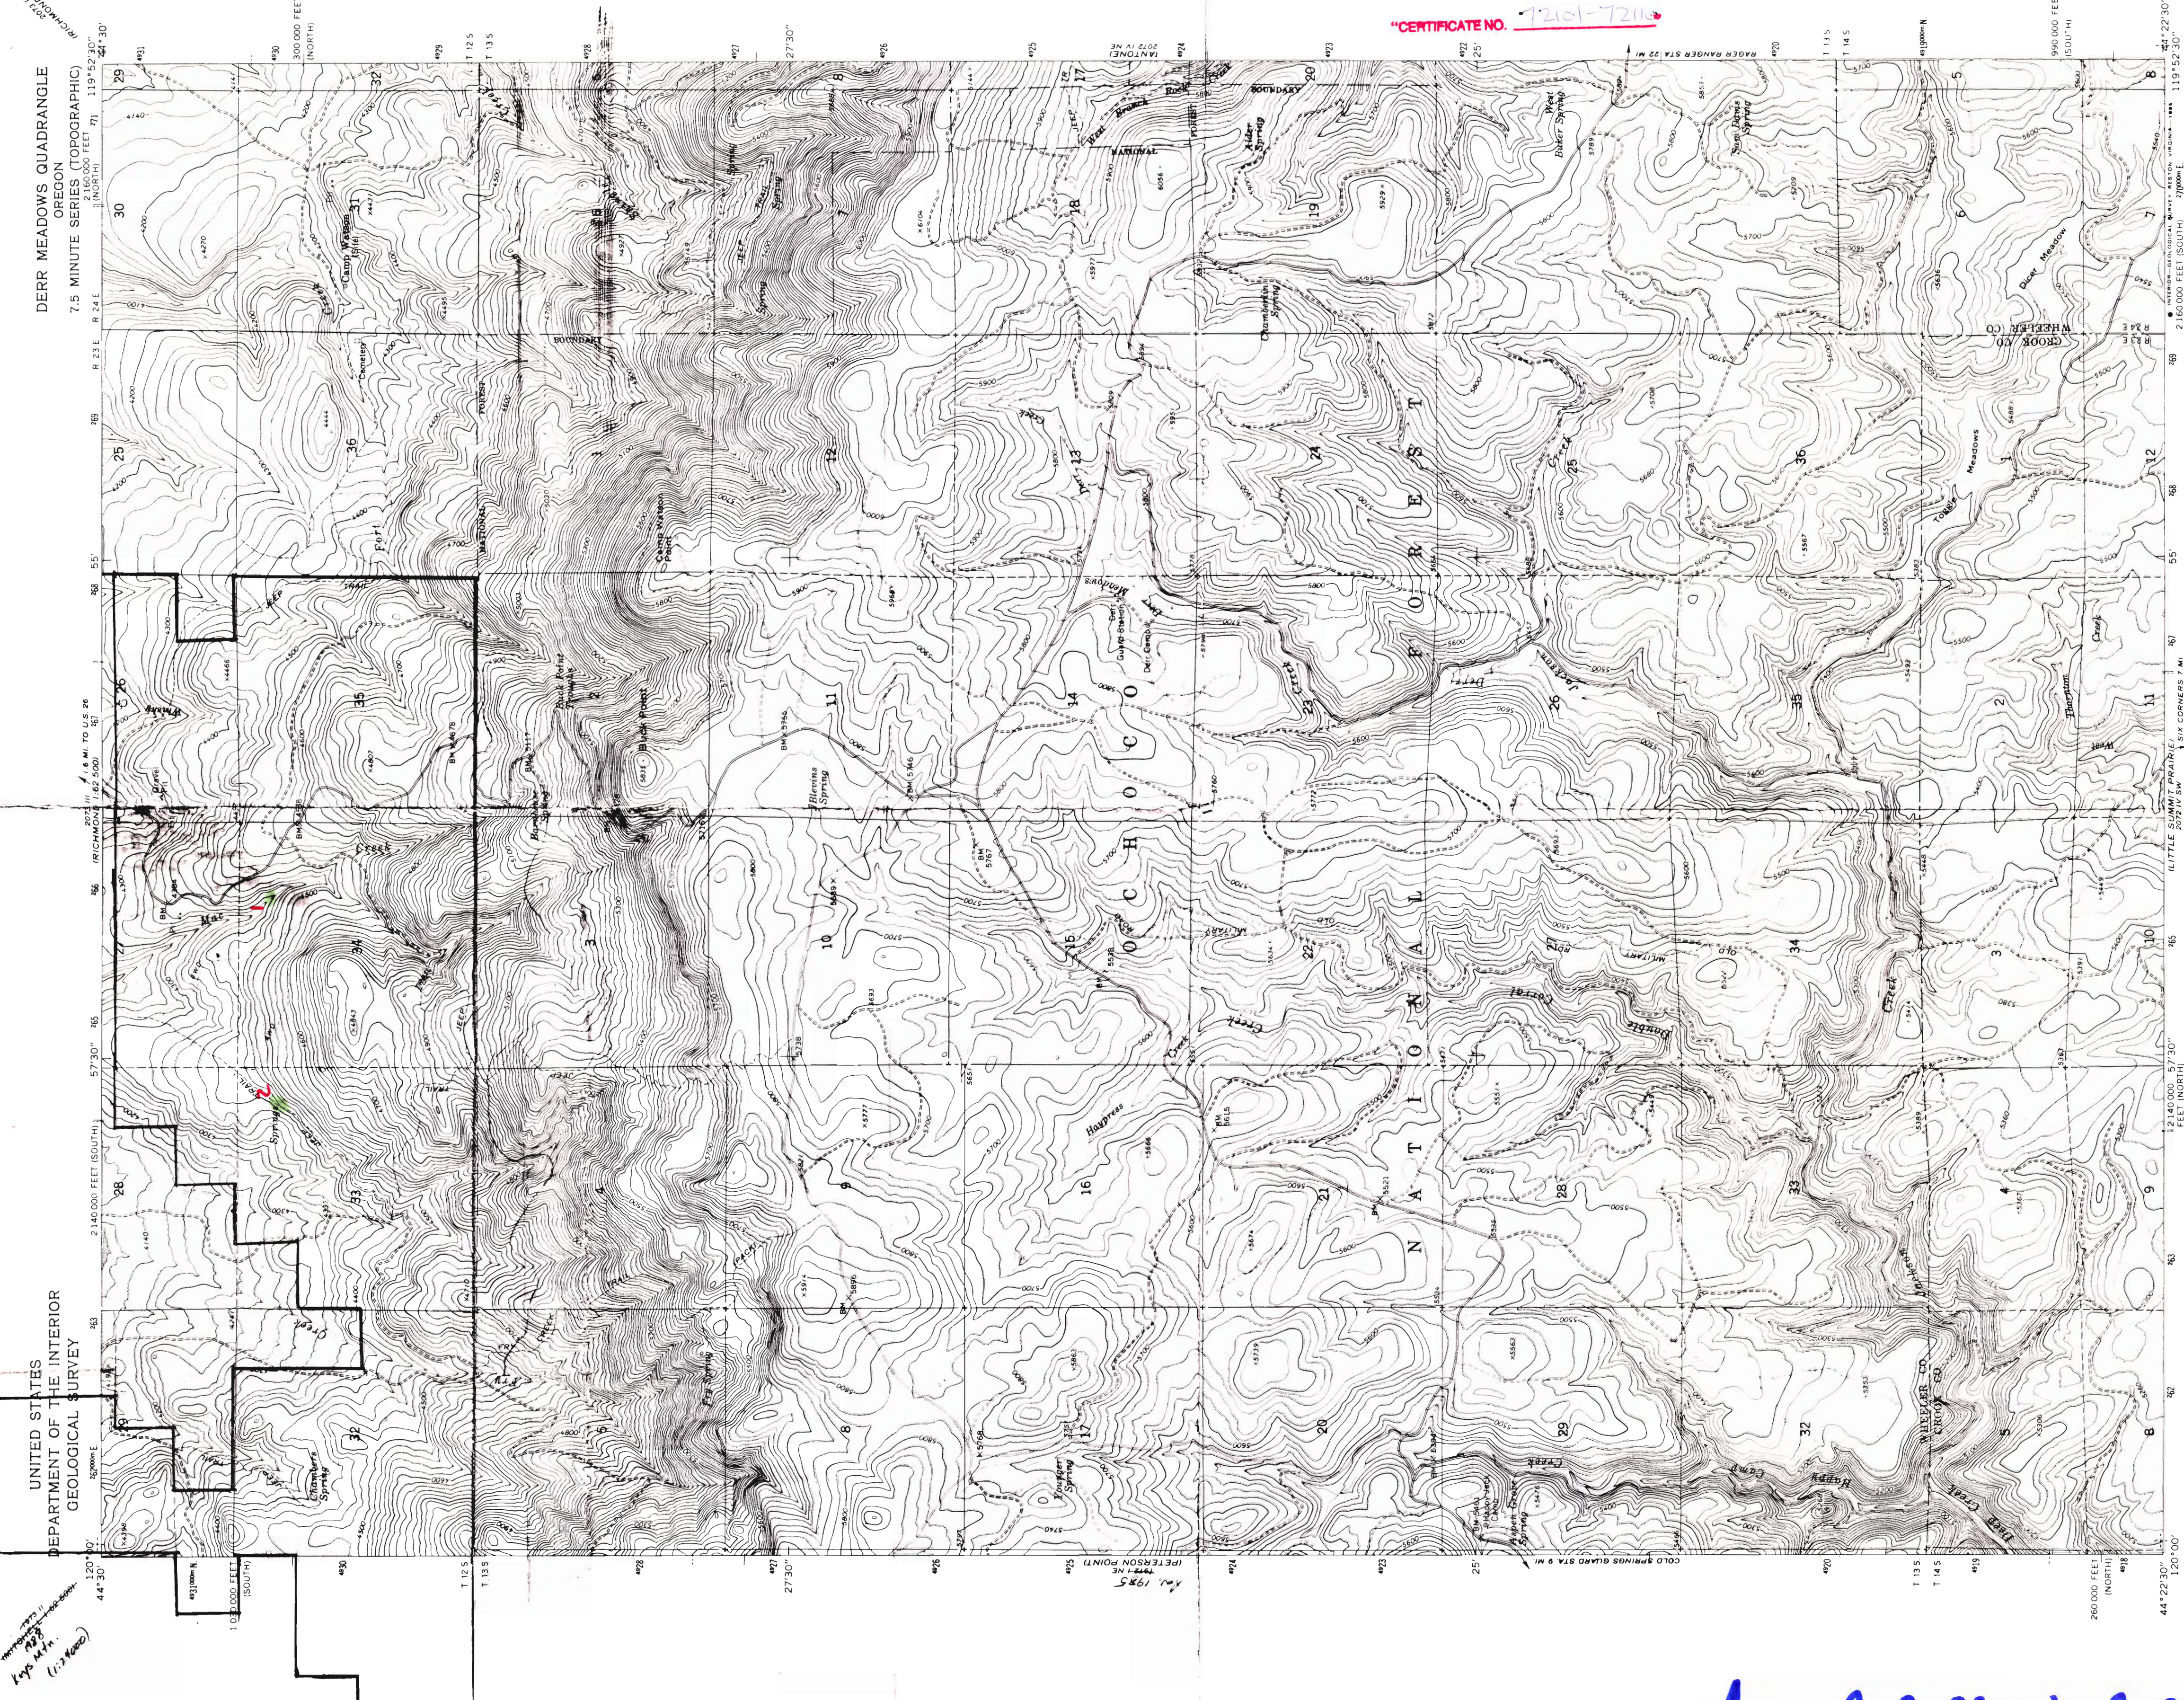

2021 11 16 10:00 AM

Application R-80892 & R-80902
Permit No.

"CERTIFICATE NO. 72101-72110"



ROAD CLASSIFICATION
Light duty
Unimproved dirt



DERR MEADOWS, OREG.
44119 D-1E 024
1966
PHOTOREVISED 1985
DMA 2072 IV NW-SERIES 1982

THIS MAP COMPLEIES WITH NATIONAL MAP ACCURACY STANDARDS
FOR SALE BY U.S. GEOLOGICAL SURVEY
A FOLDER DESCRIBING TOPOGRAPHIC MAPS AND SYMBOLS IS AVAILABLE ON REQUEST

Maped, edited, and published by the Geological Survey
Control by USGS and NOS/NOAA
Topography by photogrammetric methods from aerial
photographs taken 1959. Field checked 1965
Polyconic projection. 1927 North American datum
10,000 foot zones based on Oregon coordinate system,
north and south zones
1000-meter Universal Transverse Mercator grid ticks,
zone 11, shown in blue
To place on the predicted North American Datum 1983
move the projection lines 19 meters north and
87 meters east as shown by dashed corner ticks
Fine red dashed lines indicate selected fence lines
Where omitted, land lines have not been established
There may be private inholdings within the boundaries of
the National or State reservations shown on this map

DEC 3 0 1984
WATER RESOURCES
SALEM, OREGON


Apps. R-80892 & R-80902

148

UNITED STATES
DEPARTMENT OF THE INTERIOR
GEOLOGICAL SURVEY

COMMITTEE CREEK QUADRANGLE
OREGON-CROOK CO.
7.5 MINUTE SERIES (TOPOGRAPHIC)

1977
1:250,000
1:250,000

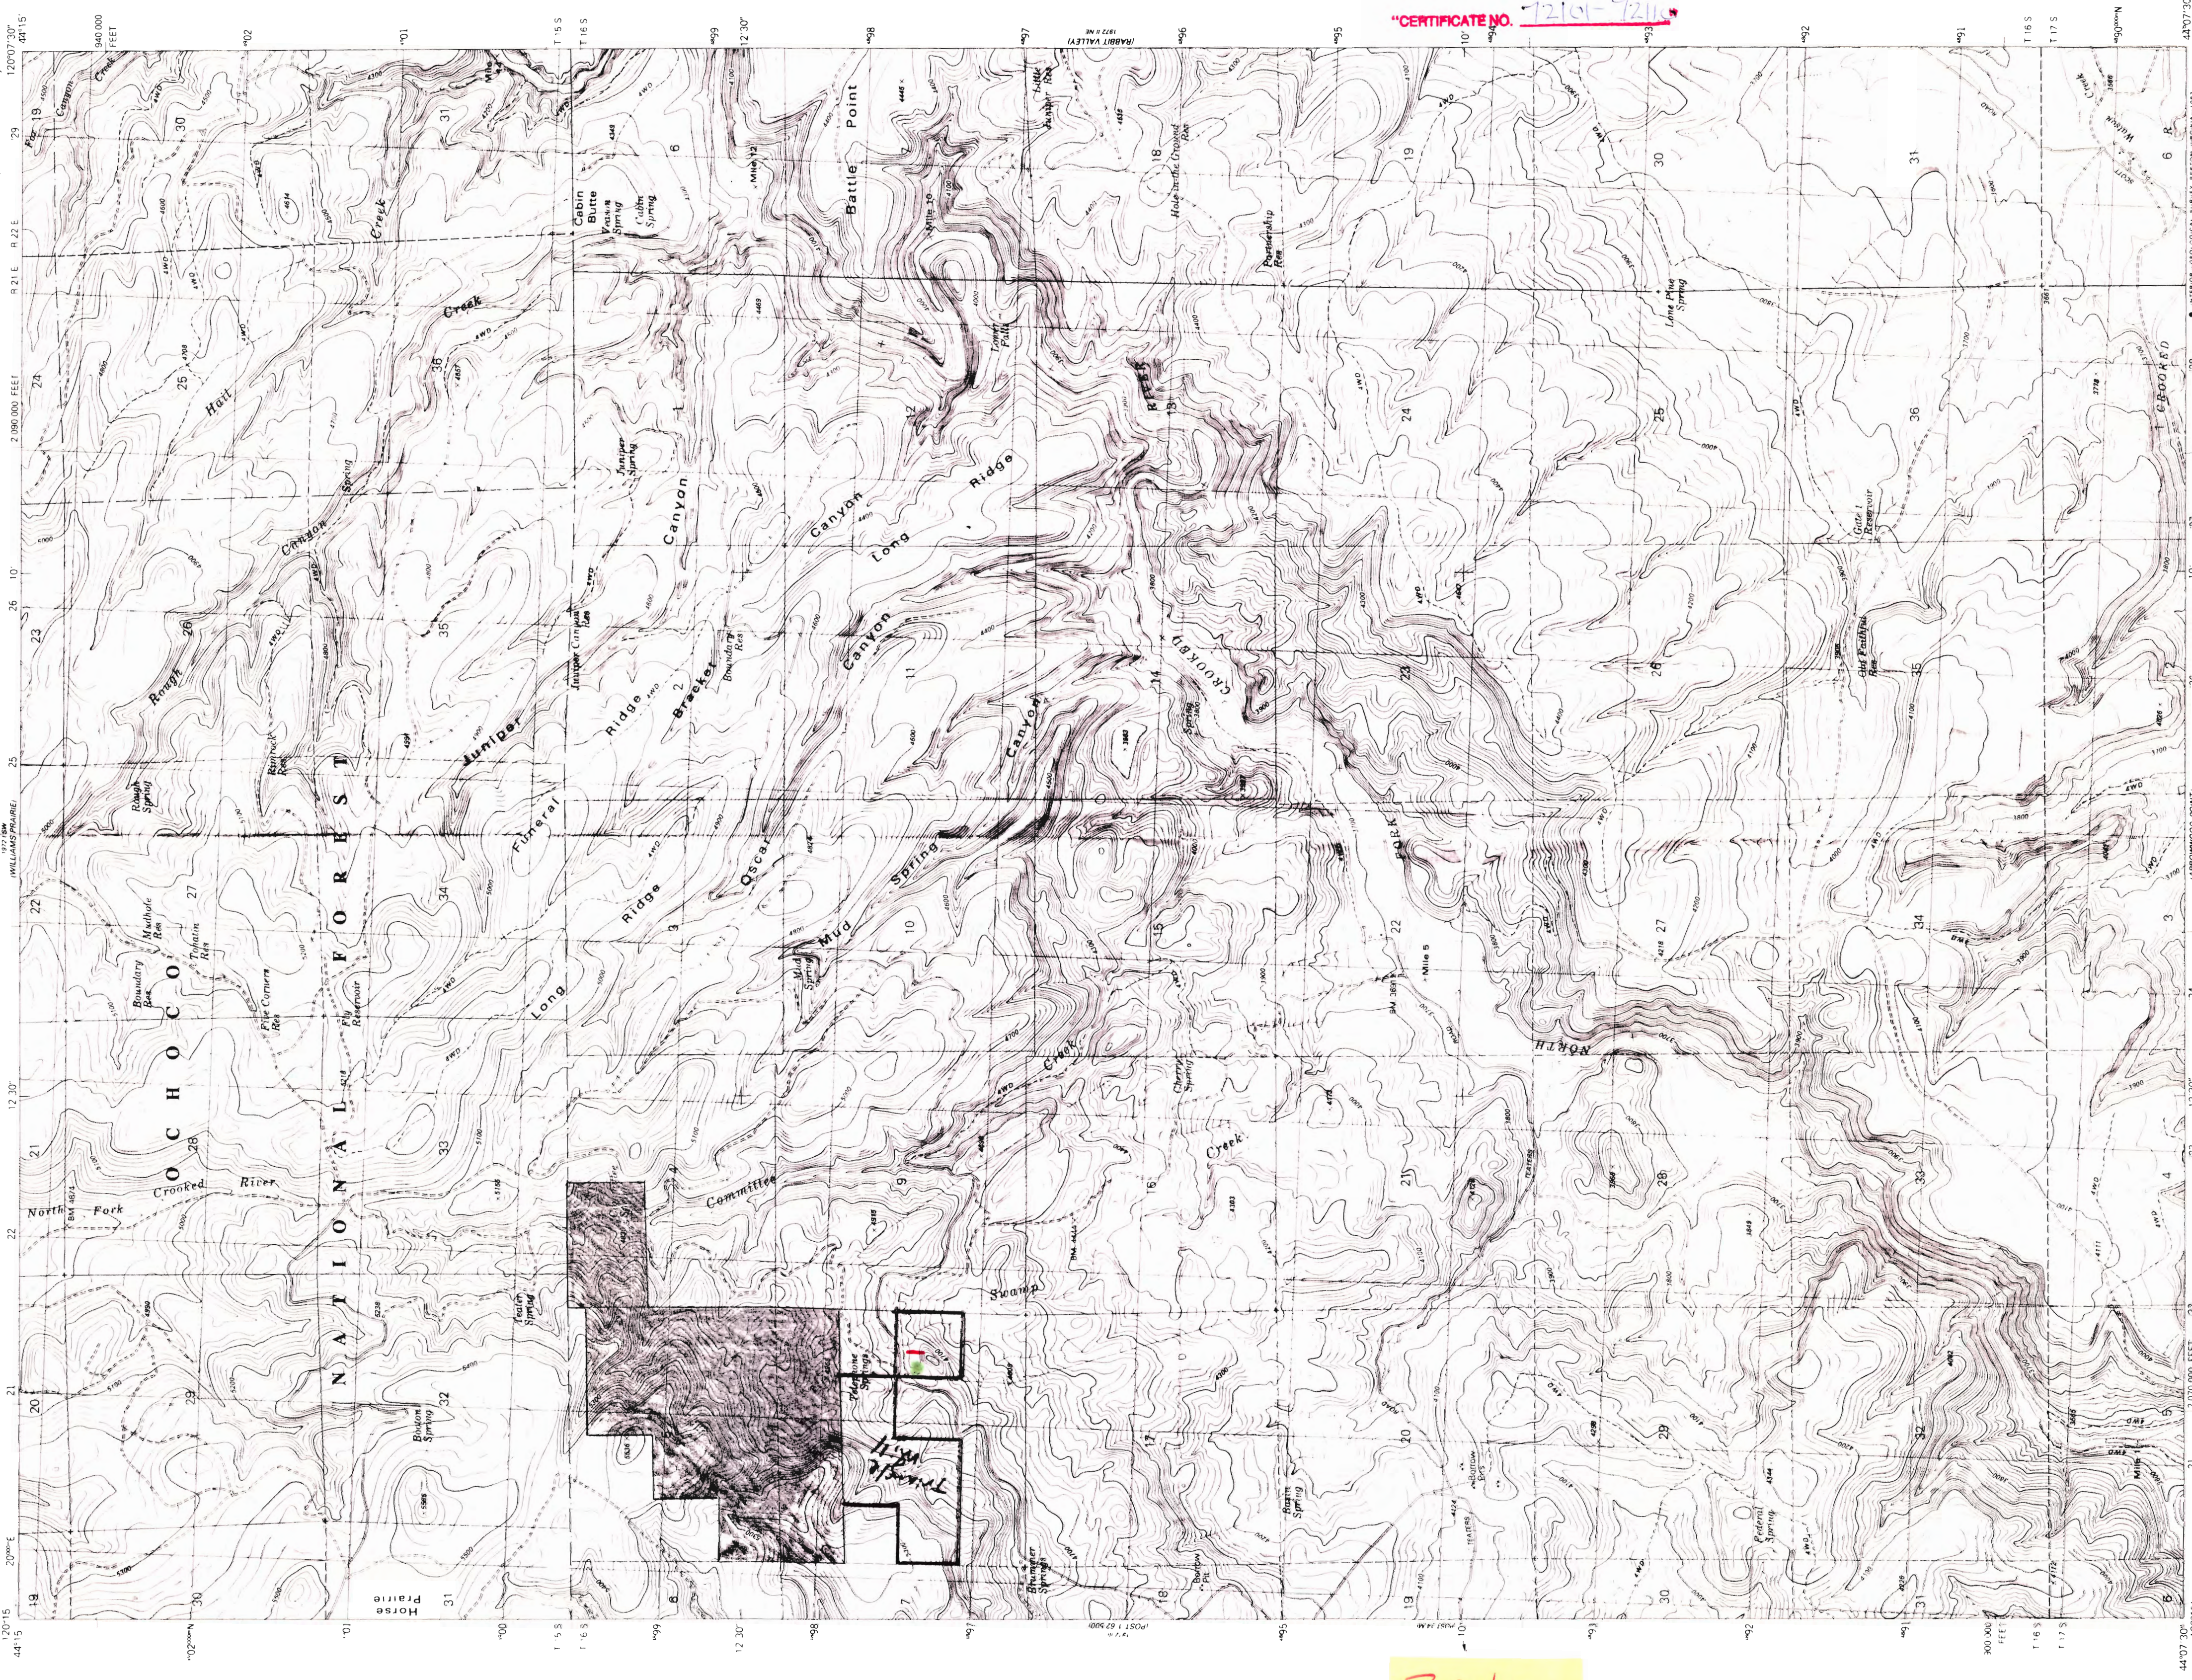


Application No. R-80892 thru R-80902
Permit No.
"CERTIFICATE NO. 72101-72111"

S. Ochoco
Triangle
mill


Apps. R-80892 & R-80902

Mapped, edited, and published by the Geological Survey
Control by USGS and NOS/NOAA
Topography by photogrammetric methods from aerial photographs
taken 1974. Field checked 1977. Map edited 1983.
Projection and 10,000-foot grid ticks. Oregon coordinate
system, south zone (Lambert conformal conic).
1000-meter Universal Transverse Mercator grid, zone 10
1927 North American Datum
To place on the predicted North American Datum 1983
move the projection lines 19 meters north and
88 meters east as shown by dashed corner ticks.
Fine red dashed lines indicate selected fence and field lines
where generally visible on aerial photographs.
This information is unclassified.
There may be private inholdings within the boundaries of
the National or State reservations shown on this map.

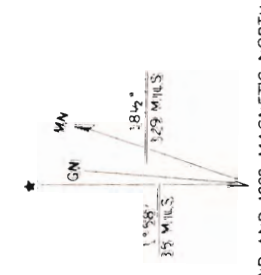

SCALE 1:24,000
CONTOUR INTERVAL 20 FEET
NATIONAL GEODETIC DATUM OF 1929

ROAD CLASSIFICATION
Primary highway
Light-duty road, hard or
hard surface
Secondary highway
Unimproved road
Interstate Route
U.S. Route
State Route

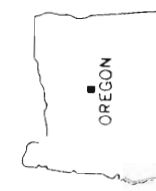

THIS MAP COMPLETES WITH NATIONAL MAP ACCURACY STANDARDS
FOR SALE BY U.S. GEOLOGICAL SURVEY, DENVER, COLORADO 80225, OR RESTON, VIRGINIA 22092
A FOLDER DESCRIBING TOPOGRAPHIC MAPS AND SYMBOLS IS AVAILABLE ON REQUEST

COMMITTEE CREEK, OREG.


1983

DMA 1972 11 NW-SERIES V892

DEC 30 1984
WATER RESOURCES
SALEM, OREGON


148

UNITED STATES
DEPARTMENT OF THE INTERIOR
GEOLOGICAL SURVEY

PRAIRIE HILL QUADRANGLE

OREGON-CROOK CO.

7.5 MINUTE SERIES (TOPOGRAPHIC)

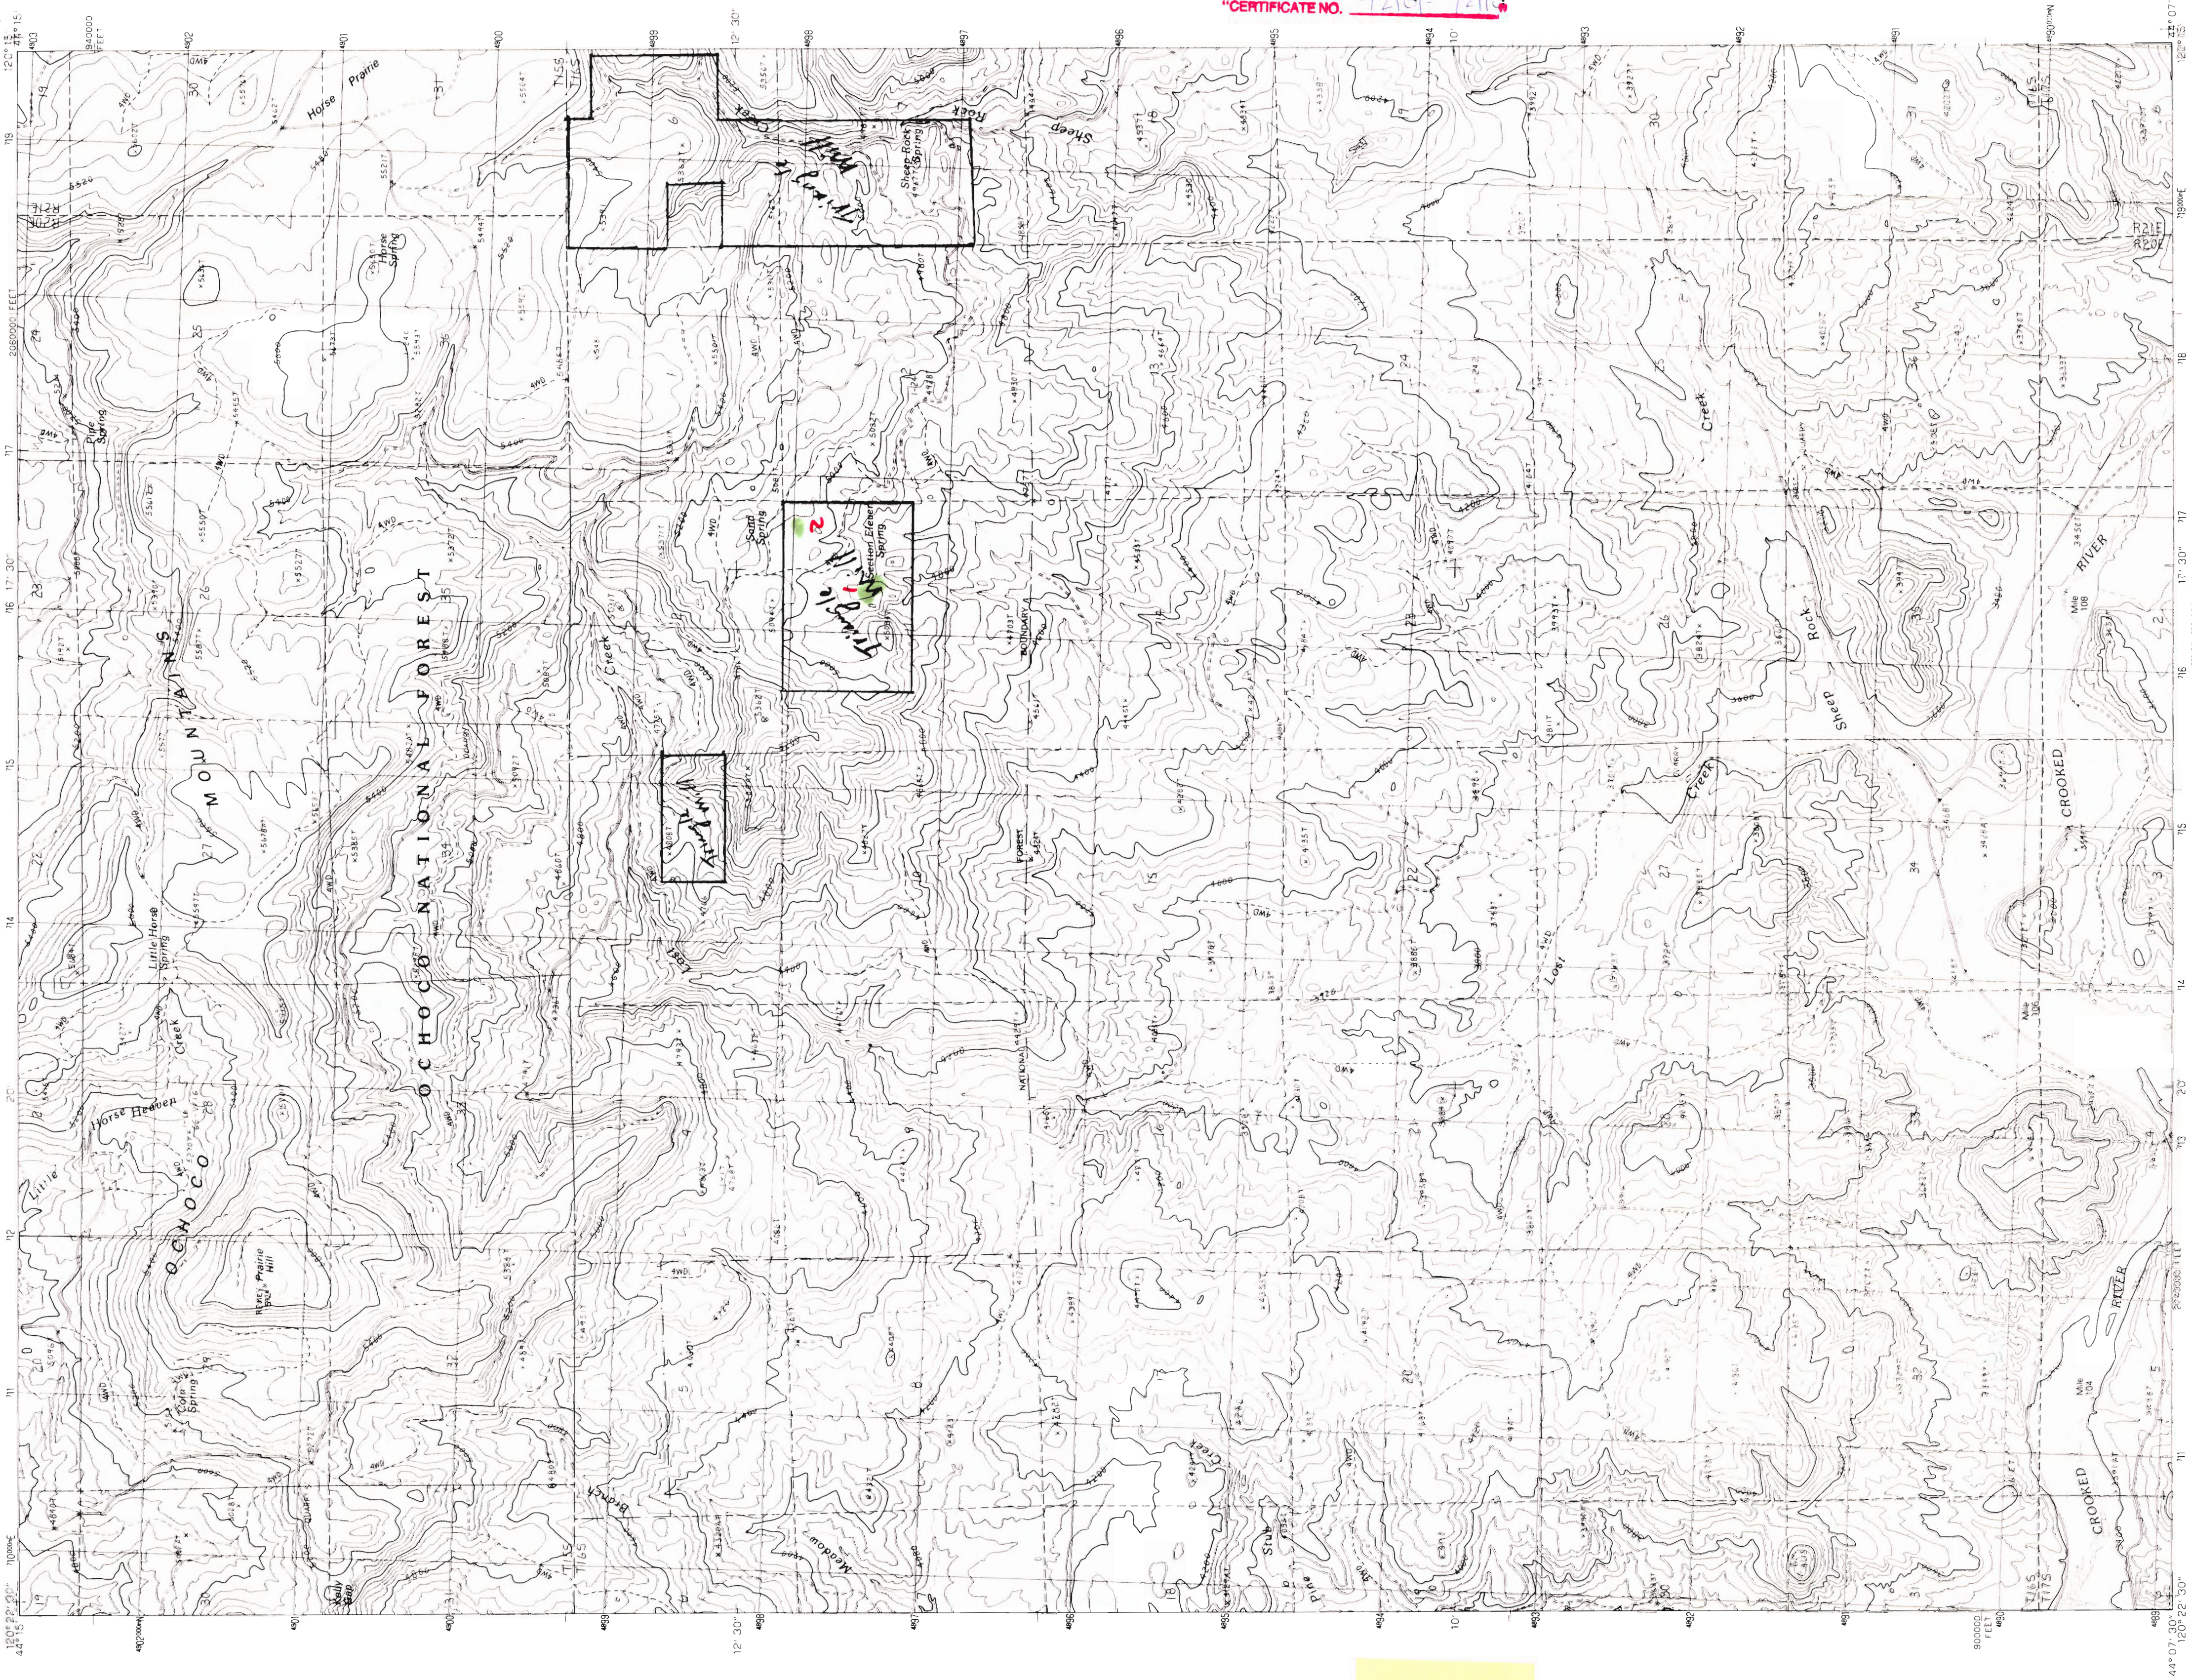

PRODUCED BY THE UNITED STATES GEOLOGICAL SURVEY
CONTROL FROM AERIAL PHOTOGRAPHS TAKEN BY THE U.S. GEOLOGICAL SURVEY
FIELD CHECKED: 1986 MAP EDITED: 1990
PROJECTION: UTM TRANSVERSE MERCATOR LAMBERT CONFORMAL CONIC
GRID: 10,000 FOOT STATE GRID TICS SOUTH ZONE
UTM GRID DECLINATION: 1.52 EAST
1990 MAGNETIC NORTH DECLINATION: 1.52 EAST
HORIZONTAL DATUM: 1927 NORTH AMERICAN DATUM
To place on the predicted North American Datum of 1983,
move the projection lines as shown by dashed corner tie
(20 meters north and 89 meters east)
There may be private inholdings within the boundaries of the
Federal or State reservations shown on this map

PROVISIONAL MAP
Produced from original
manuscript drawings. Infor-
mation shown as of date of
field check.

SCALE 1:24 000



CONTOUR INTERVAL 40 FEET
SUPPLEMENTARY CONTOUR INTERVAL 20 FEET
To convert meters to feet multiply by 3.2808
To convert feet to meters multiply by .3048

THIS MAP COMPLETES WITH NATIONAL MAP ACCURACY STANDARDS
FOR SALE BY U.S. GEOLOGICAL SURVEY, DUNN, COLORADO 80225, GPO, RESTON, VIRGINIA 22092

1	2	3	4	5	6	7	8

ALSO SEE 7.5 QUADRANGLE NAMES

ROAD LEGEND
Improved Road
Unimproved Road
Trail
Interstate Route
U. S. Route
State Route

PRAIRIE HILL, OREGON
PROVISIONAL EDITION 1990

44120-B3-TF-024


Application No. R-80892-K-80902
Permit No.

"CERTIFICATE NO. 72161-72162"

RECEIVED
DEC 30 1994
WATER RESOURCES DEPT.
SALEM, OREGON

Triangle
Mill

Apps. R-80892 & R-80902

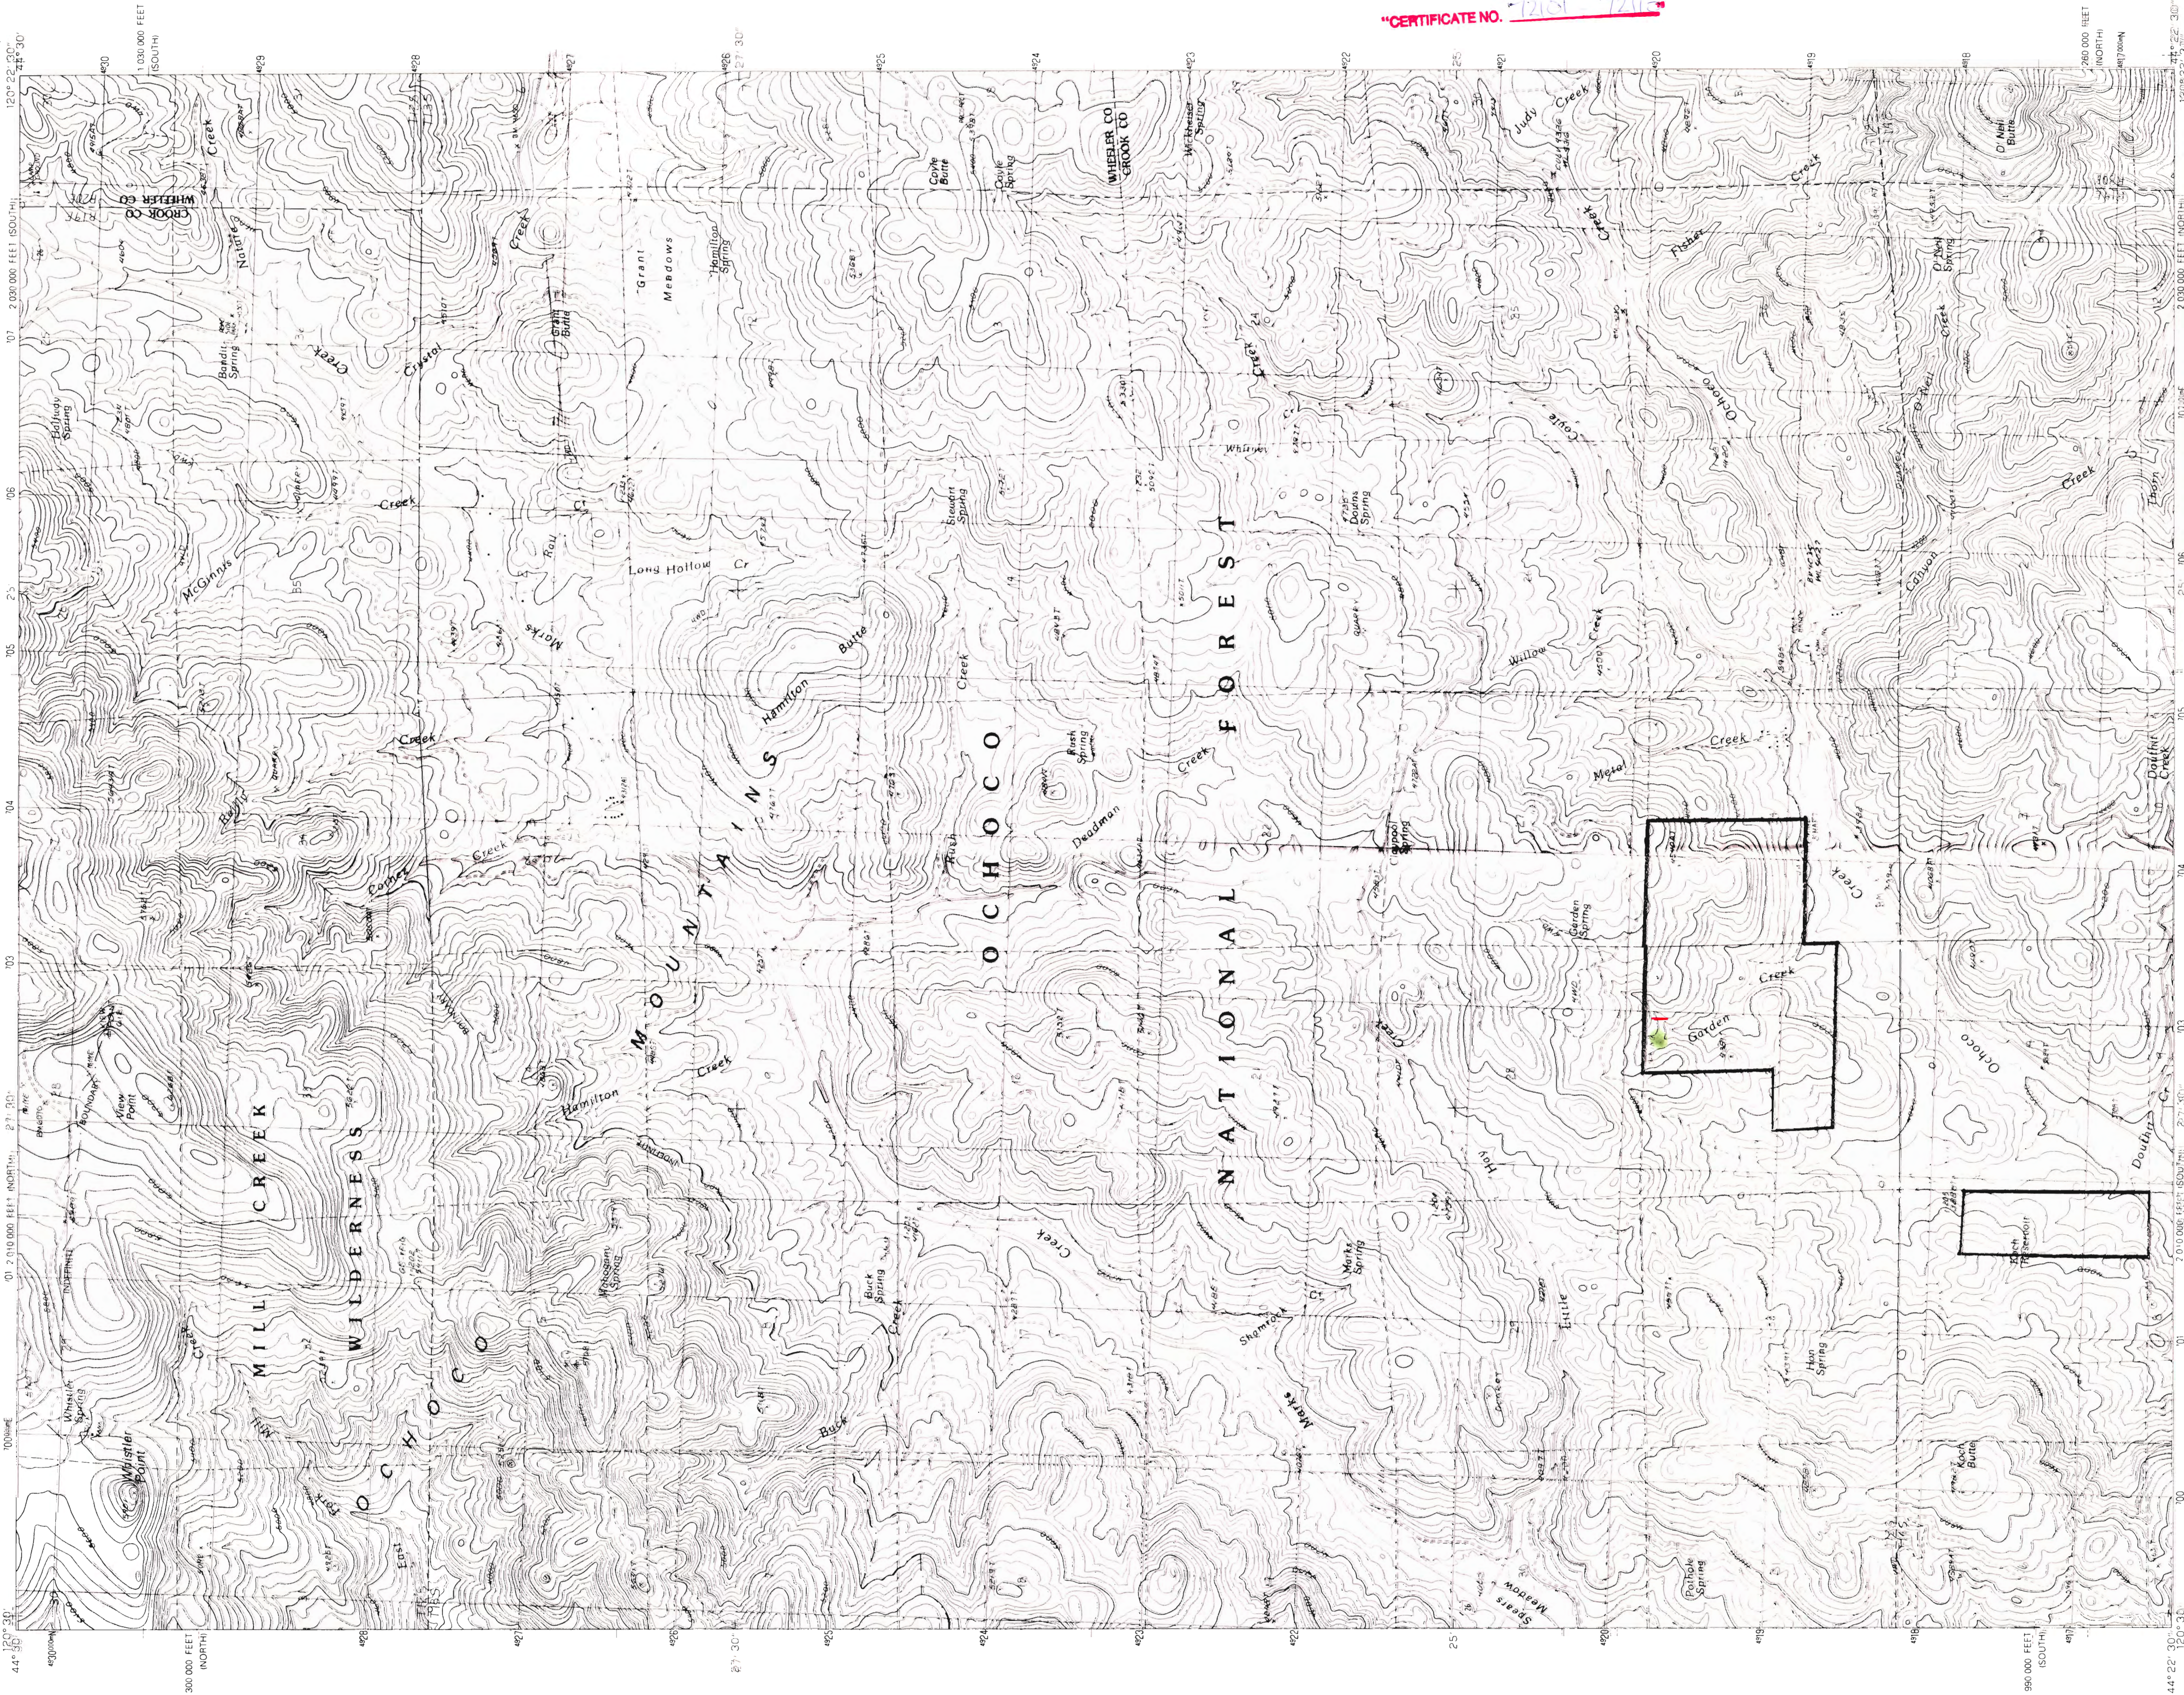

PRODUCED BY THE UNITED STATES GEOLOGICAL SURVEY
FROM AERIAL PHOTOGRAPHS TAKEN IN 1966 AND 1968
FIELD CHECKED 1986. MAP EDITED 1990
GRID 1000-METER UNIVERSAL TRANSVERSE MERCATOR, ZONE 10
10 000-FOOT STATE GRID TICS
UTM GRID DECLINATION AND NORTH ZONES
1990 MAGNETIC NORTH DECLINATION 18°00' EAST
VERTICAL DATUM, NATIONAL GEODETIC VERTICAL DATUM OF 1929
To place the projection lines as shown by dashed corner ticks
(20 meters north and 89 meters east)
There may be private inholdings within the boundaries of any
Federal or State reservations shown on this map

PROVISIONAL MAP
Produced from original
manuscript drawings. Infor-
mation shown as of date of
field check.

SCALE 1:24 000




CONTOUR INTERVAL 40 FEET

To convert meters to feet multiply by 3.2808
To convert feet to meters multiply by .3048

THIS MAP COMPLIES WITH NATIONAL MAP ACCURACY STANDARDS
FOR SALE BY U.S. GEOLOGICAL SURVEY
DENVER, COLORADO 80225 OR RESTON, VIRGINIA 22092

1	2	3	4	5	6	7	8

ROAD LEGEND

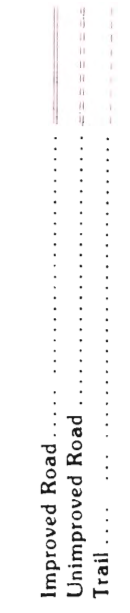

Interstate Route U.S. Route State Route

WHISTLER POINT, OREGON
PROVISIONAL EDITION 1990

44120-D4-TF-024


Application No. R-80892 - R-80902
Permit No.

*CERTIFICATE NO. 72101 - 72102

DEC 30 1994
JAMES DEHL
OREGON

Apps. R-80892 & R-80902

DEC 30 1994

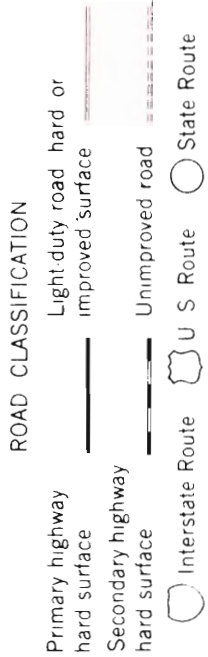

44120-103117-024

UTM GRID AND 1985 MAGNETIC NORTH
DEFINITION AT CENTER OF SHEET


Where omitted, land lines have not been established. There may be private inholdings within the boundaries of the National or State reservations shown on this map.

Apps. R-80892 & R-80902

148

UNITED STATES
DEPARTMENT OF THE INTERIOR
GEOLOGICAL SURVEY


WILLIAMS PRAIRIE QUADRANGLE
OREGON—CROOK CO.
7.5 MINUTE SERIES (TOPOGRAPHIC)

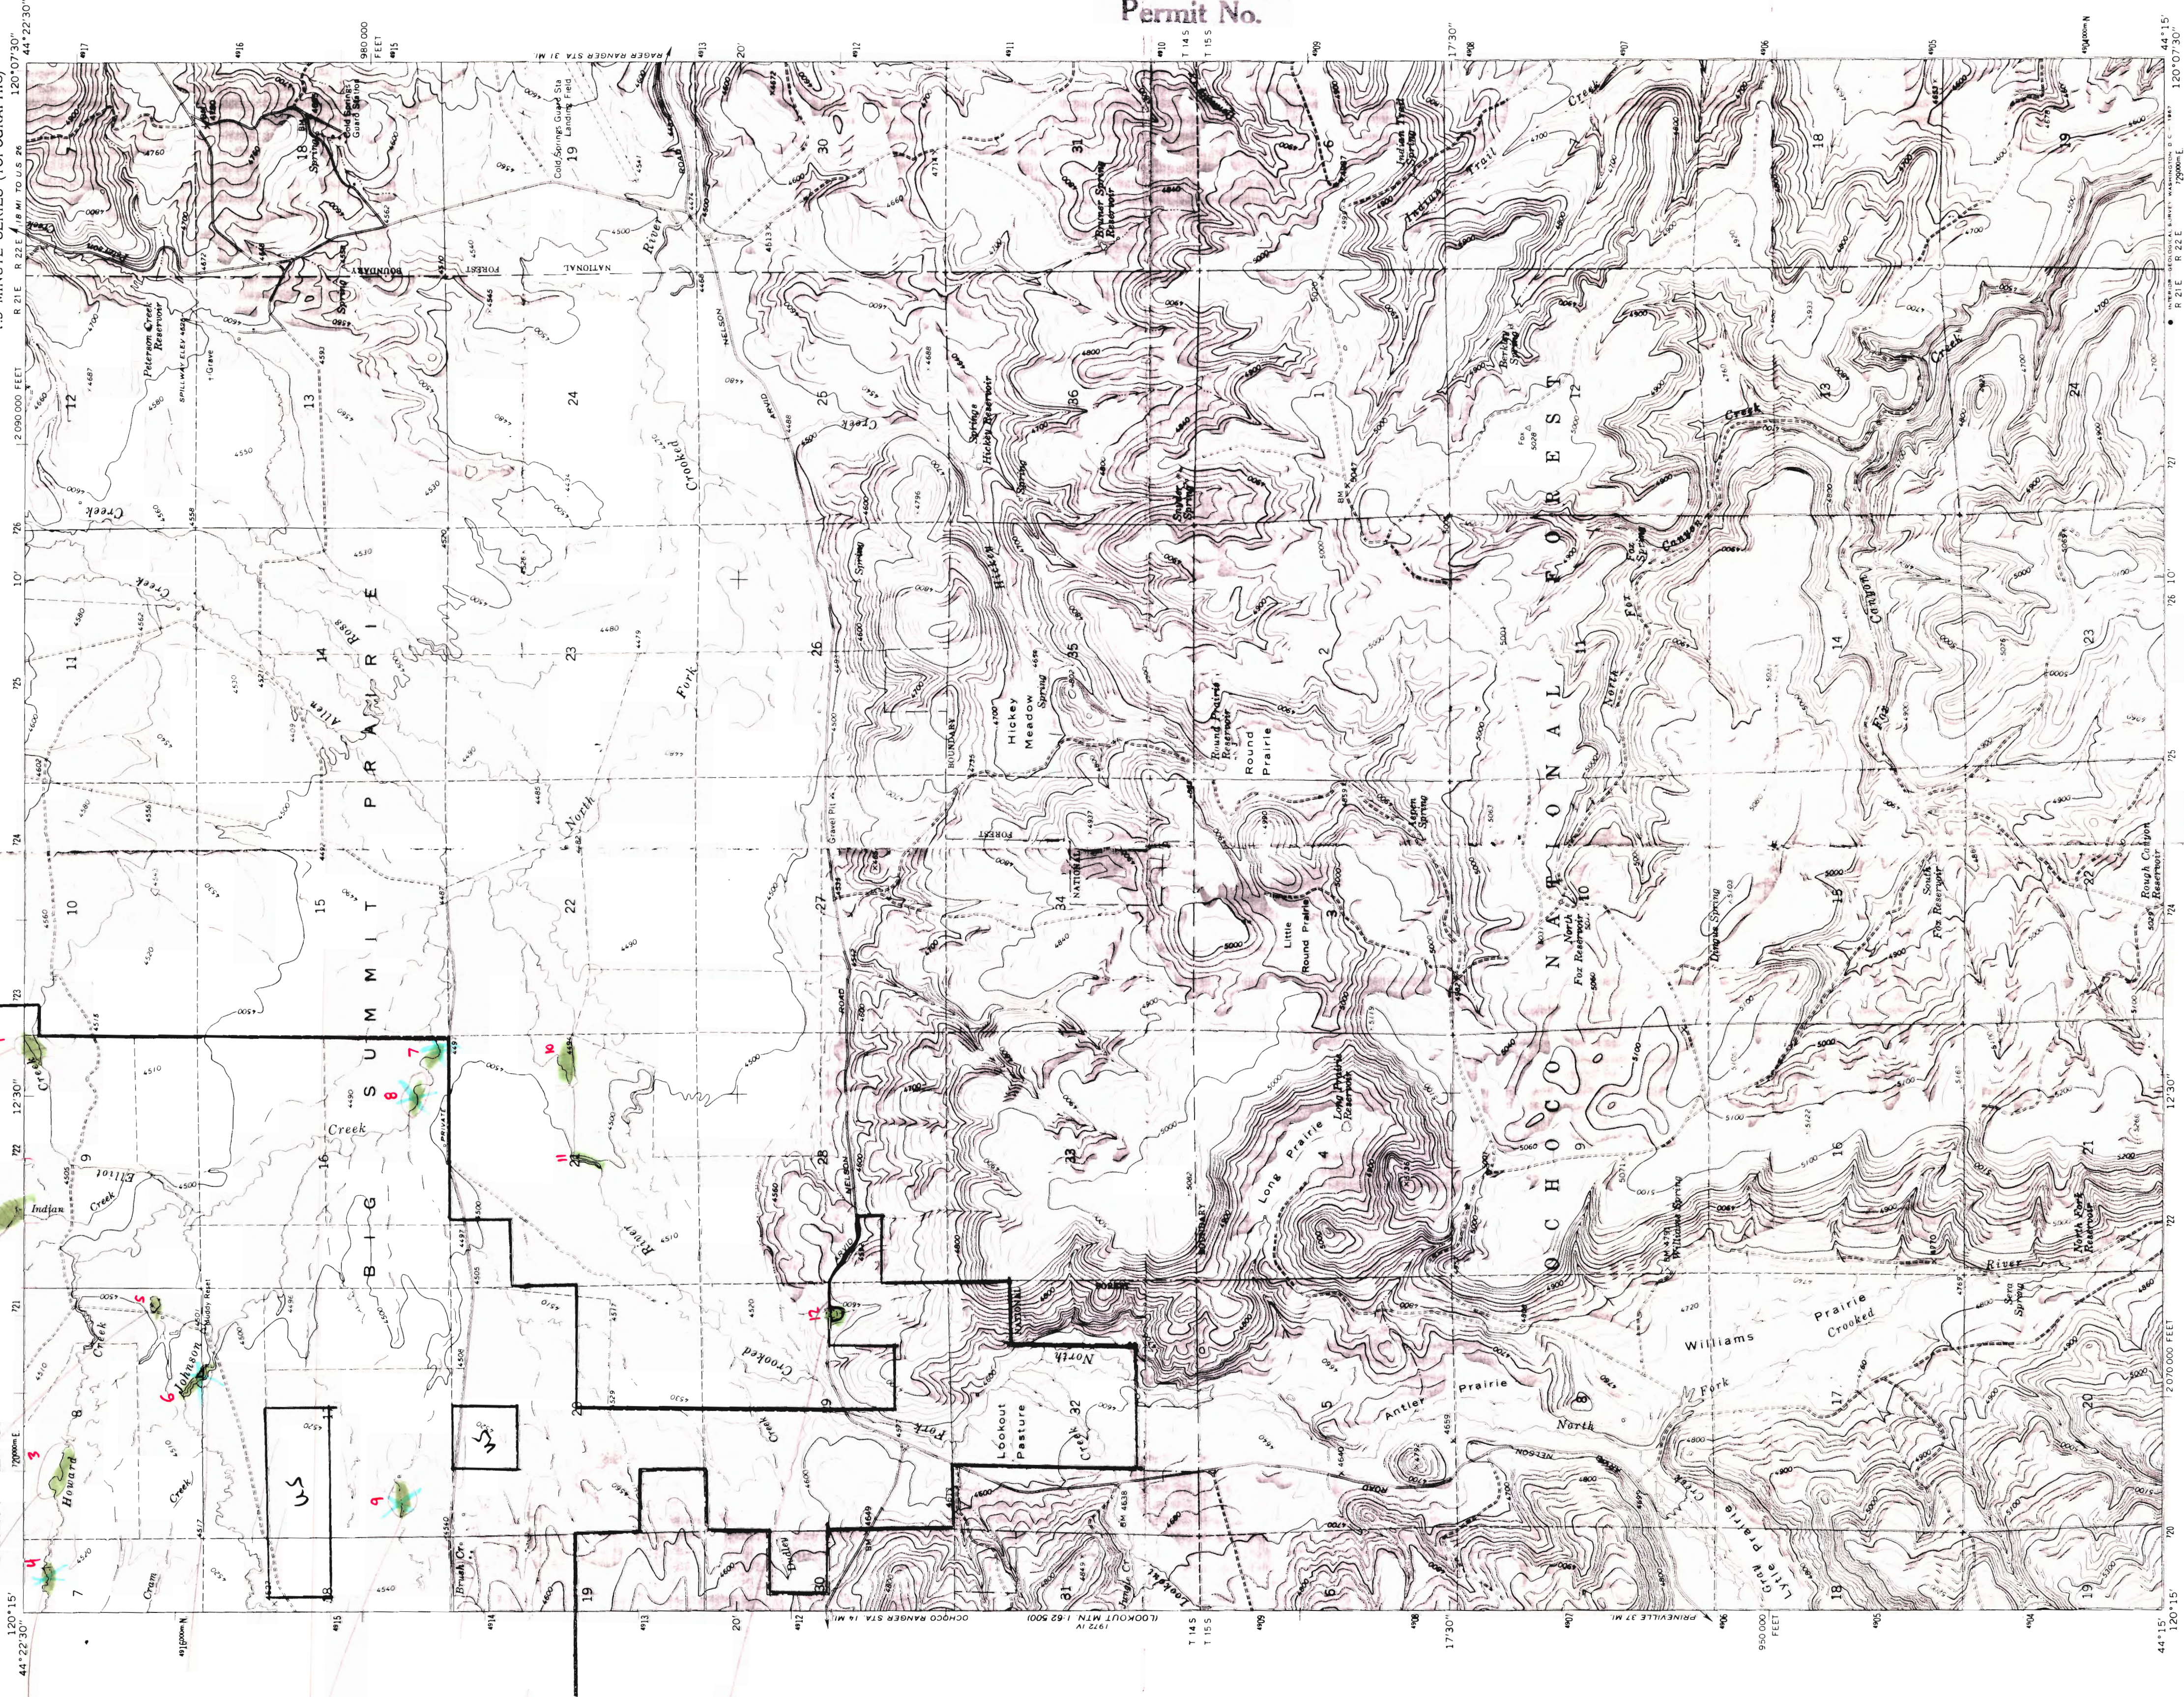

CERTIFICATE NO. 72101-72110

Application No. F-80892 - R-80902
Permit No.

Mapped, edited, and published by the Geological Survey
Control by USGS and USC&GS
Topography by photogrammetric methods from aerial
photographs taken 1959 and planimetric surveys 1965
Polyconic projection. 1927 North American datum.
10,000-foot grid based on Oregon coordinate system.
1000-meter Universal Transverse Mercator grid ticks,
zone 10, shown in blue.
Fine red dashed lines indicate selected fence lines.

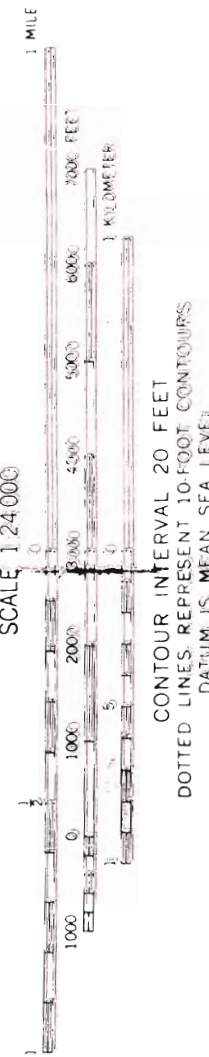

ROAD CLASSIFICATION
Unimproved dirt
Light duty



THIS MAP COMPLETES WITH NATIONAL MAP ACCURACY STANDARDS
FOR SALE BY U.S. GEOLOGICAL SURVEY, DENVER, COLORADO 80225, OR WASHINGTON, D.C. 20242
A FOLDER DESCRIBING TOPOGRAPHIC MAPS AND SYMBOLS IS AVAILABLE ON REQUEST

WILLIAMS PRAIRIE, OREG.
N4415-W12007.5/7.5
1965
ANS 1972 1 SW-SERIES V892

Application R-80892 - L-80902
Permit No.

"CERTIFICATE NO. 72101-72102"

DEC 8 1994
WATER RESOURCES DIVISION
SALEM, OREGON


ROAD LEGEND
Improved Road
Unimproved Road
Trail
Intrastate Route
U.S. Route
State Route
SERVICE CREEK, OREG.
PROVISIONAL EDITION 1987
44120-GT-TF-024

QUADRANGLE LOCATION							
1	2	3	4	5	6	7	8
1	2	3	4	5	6	7	8

CONTOUR INTERVAL 40 FEET
SUPPLEMENTARY CONTOUR INTERVAL 20 FEET
To convert meters to feet multiply by 3.2808
To convert feet to meters multiply by 0.3048

PROVISIONAL MAP
Produced from original
manuscript drawings. Infor-
mation shown as of date of
field check.

PRODUCED BY THE UNITED STATES GEOLOGICAL SURVEY
CONTROL BY AERIAL PHOTOGRAPHY TAKEN
FIELD CHECKED
REVISION FROM AERIAL PHOTOGRAPHS TAKEN
PRODUCTION
UNITED STATES GEOLOGICAL SURVEY
WASHINGTON, D.C. 20508
1987

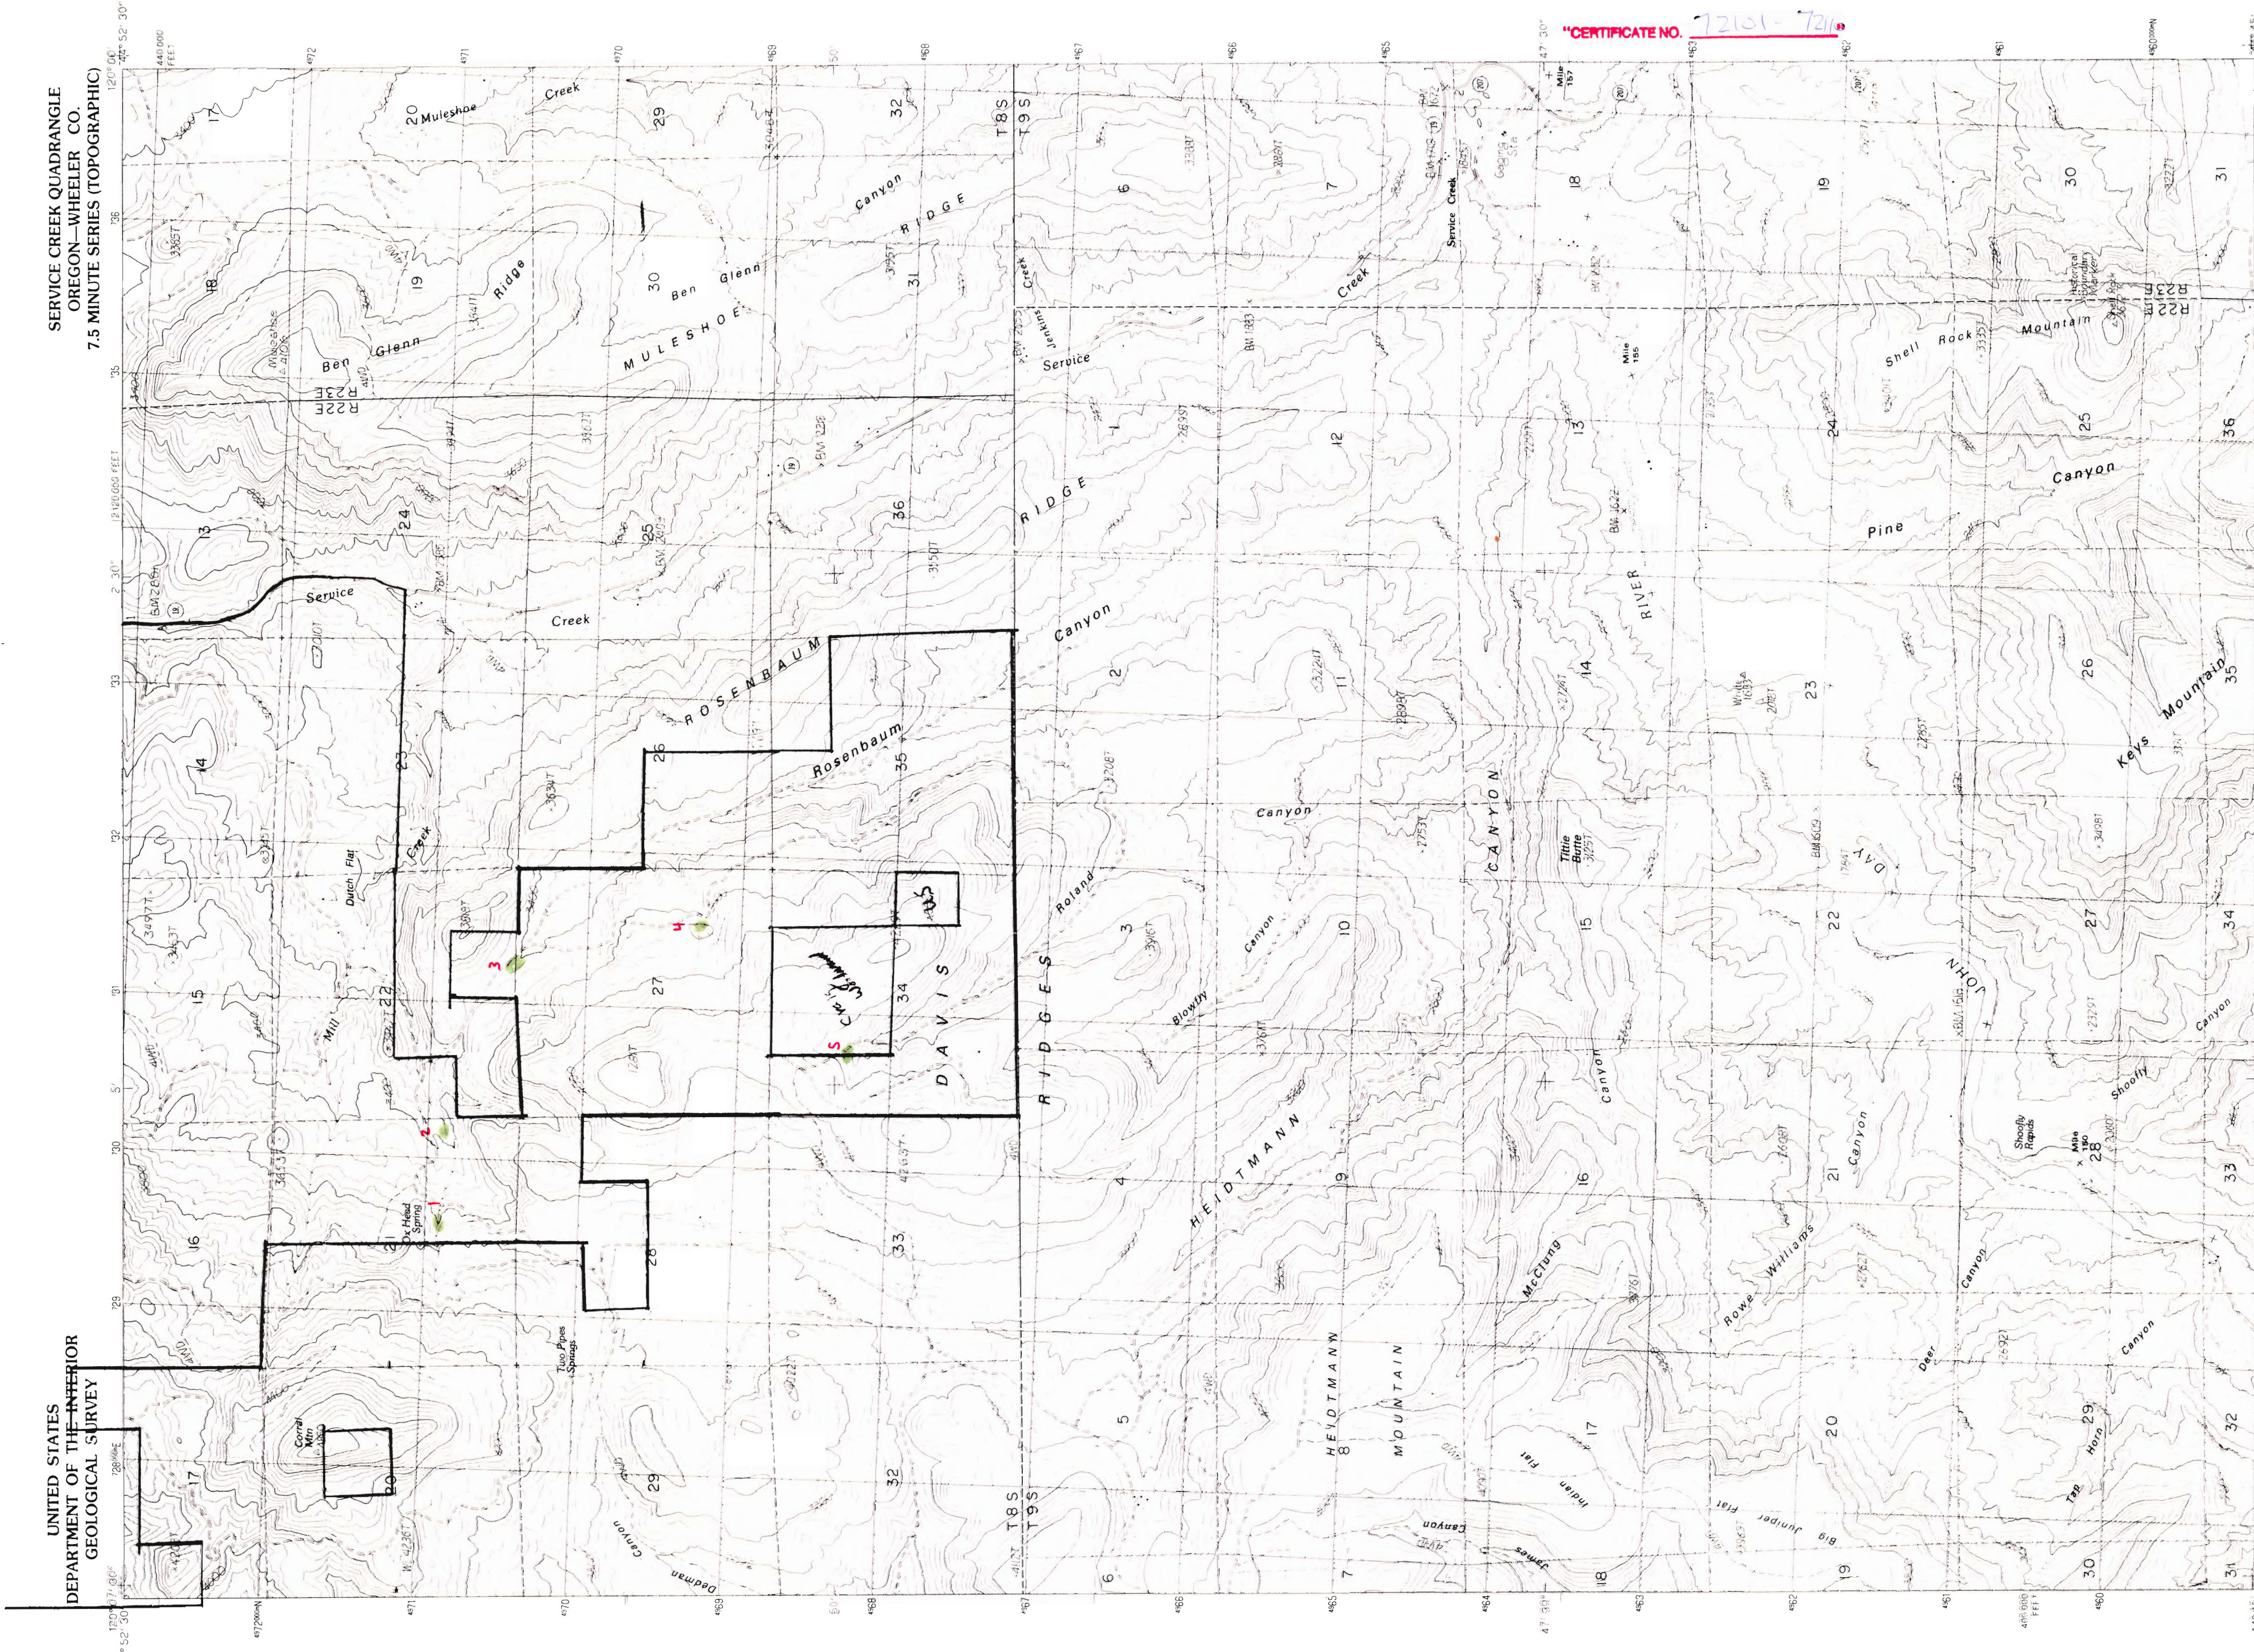

Apps. R-80892 & R-80902