


2 of 4 p

SKETCH
SHOWING
THE LOCATION OF
THE H.M. EVITT DITCHES
AND PLACER GROUND
IN SEC. 17, T9 S, R39 E, W.M.,
BAKER CO. ORE.
SCALE, ONE INCH = 300 FT.
SURVEYED, MAY 26, 1924.

Ira L. Hoffman
County Surveyor

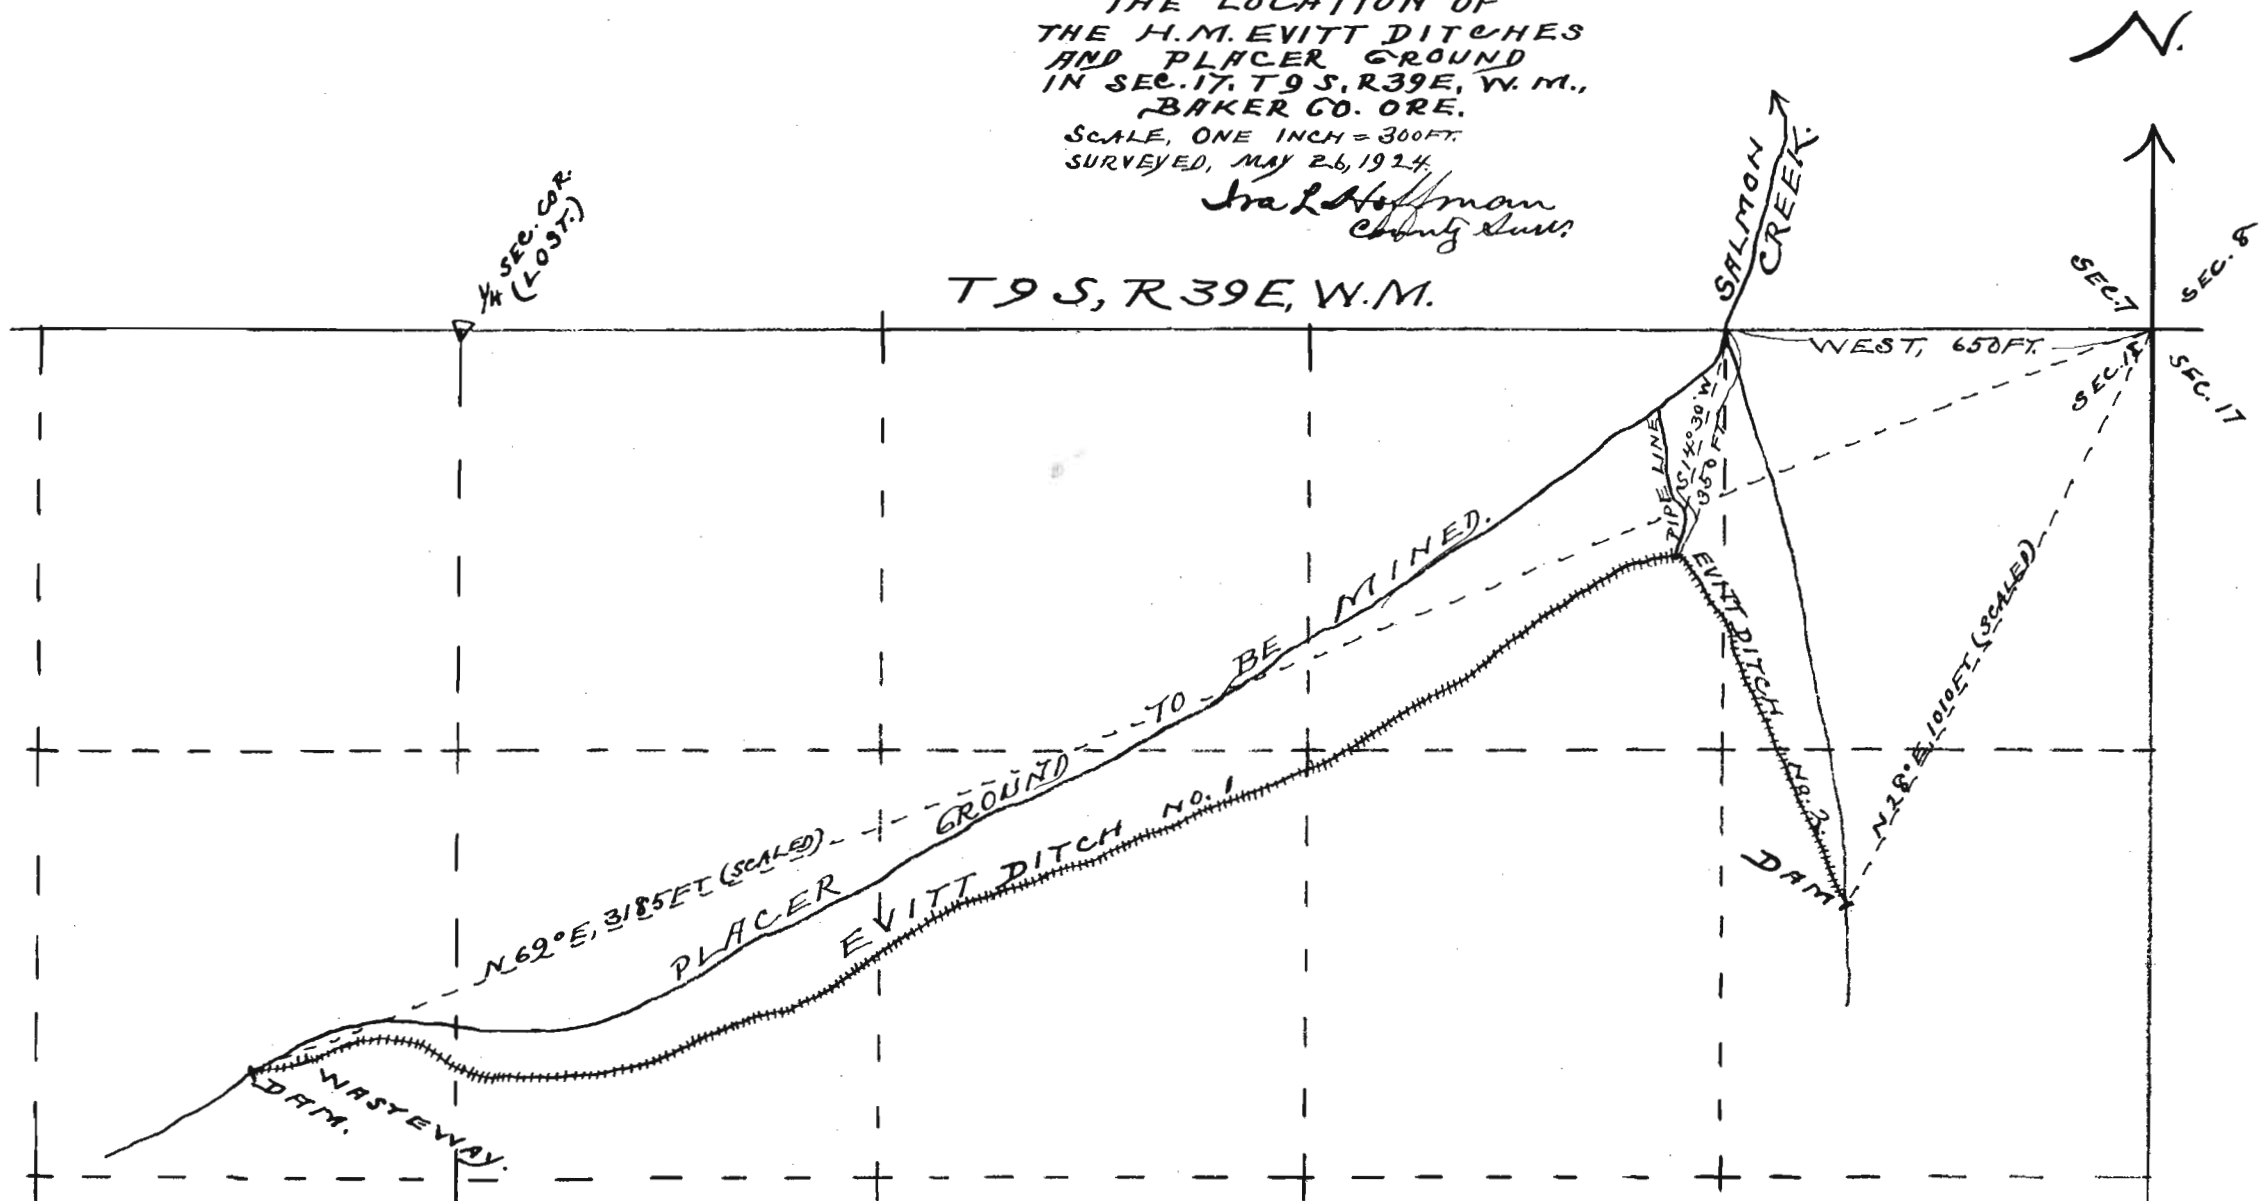

CERTIFICATE OF SURVEYOR.

I, IRA L. HOFFMAN, OF BAKER, ORE., DO HEREBY CERTIFY
THAT THIS MAP WAS MADE FROM NOTES TAKEN DURING
AN ACTUAL SURVEY MADE BY ME ON MAY 26, 1924 AND
THAT IT CORRECTLY REPRESENTS THE DATA SHOWN THEREON.

Ira L. Hoffman
County Surveyor



STATE ENGINEER
RECEIVED

MAY 31 1924

BAKER, OREGON

Application No. 9466.
Permit No. 6306

2 of 4 p