


T.4S.,R.12E.,W.M.

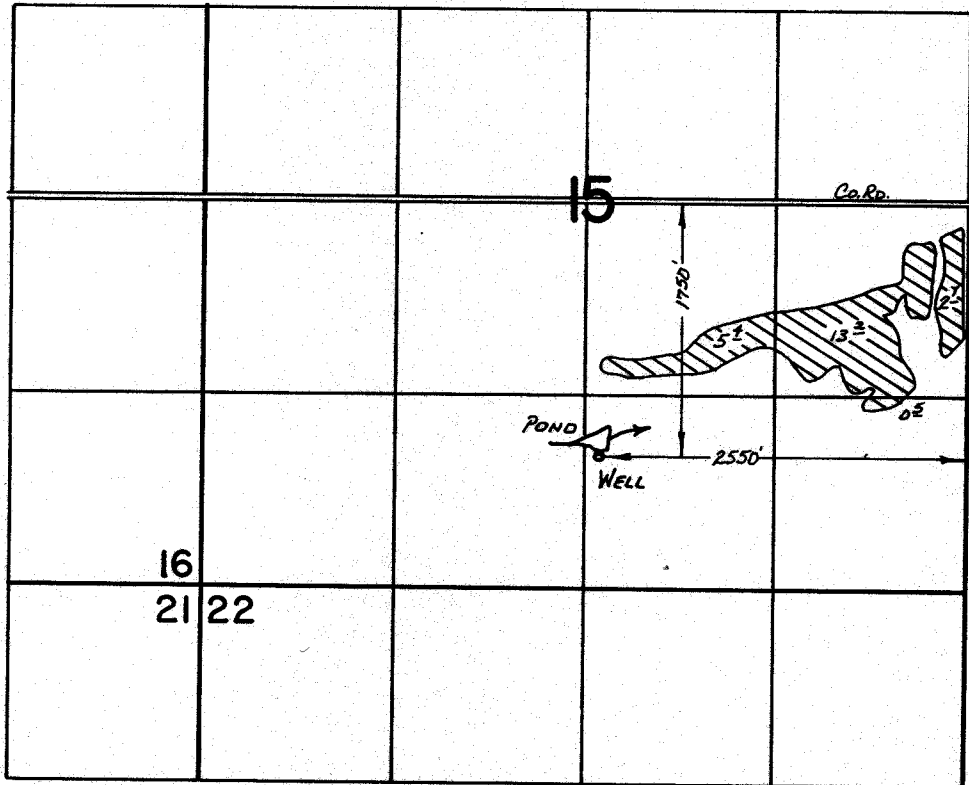

FINAL PROOF SURVEY UNDER

Application No. G-9518... Permit No. G-8932.....
IN NAME OF

.....LEO E. JILK.....

Surveyed June 19... 1984., by J. L. Toll.....