


T. 40 S., R. 8 W., W.M.

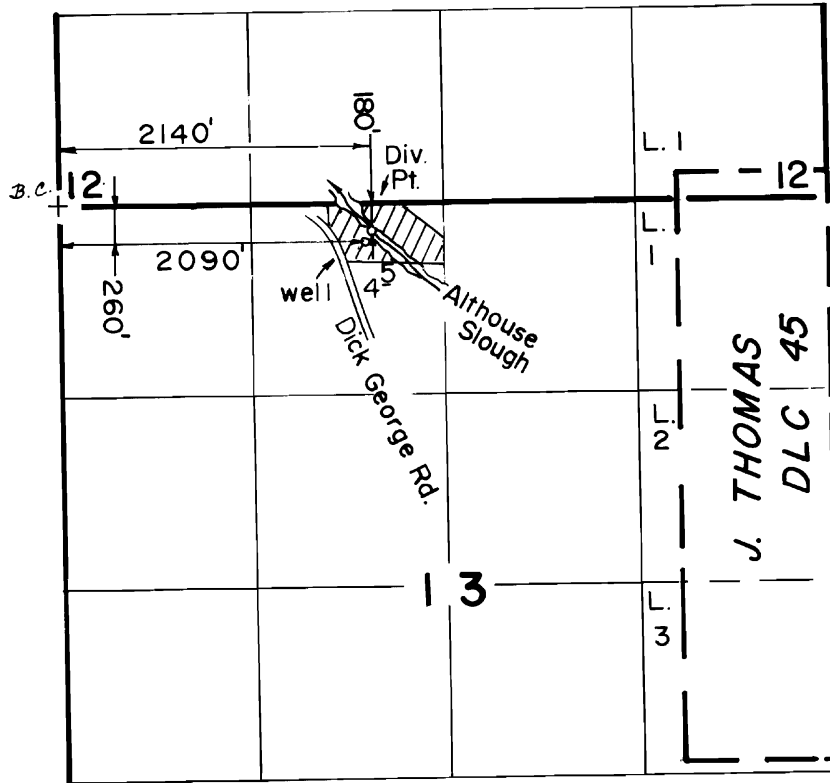

Scale: 1" = 1320'

FINAL PROOF SURVEY

UNDER

TRANSFER NO. 5305

Application No. G-11007 Permit No. G-10225
IN NAME OF

ROBERT A. DASCH

Surveyed APR. 2. 1986, by B. S. JAMES.