


# T.36S., R.1E. W.M.

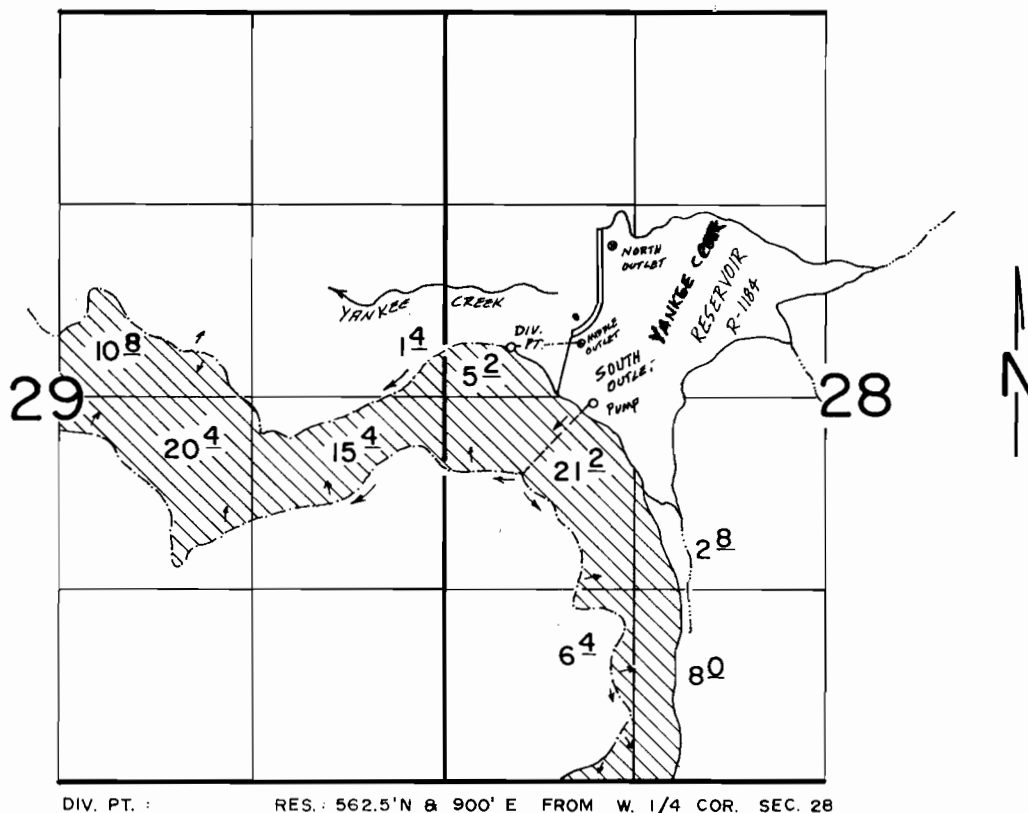

Scale : 1" = 1320'

## FINAL PROOF SURVEY UNDER

Application No. 39022 Permit No. 29067.....

IN NAME OF

...MURPHY & or JULENE CLARK

Surveyed JUNE 13, 1984, by B.S. JAMES.....