


T. 36 S., R. 1 E. W. M.

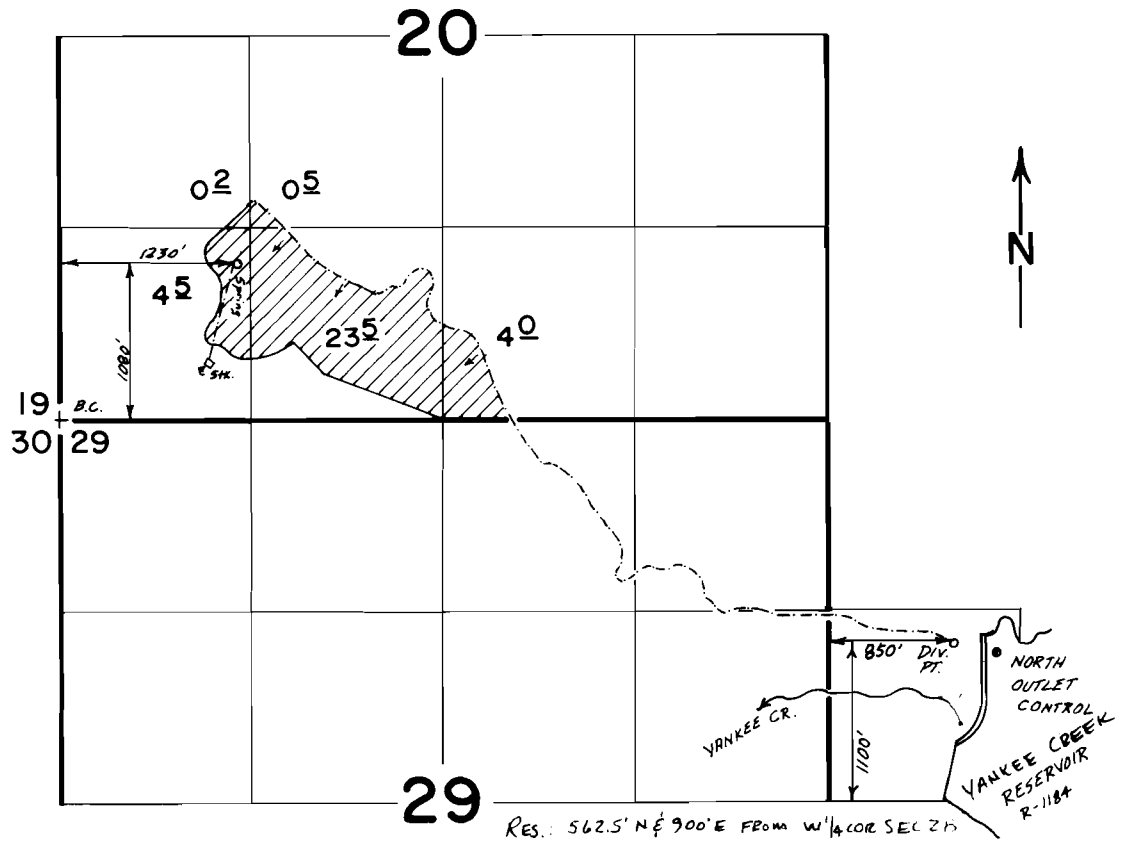

Scale : 1" = 1320'

FINAL PROOF SURVEY
UNDER

Application No. **41557**..... Permit No. **30999**.....
IN NAME OF

.....**MURPHY & JULIENE CLARK**.....

Surveyed **June 13, 1984**, by **B.S. JAMES**.....