


T. 35 S., R. 5 W., W.M.

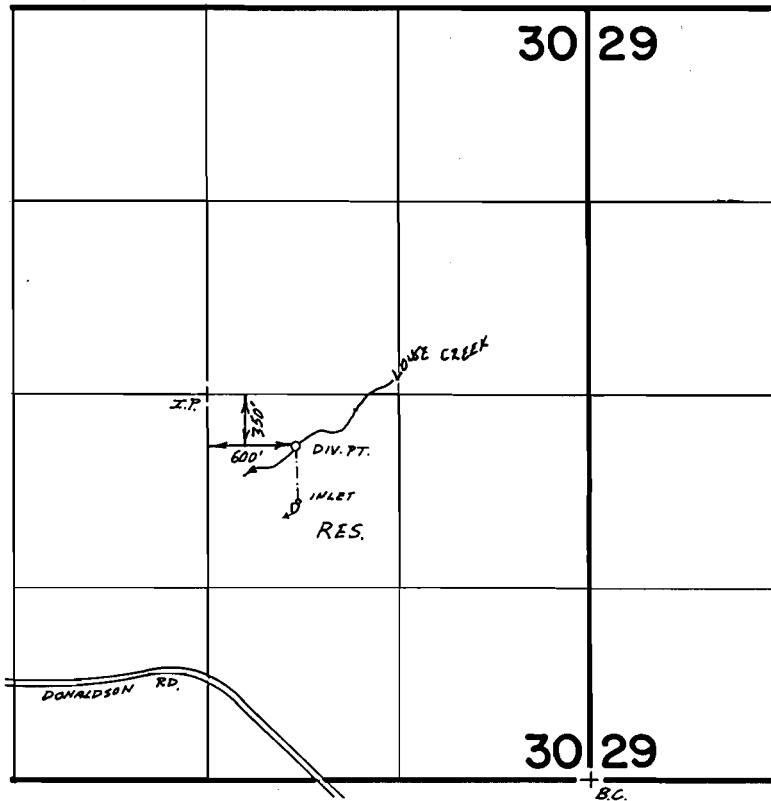

Scale 1" = 1320'

FINAL PROOF SURVEY
UNDER

Transfer No. 4705

R-63035

R-8398

Application No. 63209. Permit No. 466651...

IN NAME OF

.....
Surveyed July 10, 1984, by B.S. JAMES.....