


T. 35 S., R. 5 W., W.M.

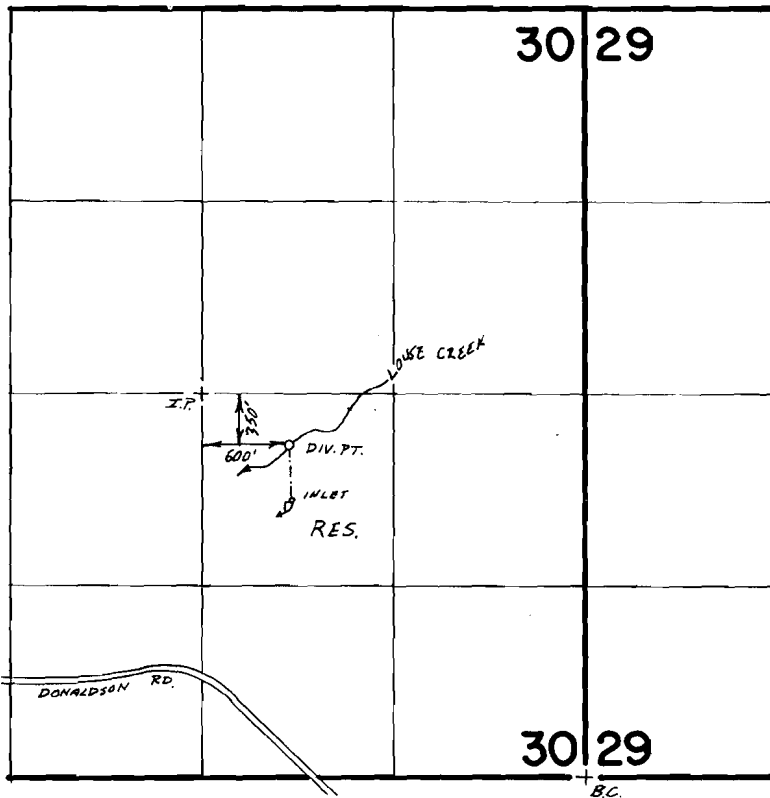

Scale 1" = 1320'

FINAL PROOF SURVEY
UNDER

Transfer No. 4705
R-63035 R-8398
Application No. 63209. Permit No. 46665.....
IN NAME OF

.....
Surveyed July 10, 1984, by B.S. JAMES.....