



C-73984 P48194

T. 13 S., R. 30 E., W.M.

RECEIVED

JUL - 1 1993

WATER RESOURCES DEPT.
SALEM, OREGON

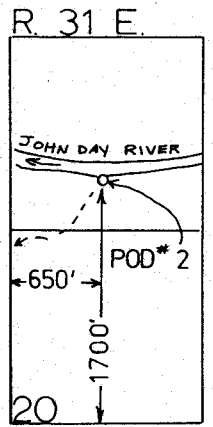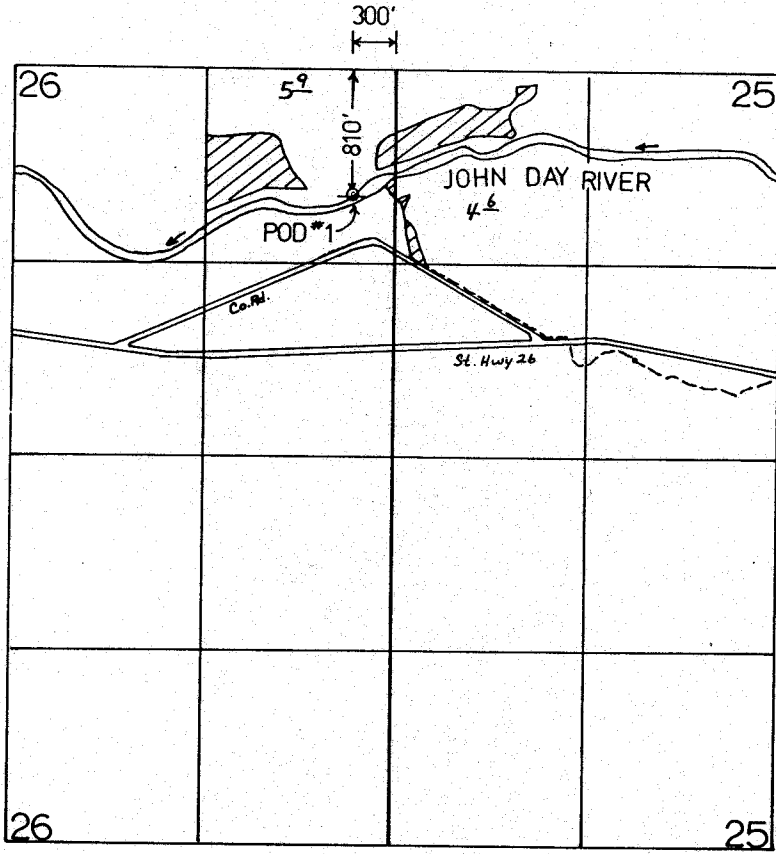

1" = 1320'

FINAL PROOF SURVEY

UNDER

Application No. 67432 Permit No. 48194
IN NAME OF

MARILYN SMITH

Surveyed 6-21, 1988, by V. L. CHURCH