


T.4S., R.38E., W.M.

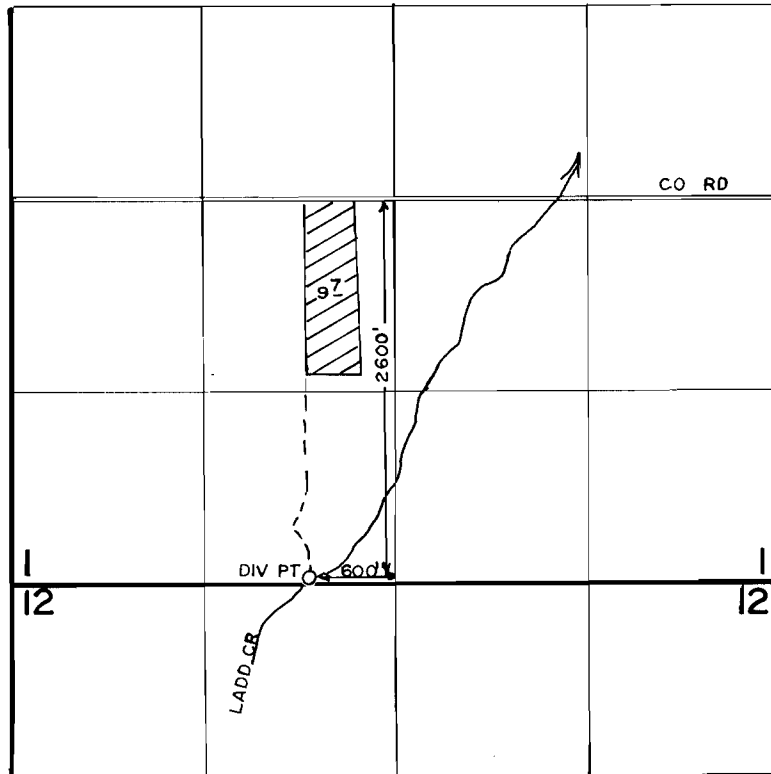

SCALE: 1"=1320'

**FINAL PROOF SURVEY
UNDER**

Application No. 68425. Permit No. 49602.....
IN NAME OF

.....HARRY B FRASHER.....

Surveyed JUNE 14. 1990., by H B HADDEN.....