


T. 38 S. R. 8 W. W. M

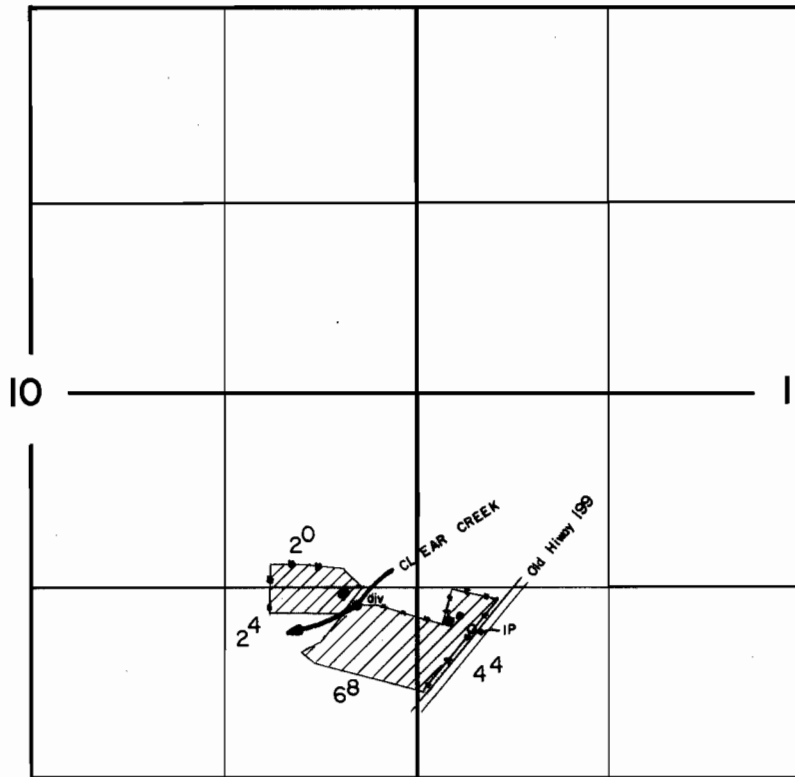

FINAL PROOF SURVEY UNDER

Application No. 39843 Permit No. 29660
IN NAME OF

Fred & Patricia Krauss — David H. & Mary P. Lloyd

Surveyed Feb. 26 1965., by R.B. Steimer