


T. 9S. R. 4 W. W.M.

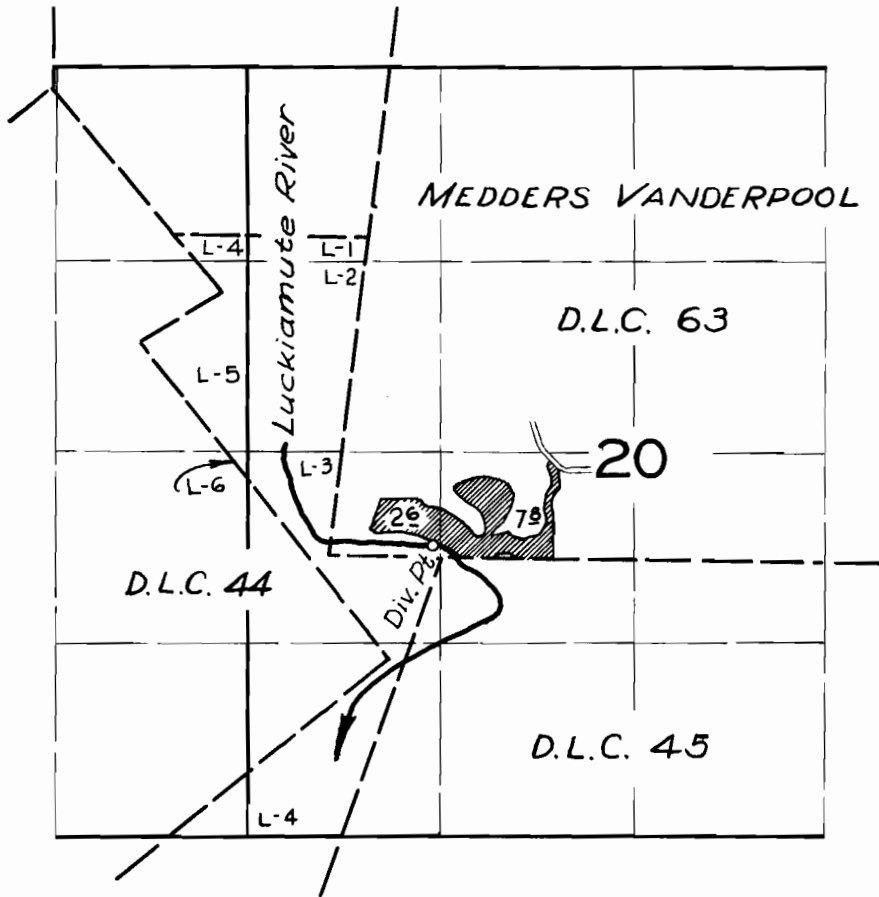

**FINAL PROOF SURVEY**  
UNDER

Application No. 26593... Permit No. 20830.  
IN NAME OF

*JOHN L. SPARKS*

Surveyed May 20 1958, by R.H. Whitby.