


T.4S.,R.12E.,W.M.

'PRIMARY RIGHTS'

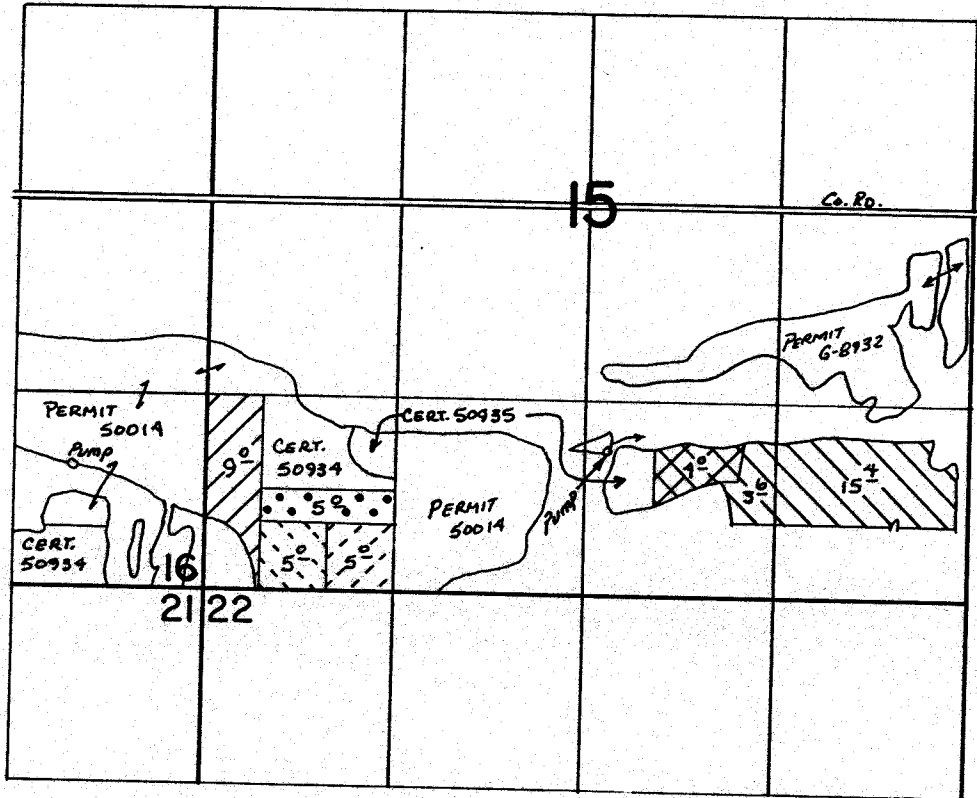

FINAL PROOF SURVEY

UNDER

Transfer No.

Application No. Permit No.

IN NAME OF

LEO E. JILK

Surveyed June 19... 1984, by L. Toll.....

4101

4103

4105

4106


4107

4108



T.4S., R.12E., W.M.

'SUPPLEMENTAL RIGHTS'

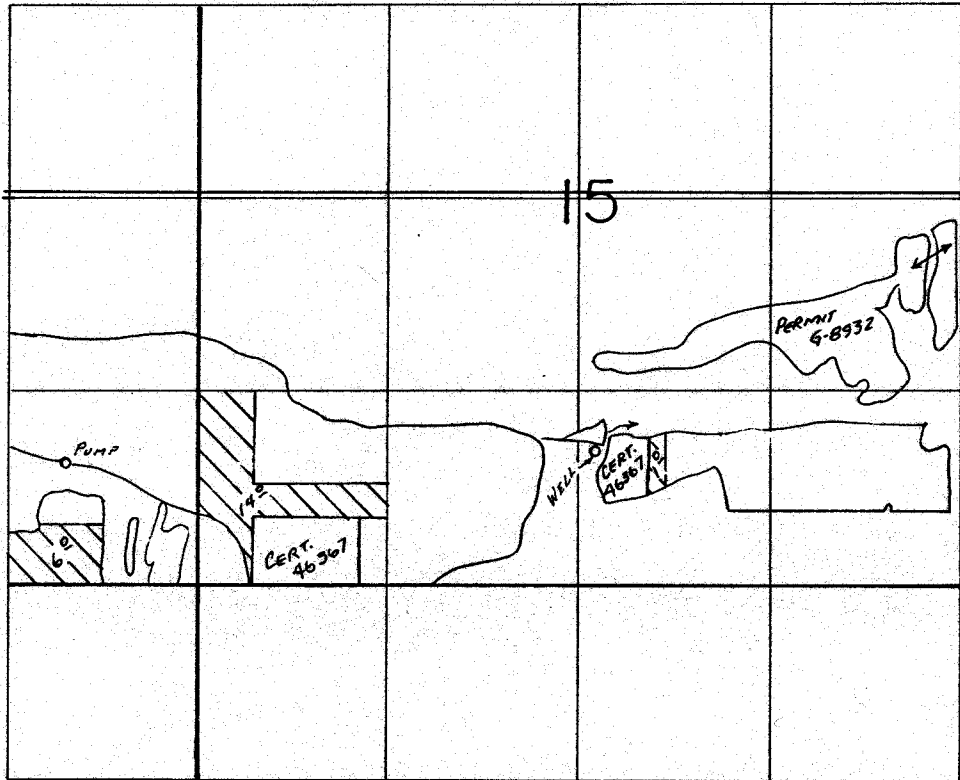

FINAL PROOF SURVEY

UNDER

Transfer No.

4101



Application No. Permit No.


IN NAME OF

..... LEO E. JILK

Surveyed June 19... 1984., by L. Toll.....

T.4S.,R.12E.,W.M.

'SUPPLEMENTAL RIGHT'

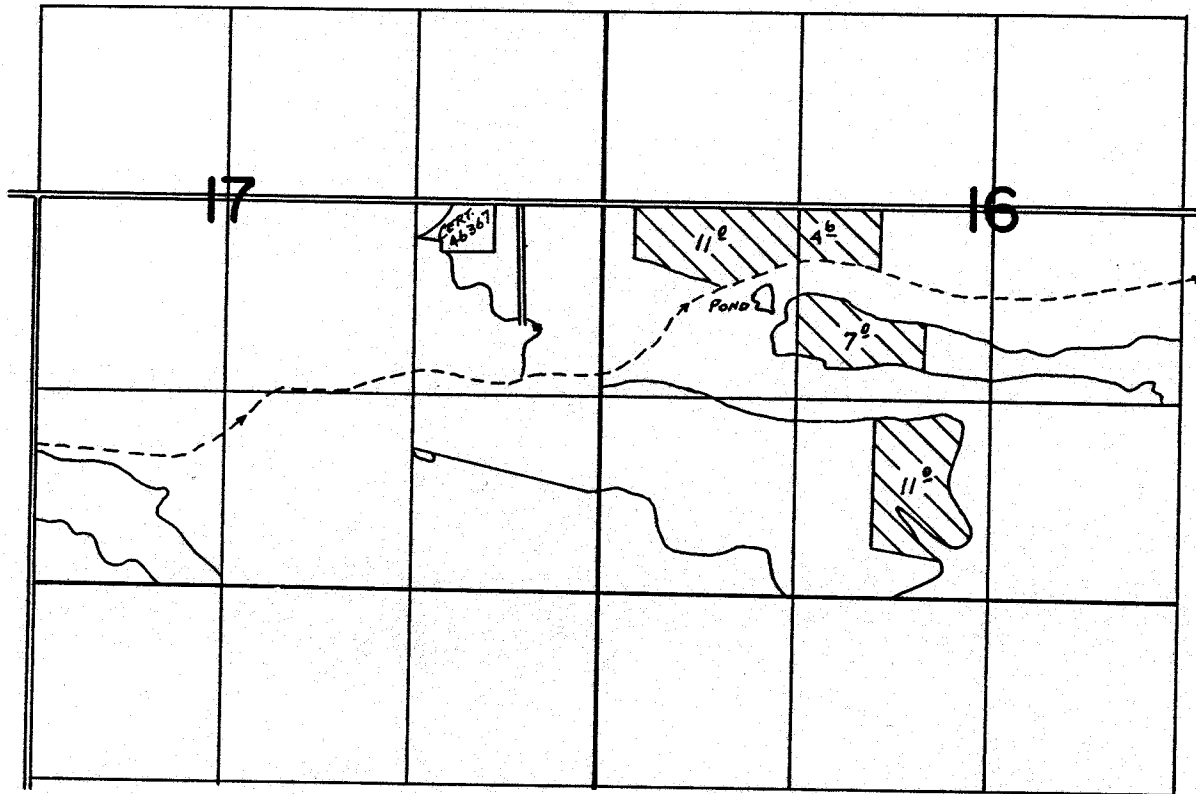

FINAL PROOF SURVEY

UNDER

Transfer No

4101



Application No. Permit No.

IN NAME OF

..... **PHYLLIS MIZNER**

Surveyed June 19, 1984, by J. Tall.....

June 7 1988 T. Warren