


T. 32 S., R. 1 E., W. M.

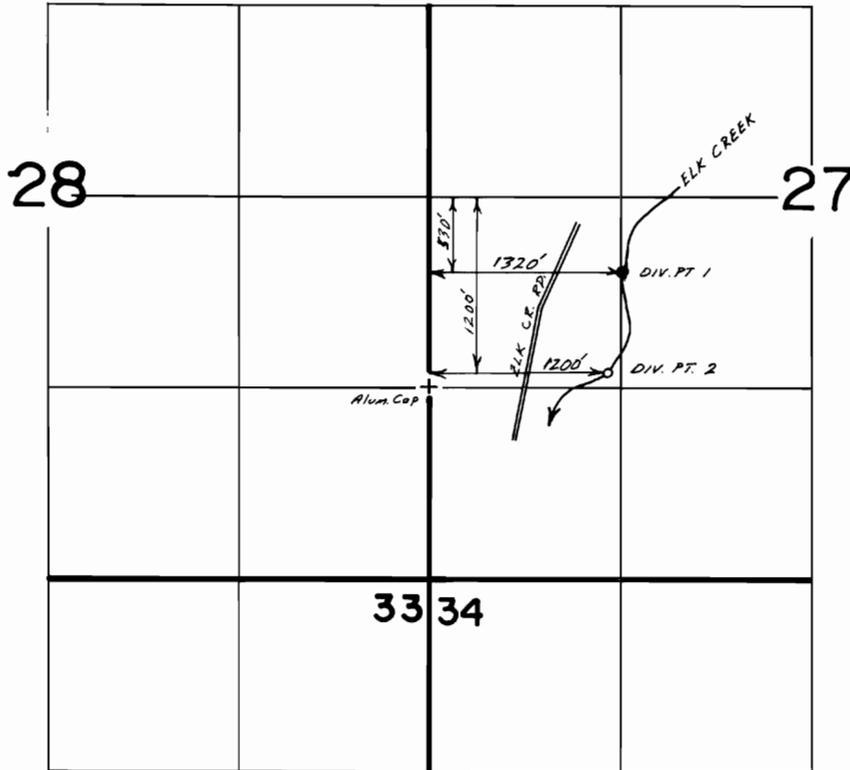

Scale: 1" = 1320'

FINAL PROOF SURVEY

UNDER

TRANSFER NO. 5373

Application No. Permit No.

IN NAME OF

H. L. & CAROLYN WEDBERG

Surveyed August 27, 1967, by B. S. JAMES