


T. 33 & 34 S., R. 1 W., W. M.

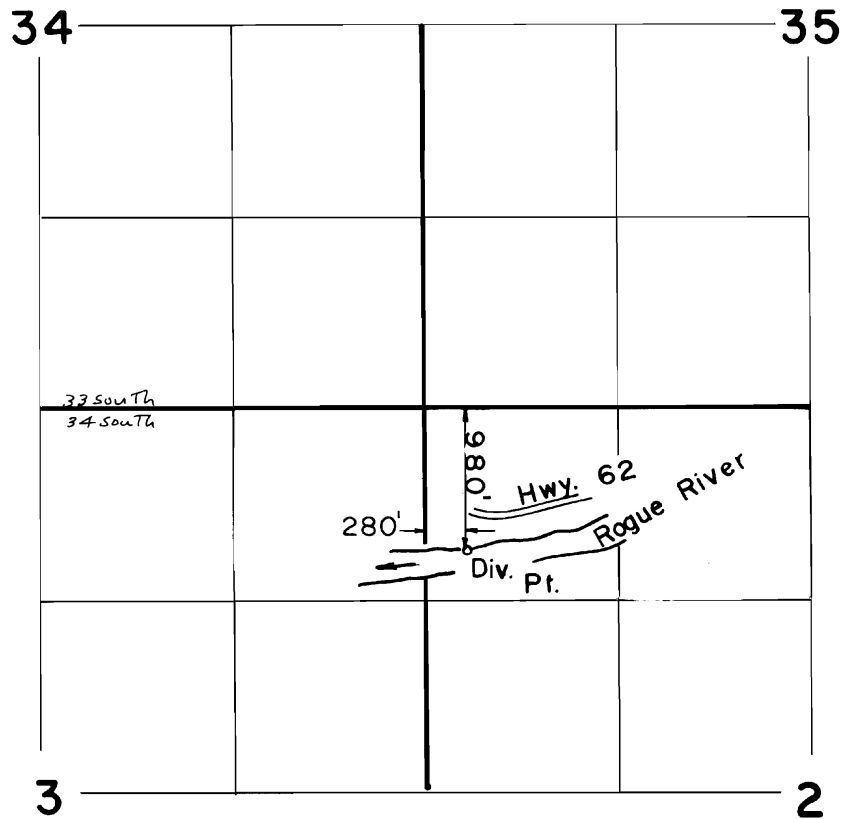

Scale: 1" = 1320'

**FINAL PROOF SURVEY**  
UNDER

TRANSFER NO. 5629

Application No. .... Permit No. ....  
IN NAME OF

JOSEPH F. & SHIRLEY J. SMITH

Surveyed JUN. 12. 19.86, by B. S. JAMES