


# T.36 S.R.2 W.W.M.

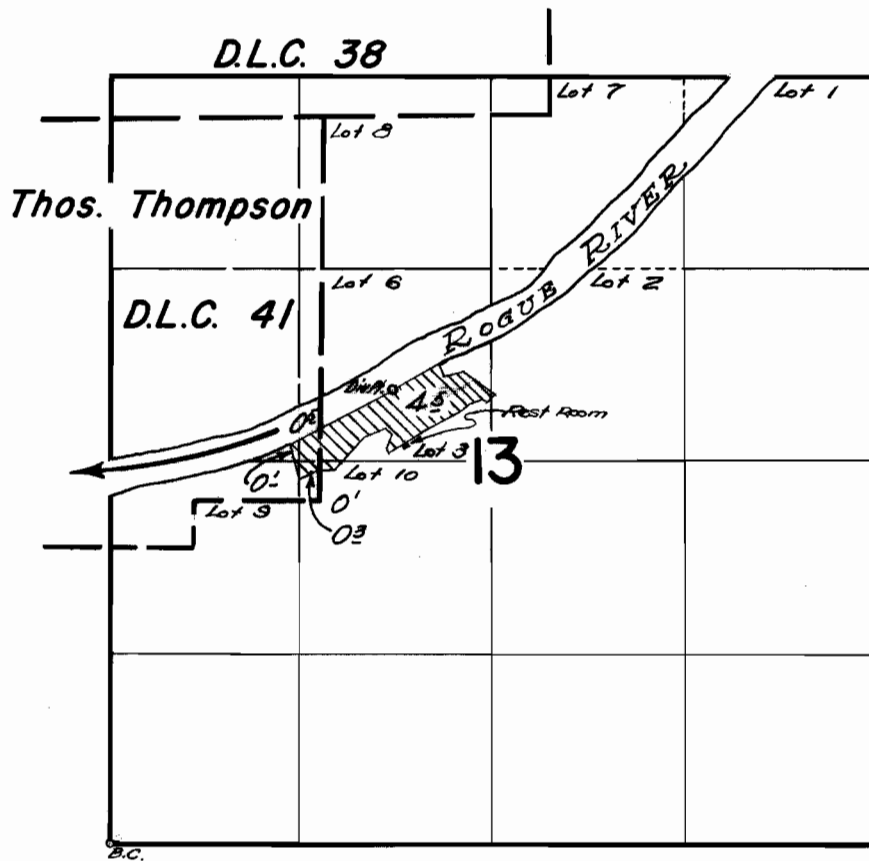

## FINAL PROOF SURVEY UNDER

Application No. 29100 Permit No. 22876  
IN NAME OF

OREGON STATE HIGHWAY COMMISSION

Surveyed June 10 1963, by C. R. Baker.