


T.17&18S.R.46E.W.M.

- PRIMARY IRRIGATION - MALHEUR RIVER
- PERMIT No. 30621
- PERMIT No. 33946
- PRIMARY IRRIGATION - SNAKE RIVER
- PERMIT No. 31231
- PERMIT No. 33944
- SUPPLEMENTAL IRRIGATION - SNAKE RIVER
- PERMIT No. 33945

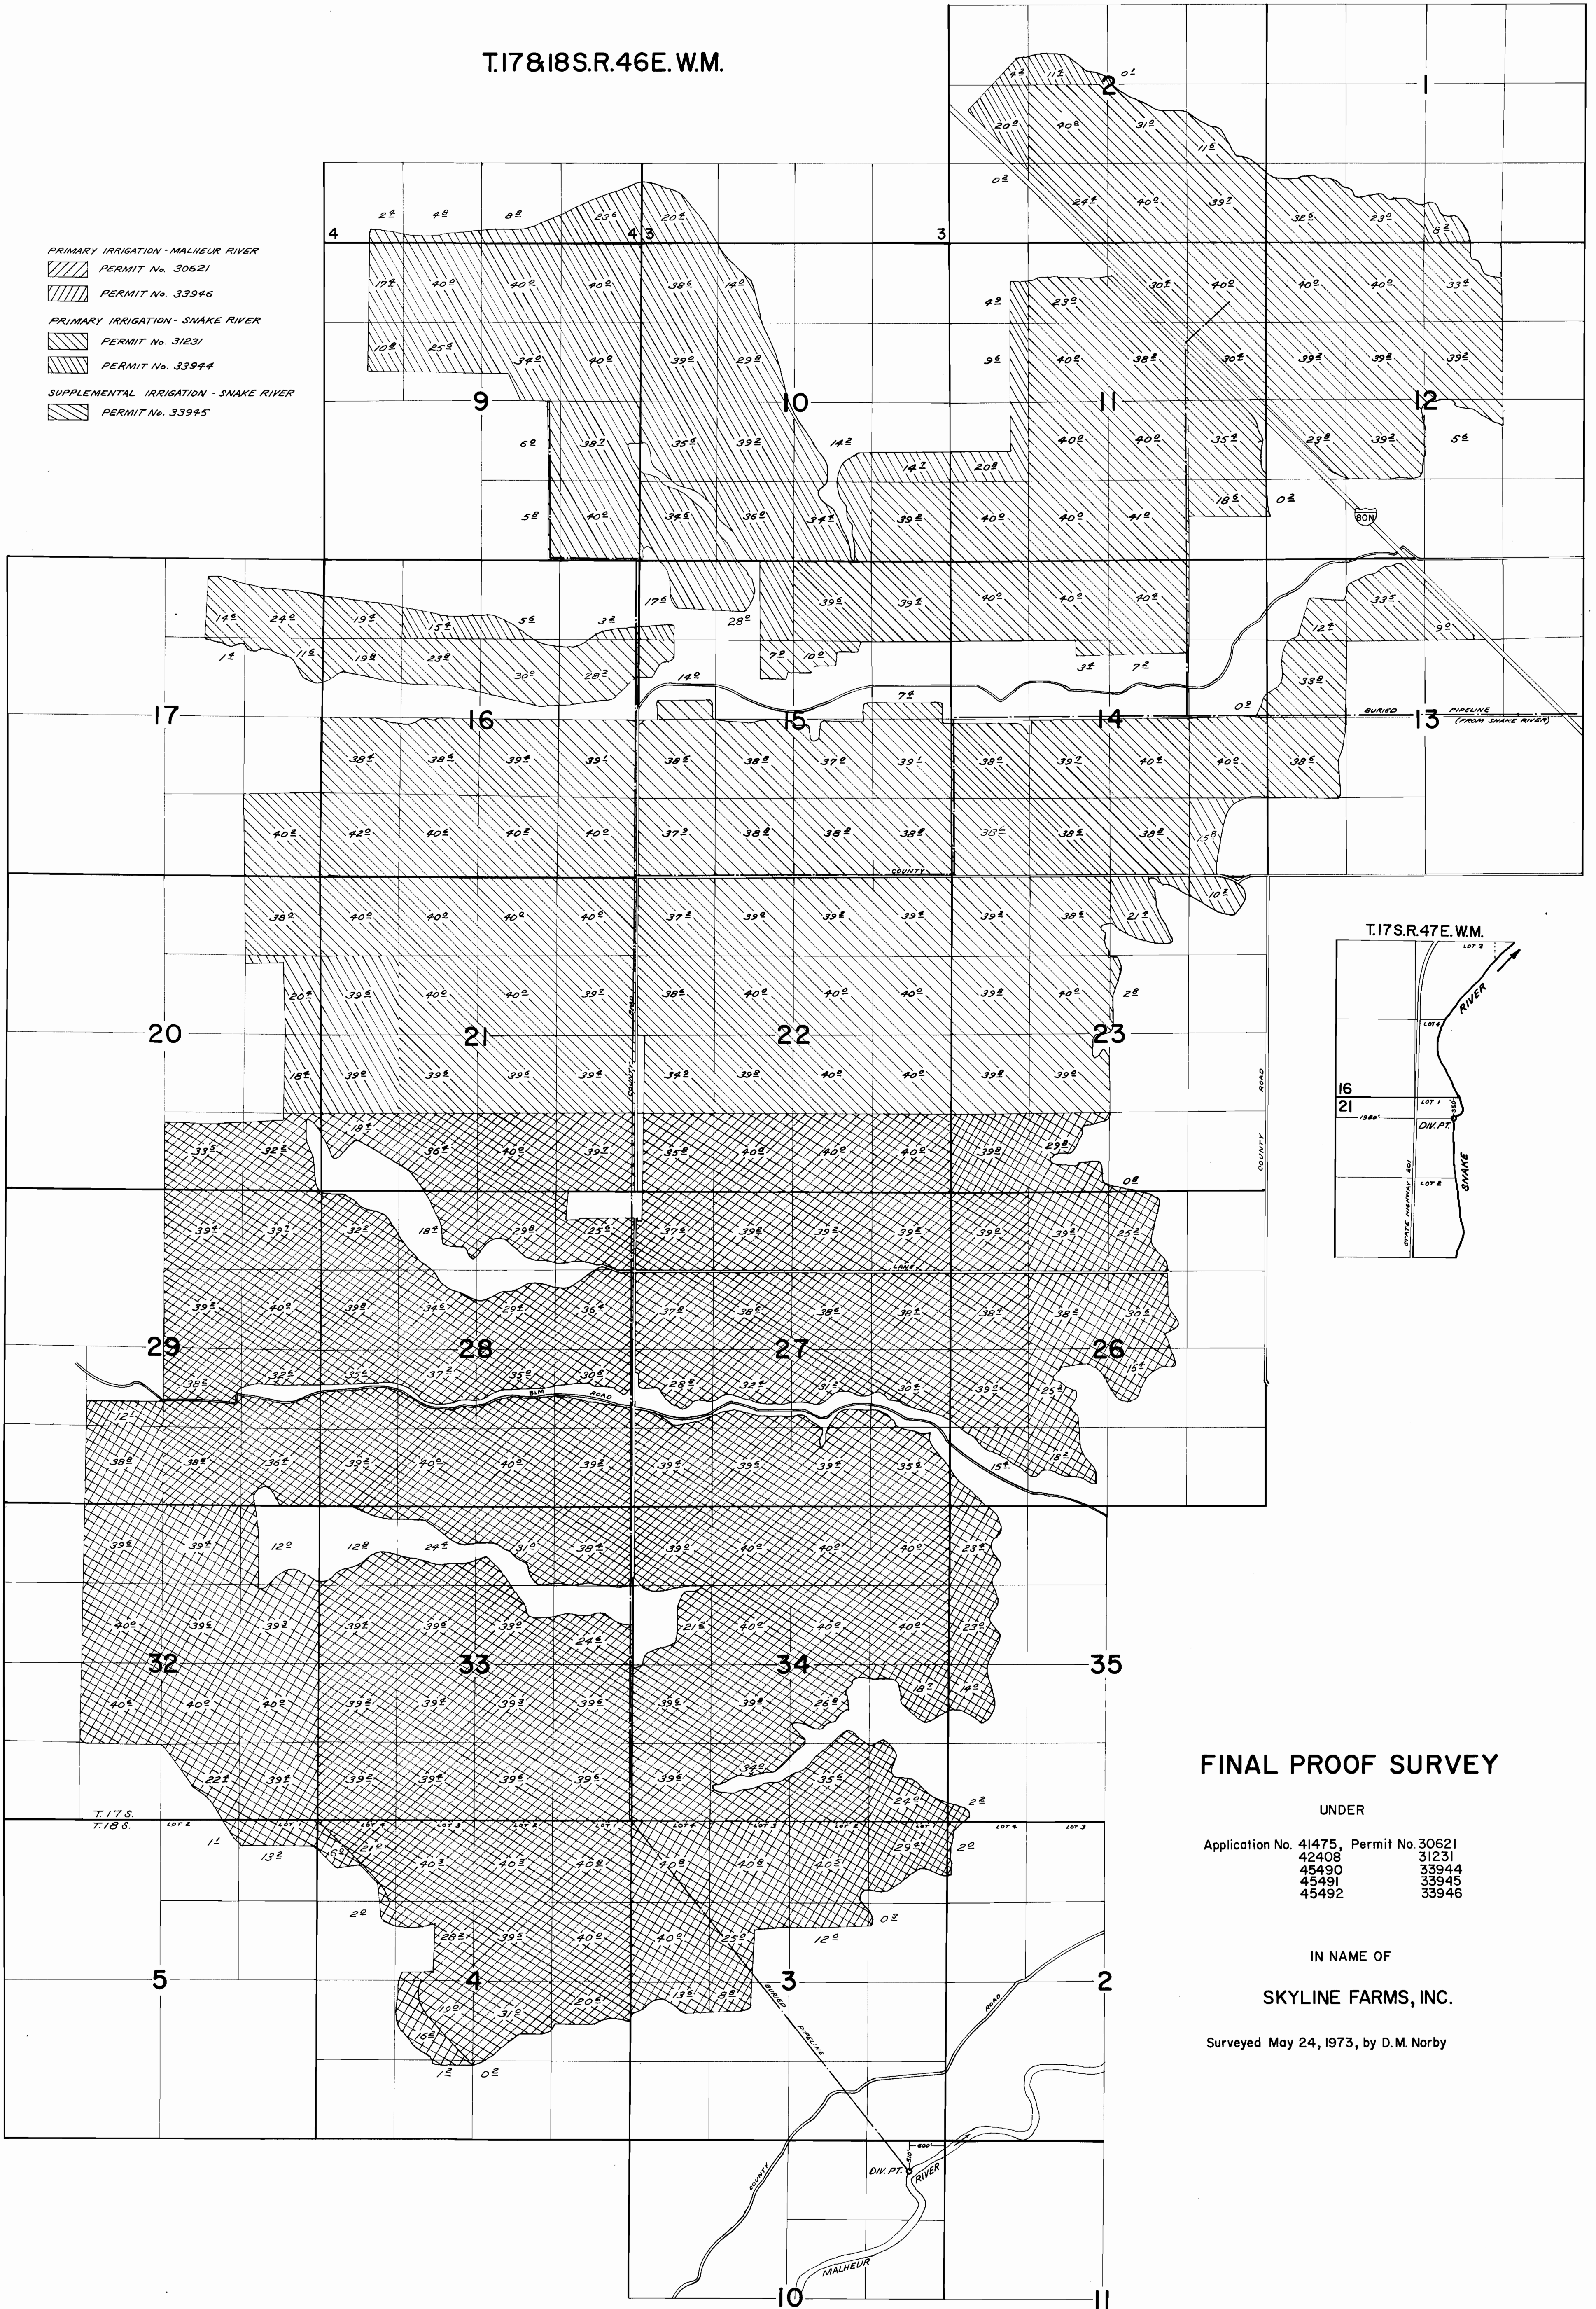

FINAL PROOF SURVEY

UNDER

Application No. 41475, Permit No. 30621
 42408 31231
 45490 33944
 45491 33945
 45492 33946

IN NAME OF

SKYLINE FARMS, INC.

Surveyed May 24, 1973, by D.M. Norby