


T.4S.,R.12E.,W.M.

'PRIMARY RIGHTS'

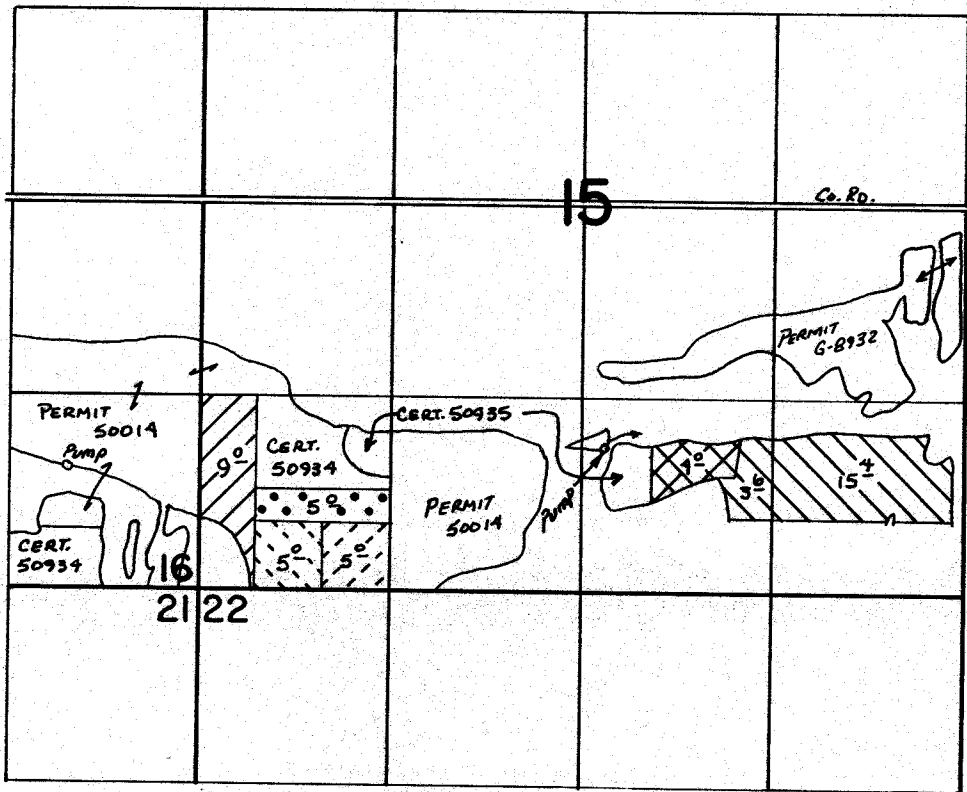

FINAL PROOF SURVEY

UNDER

Transfer No.

Application No. Permit No.

IN NAME OF

LEO E. JILK

Surveyed June...19... 1984., by ...L...Toll.....

4101

4103

4105

4106


4107

4108



T.4S.,R.12E.,W.M.

'PRIMARY RIGHT'

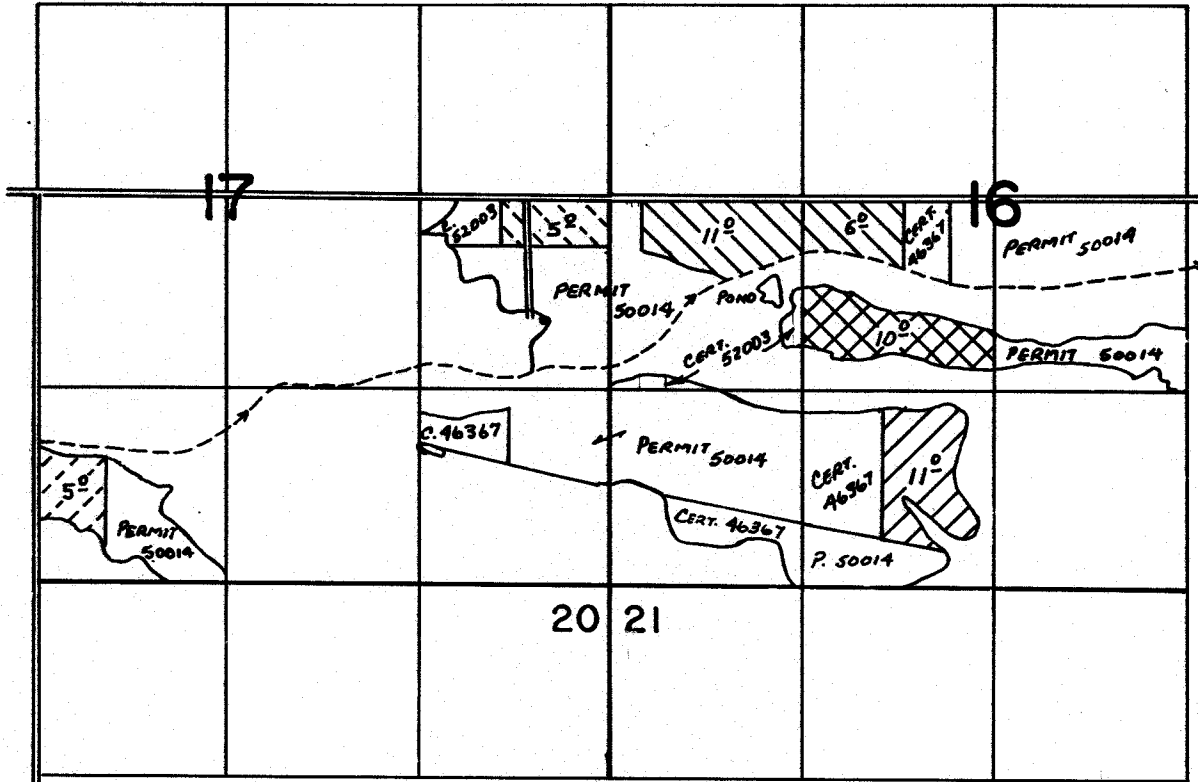

FINAL PROOF SURVEY

UNDER

Transfer No.

Application No. Permit No.
IN NAME OF

..... **PHYLLIS MIZNER**

Surveyed June 19 1984, by L. Toll.....
June 7 1988 T. Warren

4103

4106

4108

4947

4948

