


T.4S.,R.12E.,W.M.

'PRIMARY RIGHTS'

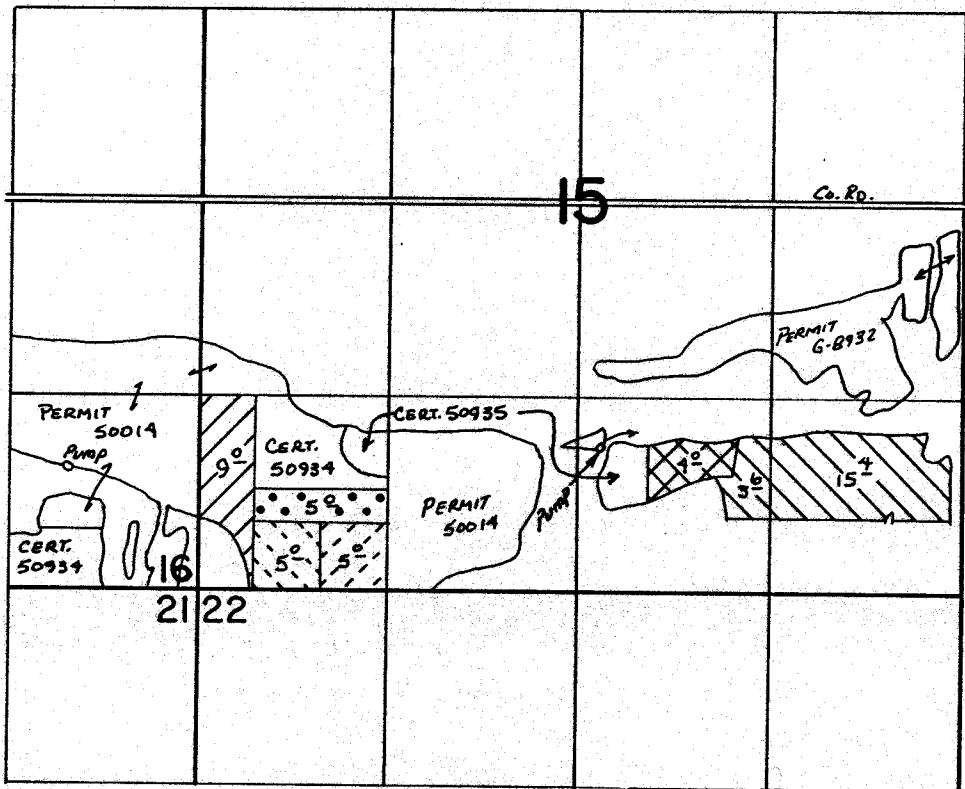

FINAL PROOF SURVEY

UNDER

Transfer No.

Application No. Permit No.

IN NAME OF

LEO E. JILK

Surveyed June..19... 19.84., by ..L...Toll.....

- 4101
- 4103
- 4105
- 4106
- 4107
- 4108

