


T.4S.,R.12E.,W.M.

'PRIMARY RIGHTS'

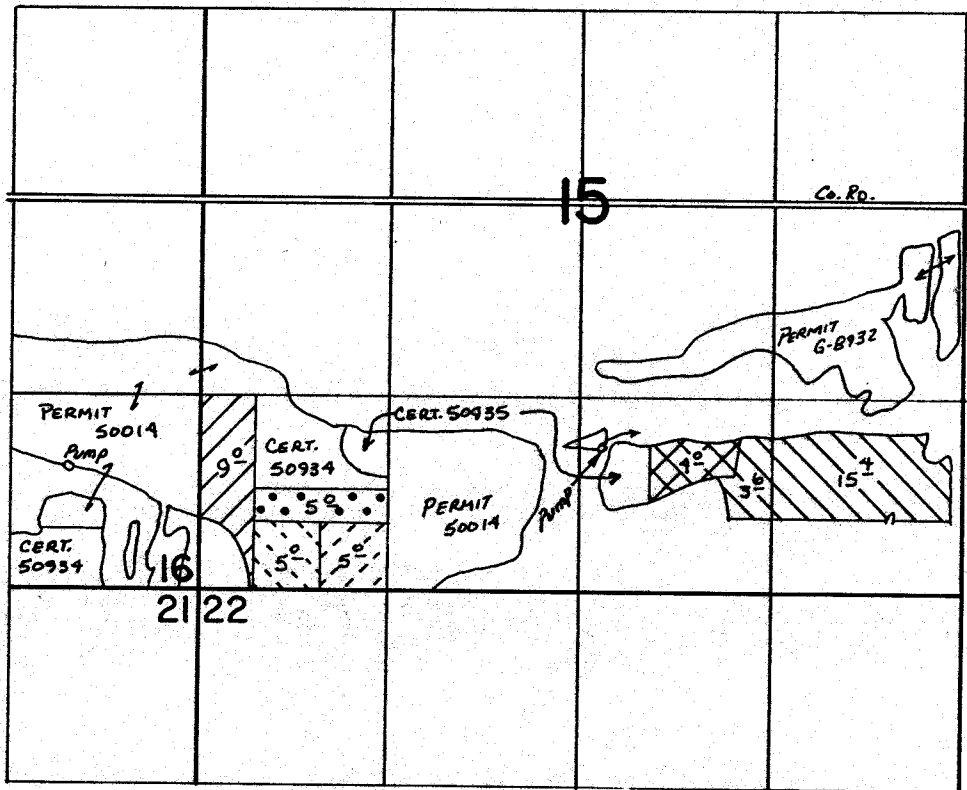

FINAL PROOF SURVEY

UNDER

Transfer No.

Application No. Permit No.

IN NAME OF

LEO E. JILK

4101

4103

4105

4106

4107


4108



Surveyed June...19... 19.84., by ..L...Toll.....

T.4S.,R.12E.,W.M.

'PRIMARY RIGHT'

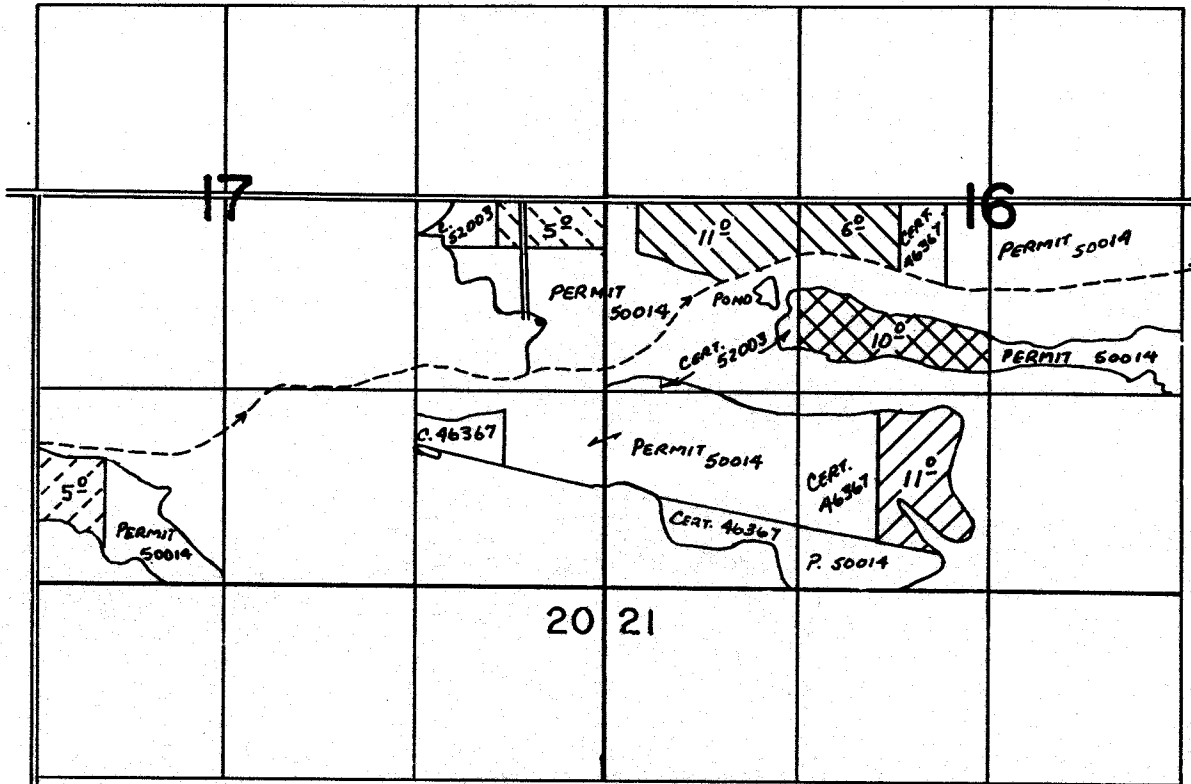

FINAL PROOF SURVEY

UNDER

Transfer No.

4103

4106

4108

4947

4948



Application No. Permit No.

IN NAME OF

PHYLLIS MIZNER

Surveyed June 19 1984, by L. Tall

June 7 1988 T. Warren