


T.4S.,R.12E.,W.M.

'PRIMARY RIGHTS'

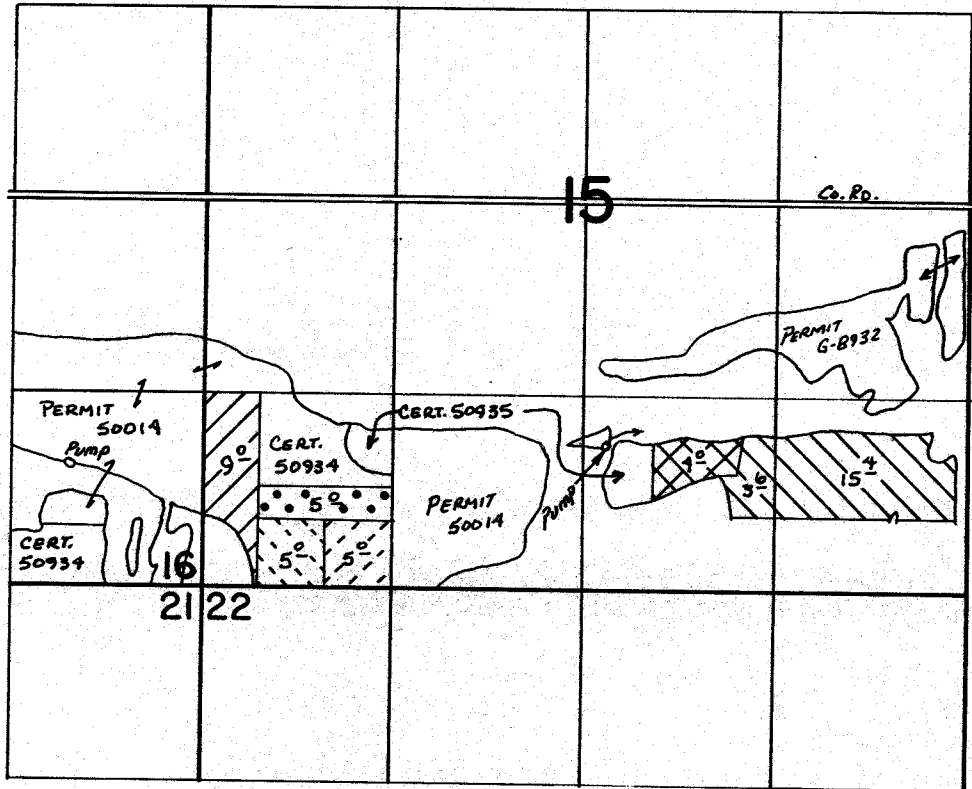

FINAL PROOF SURVEY

UNDER

Transfer No.

Application No. Permit No.

IN NAME OF

LEO E. JILK

Surveyed June...19... 1984., by ...L...Toll.....

4101

4103

4105

4106

4107

4108

