


T.4S.,R.12E.,W.M.

'PRIMARY RIGHT'

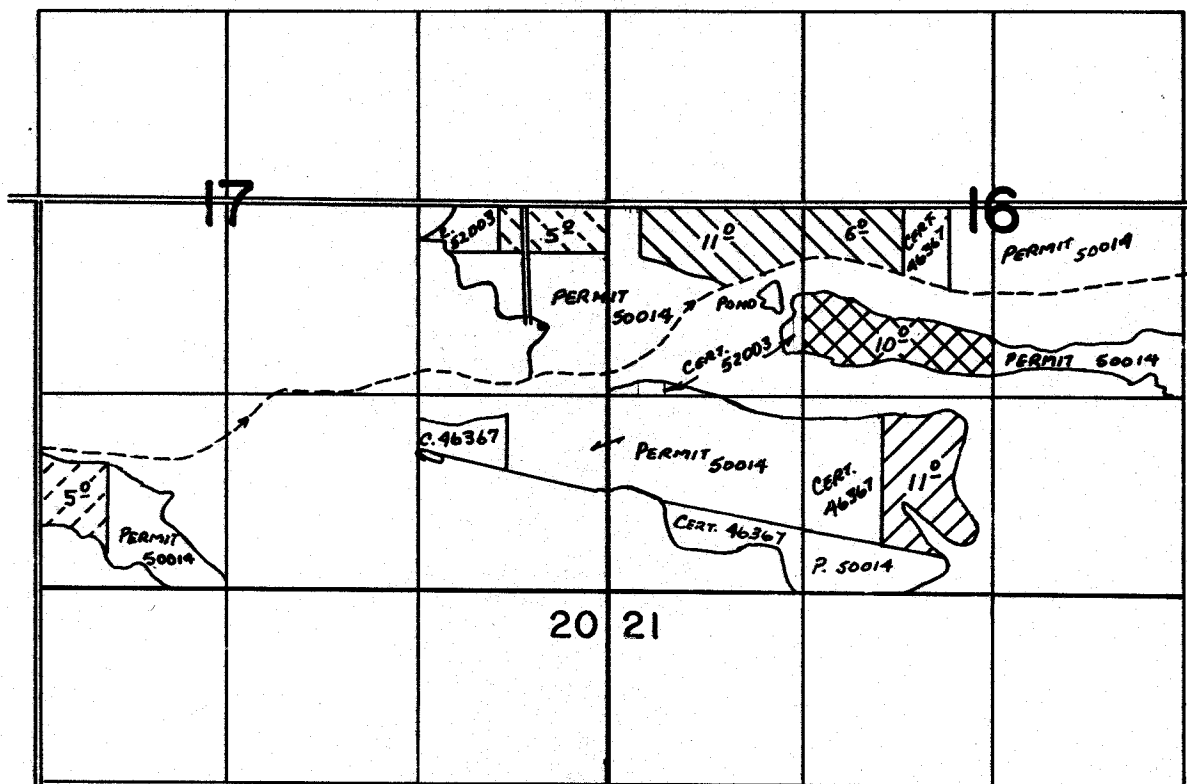

**FINAL PROOF SURVEY**

UNDER

Transfer No.

Application No. .... Permit No. ....  
IN NAME OF

..... **PHYLLIS MIZNER** .....

Surveyed June 19 1984, by L. Toll.....  
June 7 1988 T. Warren

- 4103
- 4106
- 4108
- 4947
- 4948

